

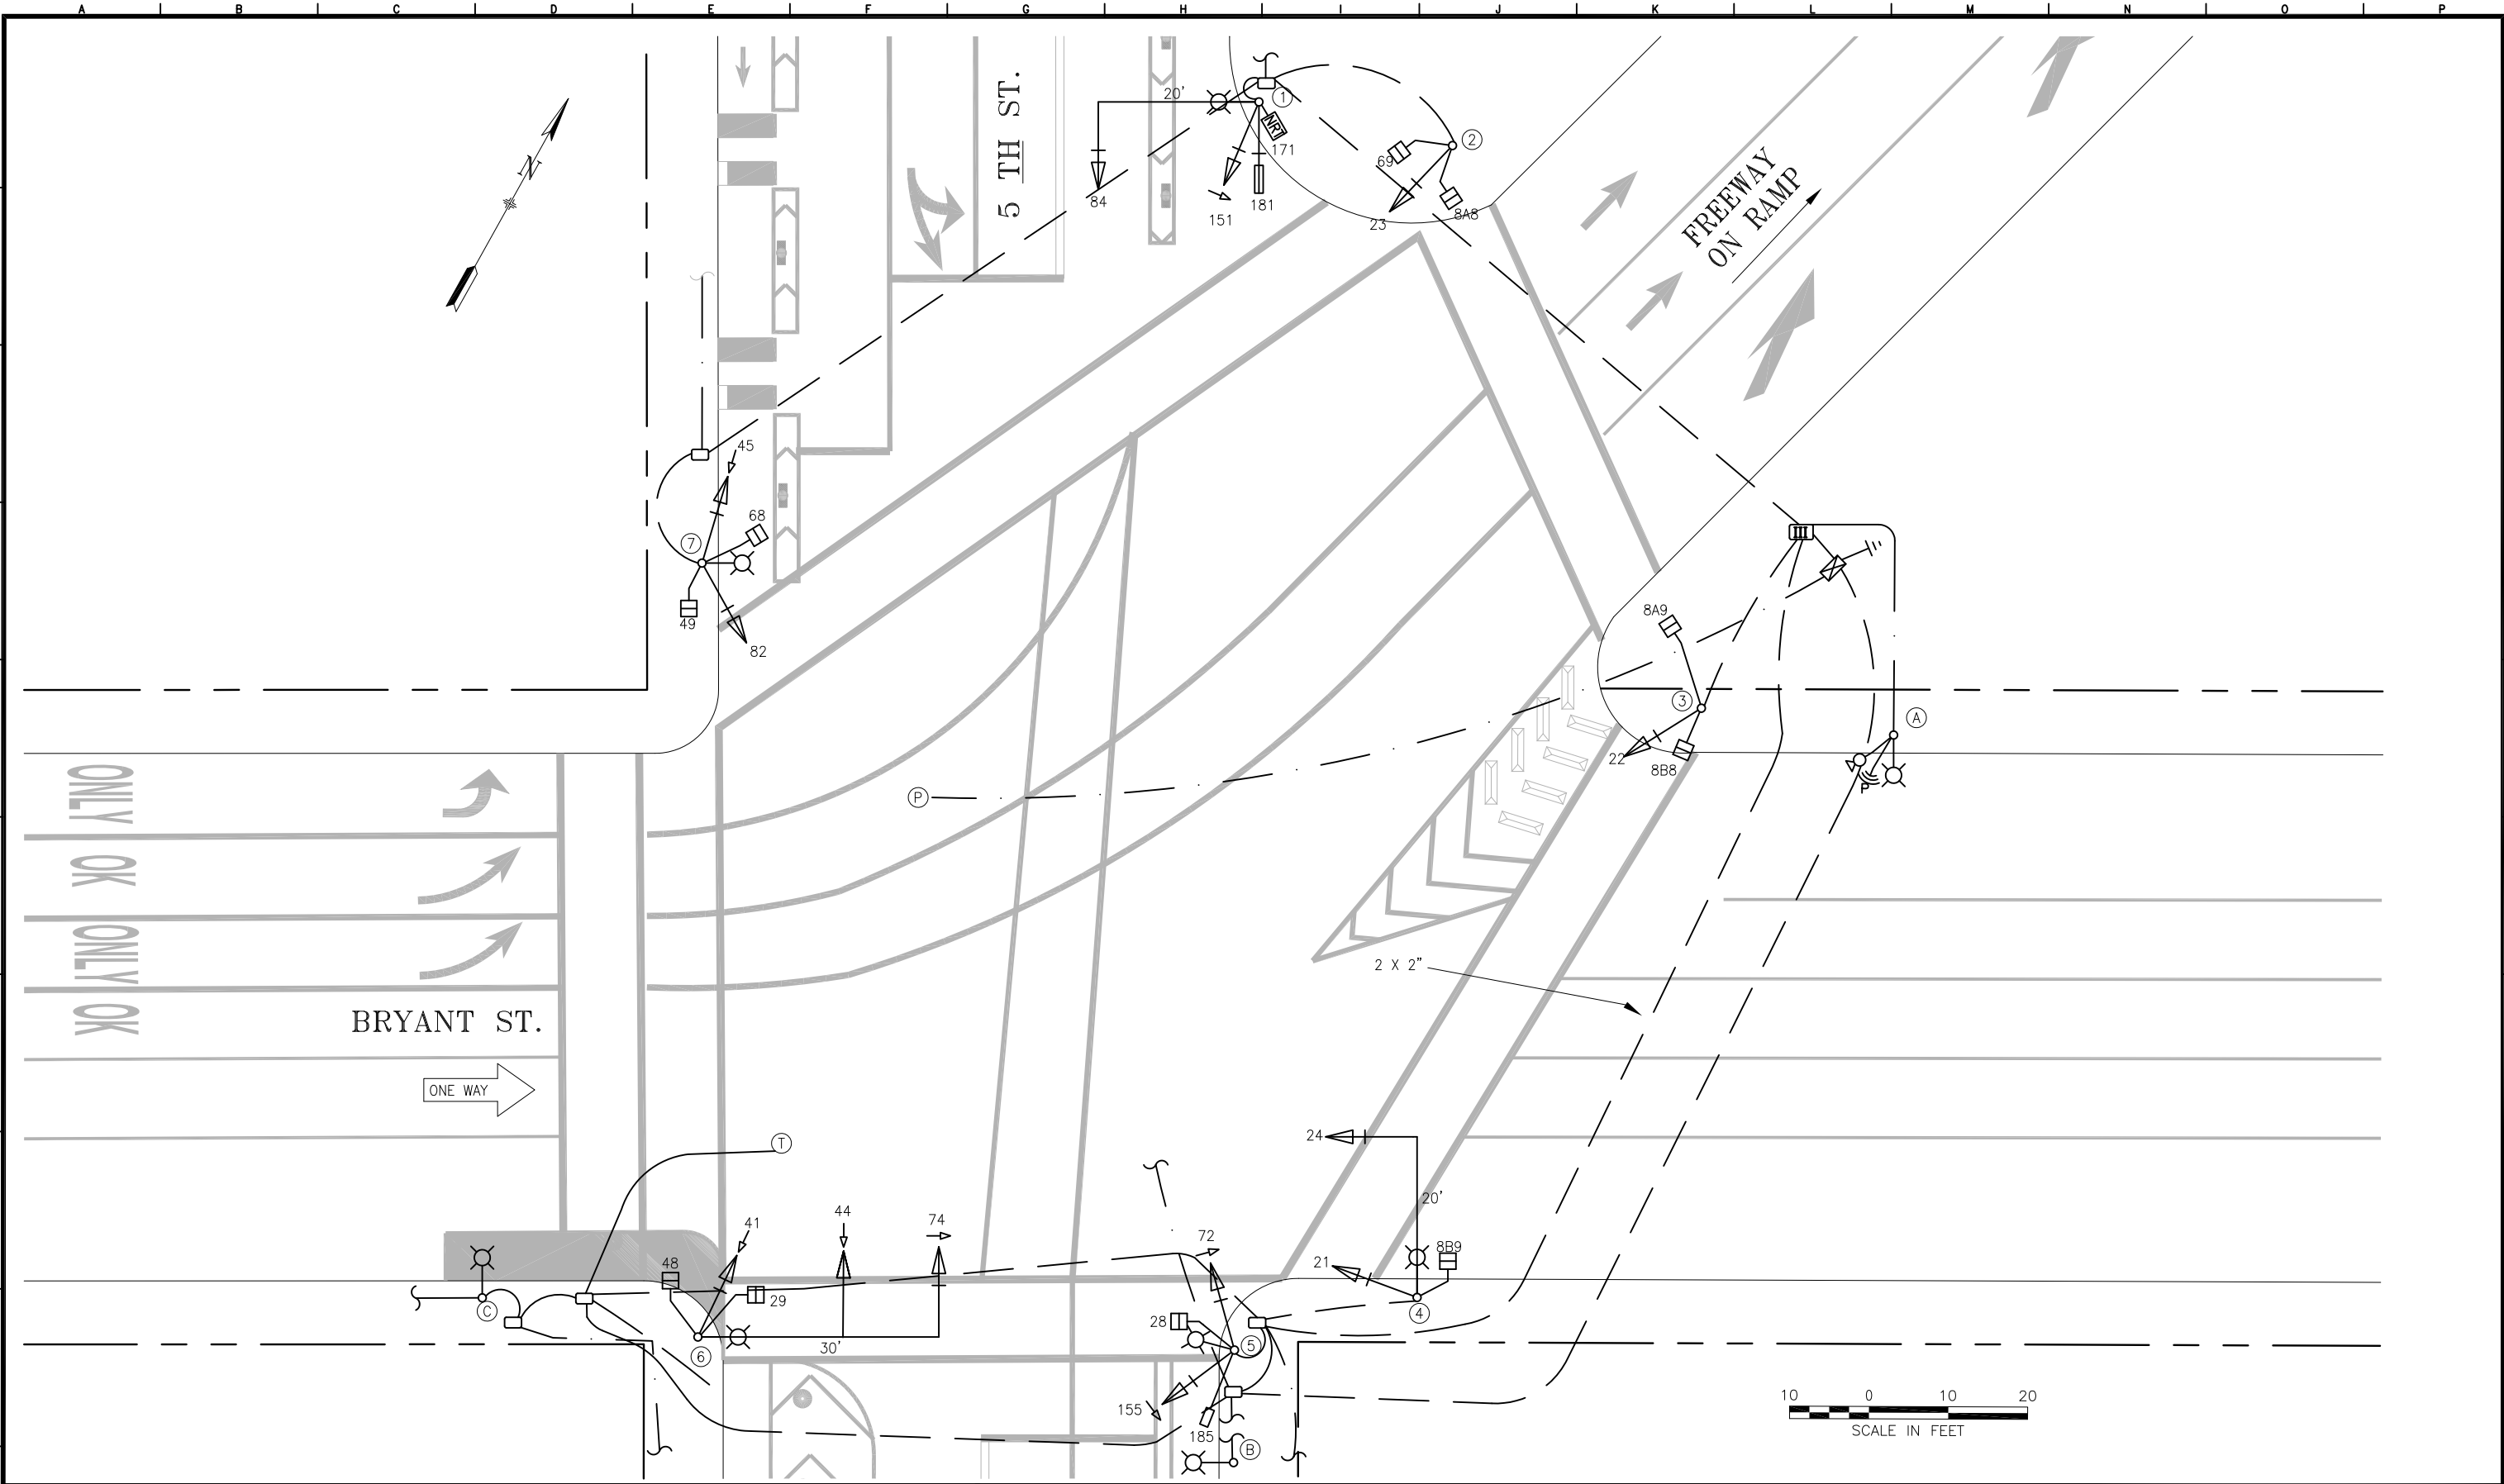


TABLE OF REVISIONS			
NO.	DATE	DESCRIPTION	
1	10/07/22	SRC 2022-080: REPLACE 82 AND 84 WITH RYG BALL	J.CHIMENTO
2	07/20	SRC 2019-117& SRC 2020-201: ADD BIKE PHASE	J.CHIMENTO
3	08/01	CAD DRAWING UPDATED	TL
4	09/97	BRYANT STREET SIGNAL MODIFICATION CONTRACT NO.7430E	JY
		DESCRIPTION	BY
			APPROVED



SFMTA

DRAWN BY:	DATE:
TL	08/15/01
CHECKED BY:	DATE:

SCALE
AS SHOWN
SHEET OF SHEETS
1 OF 2

TRAFFIC SIGNAL INVENTORY DIAGRAM
5TH ST AND BRYANT ST

CNN NO:
23889000
REV NO:
4

	A	B	C	D	E	F	G	H	I	J	K	L	M	N	O	P
1																
2																
3																
4																
5																
6																
7																
8																
9																

POLE AND EQUIPMENT SCHEDULE										
POLE No.	TYPE OF POLE	VEHICLE SIGNAL					PEDESTRIAN SIGNAL			REMARKS
		No.	TYPE	MOUNTING	VISORS	LOUVERS	No.	TYPE	MOUNTING	
①	17B-1-70 WITH 20' MAST ARM	171 84 151 181	NRT 3S12" 3S12"RA 3S12"BIKE	MAS SV-1 SV-1						BP BP BP
②	1-A (10')	23	3S12"	TV-1-T		L	69 8A8	1S-COUNT 1S-COUNT	SP-1 SP-1	BP
③	1-A (10')	22	3S12"	TV-1-T			8A9 8B8	1S-COUNT 1S-COUNT	SP-2-T	BP
④	17B-1-70 WITH 20' MAST ARM	24 21	3S12" 3S12"	MAS SV-1-T			8B9	1S-COUNT	SP-1	BP BP
⑤	SL	72 155 185	3S12"LA 3S12"RA 3S8"BIKE	SV-2-T SV-1			28	1S-COUNT	SP-1	BP BP 185 MOUNTED @ 8'
⑥	19-3-70 WITH 30' MAST ARM	74 44 41	3S12"LA 3S12"GVA 3S12"GVA	MAS MAS SV-1-T			29 48	1S-COUNT 1S-COUNT	SP-2-T	BP BP
⑦	SL	45 82	3S12" 3S12"	SV-2-TA			49 68	1S-COUNT 1S-COUNT	SP-2-T	BP BP
Ⓐ	SL									PREEMPTION RADIO VIDEO CAMERA
Ⓑ	SL									
Ⓒ	SL									

NOTE: ALL SIGNAL HEADS INSTALLED WITH BACKPLATES PER CALTRANS
CONTROLLER FOUNDATION TYPE: 'M' TYPE

Δ	10/07/22	SRC 2022-080: REPLACE 82 AND 84 WITH RYG BALL	J.CHIMENTO	G.HO												
Δ	07/20	SRC 2019-117& SRC 2020-201: ADD BIKE PHASE	J.CHIMENTO	G.HO												
Δ	08/01	CAD DRAWING UPDATED	TL	R.OLEA												
Δ	09/97	BRYANT STREET SIGNAL MODIFICATION CONTRACT NO.7430E	JY	TS												
NO.	DATE	DESCRIPTION	BY	APPROVED												
TABLE OF REVISIONS CHECKOUT DRAWING THROUGH THE SID CUSTODIAN FOR THE LATEST REVISION																
								DRAWN BY:	DATE:		SCALE	TRAFFIC SIGNAL INVENTORY DIAGRAM				CNN NO:
								TL	08/15/01		1" = 20'					23889000
								CHECKED BY:	DATE:		SHEET OF SHEETS	5TH ST AND BRYANT ST				REV NO:
											2 OF 2					3