


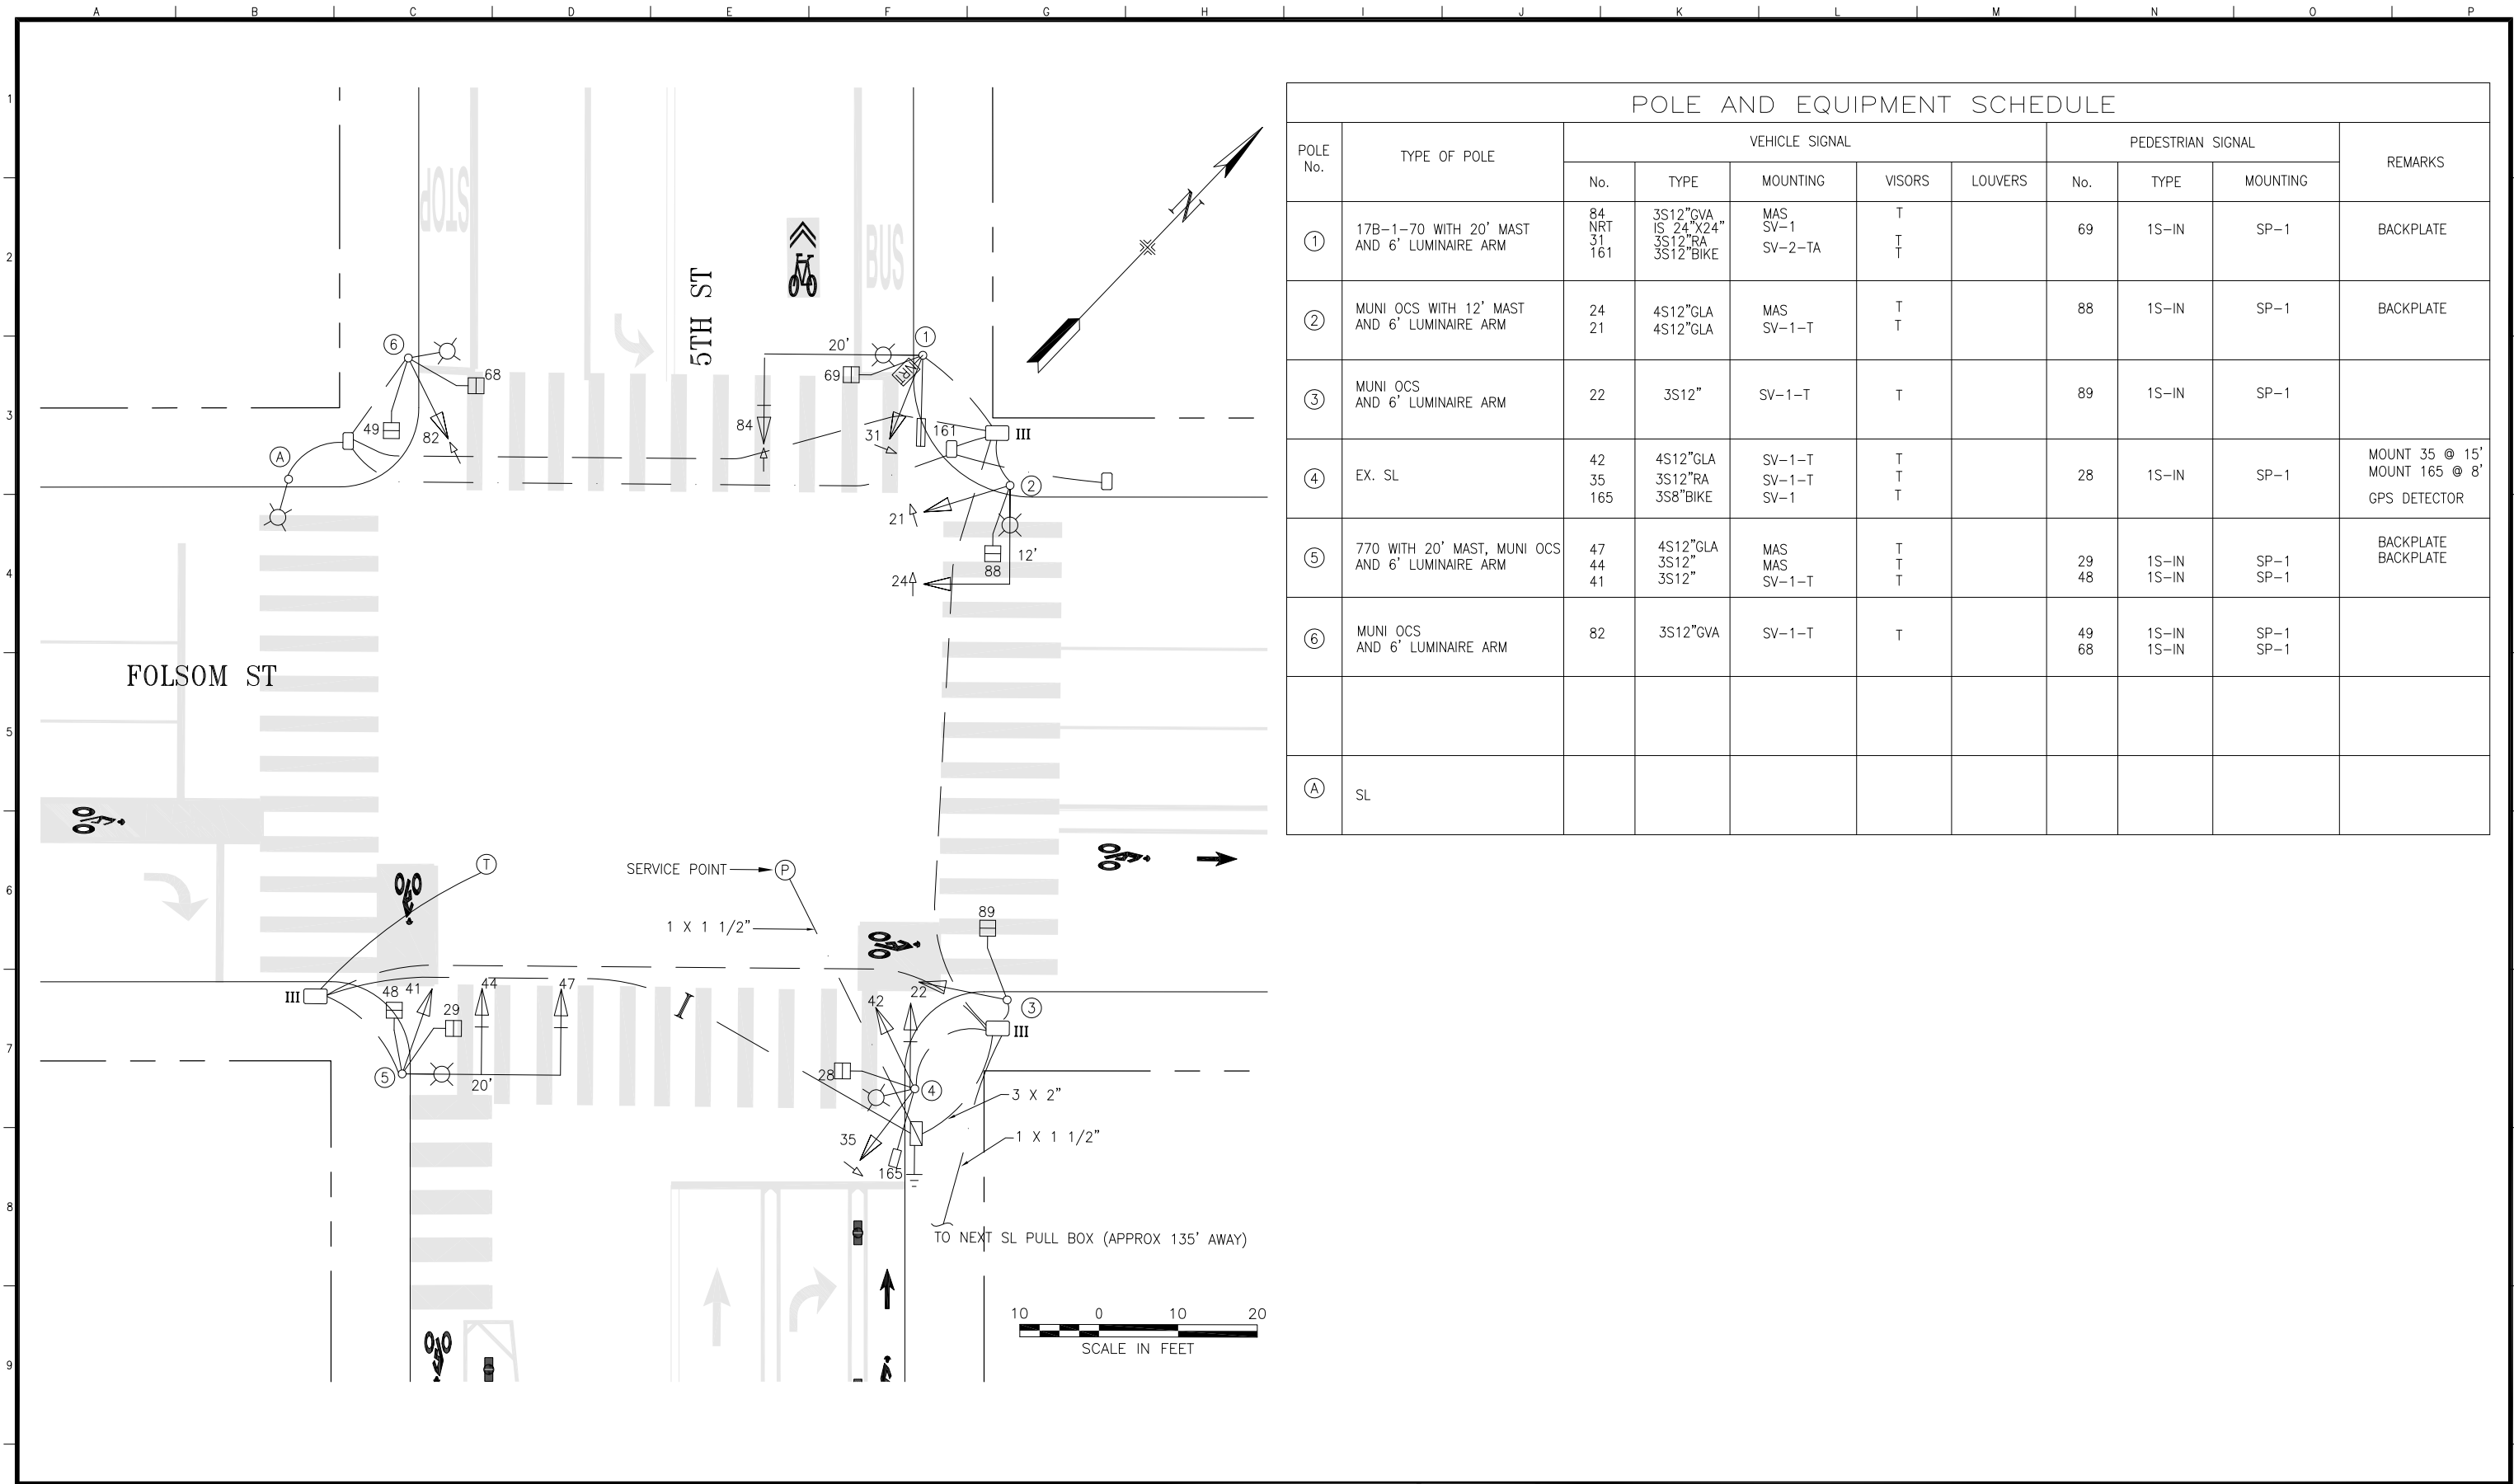

4	11/19	PER SRC 2019-402, CONVERTED 82/84 TO 3S12"GVA	AU	MS	
3	11/19	PER SRC 2019-380, ADDED 4S"12LA, PHASE 3/16	JHC	GH	
2	10/19	UPDATE SID PER FIELD CONDITIONS	JHC	GH	
1	02/99	FOLSOM STREET SIGNAL IMPROVEMENT CT#1302N	DVC	RO	
NO.	DATE	DESCRIPTION	BY	APP.	
TABLE OF REVISIONS CHECK WITH TRACING TO SEE IF YOU HAVE LATEST REVISION					

REFERENCE INFORMATION & FILE NO. OF SURVEYS
--



SAN FRANCISCO MUNICIPAL TRANSPORTATION AGENCY

CITY AND COUNTY OF SAN FRANCISCO

DRAWN:	DATE:
DVC	05/01/01
CHECKED:	DATE:
R.OLEA	09/10/01

--

SCALE:
AS SHOWN
SHEET OF SHEETS
1 OF 1

TRAFFIC SIGNAL INVENTORY DIAGRAM
5TH ST AND FOLSOM ST

CNN NO.
23937000
REV NO.
4