

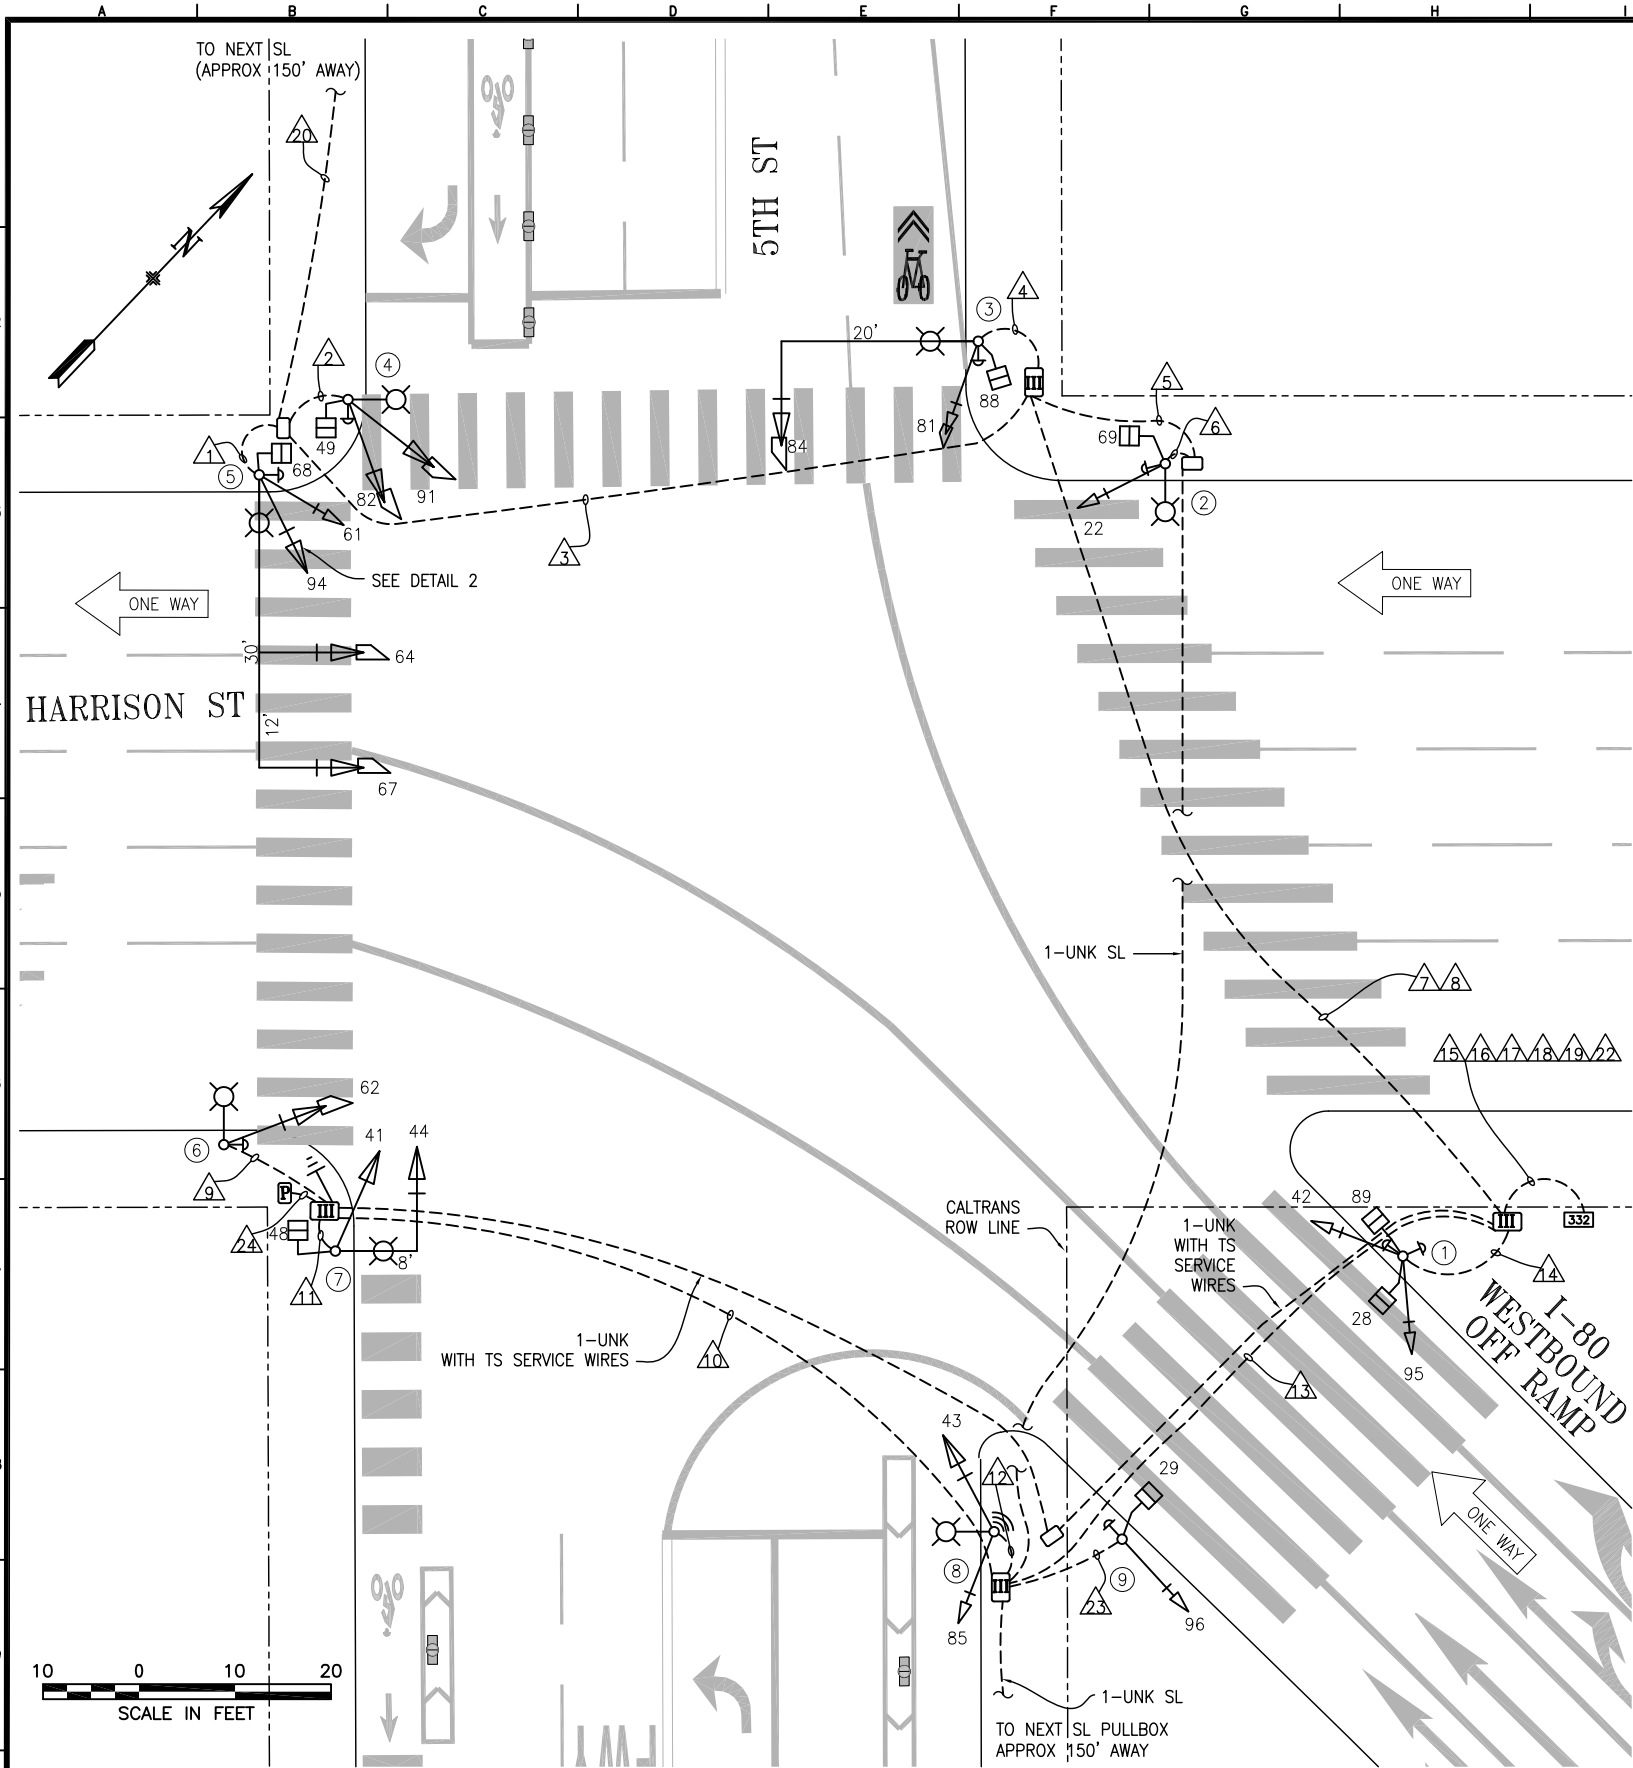


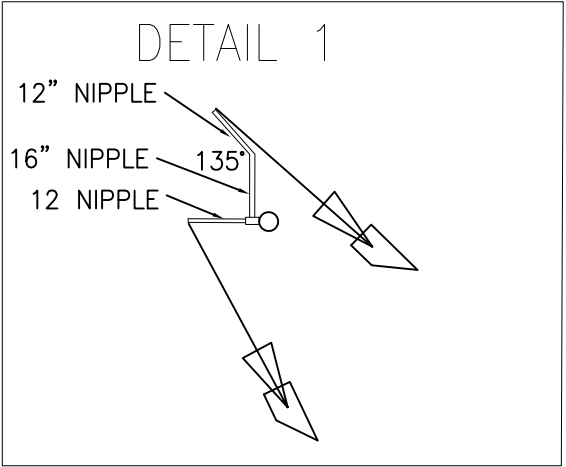

POLE AND EQUIPMENT SCHEDULE											
POLE No.	TYPE OF POLE	LUMINAIRE (HPS)	VEHICLE SIGNAL					PEDESTRIAN SIGNAL			REMARKS
		VOLTAGE/ WATTS	No.	TYPE	MOUNTING	VISORS	LOUVERS/ BP	No.	TYPE	MOUNTING	
①	1-A (10')		42 95	3S8" 3S8"	TV-2-T	T T	BP BP	89 28	1S-C 1S-C	SP-1 SP-1	APS-3W APS-3W
②	EX SL		22	3S8"	SV-1-T	T	BP	69	1S-C	SP-1	APS-3W
③	17B-1-70 W/ 20' MAST ARM AND 6' LUMINAIRE ARM.		81 84	3S8" 3S12"	SV-1-T MAS	LA LA(27")	BP BP	88	1S-C	SP-1	APS-3W
④	CITY STANDARD SL WITH 6' LUMINAIRE ARM.		82 91	3S12" 3S12"	SV-2-T (CUSTOM)	LA(27") LA		49	1S-C	SP-1	APS-3W
⑤	19-3-70 W/ 30' MAST ARM AND 6' LUMINAIRE ARM,		64 67 61 94	3S12" 3S12" 3S8" 3S12"	MAS MAS SV-2-T (CUSTOM)	RA RA T FC(18")	BP BP BP + VERT LOUVERS BP	68	1S-C	SP-1	APS-3W
⑥	CITY STANDARD SL WITH 6' LUMINAIRE ARM.		62	3S12"	SV-1-T	RA	BP				APS-3W
⑦	19-1-100 W/ 8' MAST ARM AND 6' LUMINAIRE ARM.		41 44	3S12" 3S12"	SV-1-T MAS	T T	BP	48	1S-C	SP-1	
⑧	CITY STANDARD SL WITH 6' LUMINAIRE ARM.		43 85	3S12" 3S8"	SV-2-TA	T T	BP BP				TSP & WIRELESS NETWORK EQUIPMENT
⑨	1-A(10')		96	3S8"	TV-1	T	BP	29	1S-C	SP-1	APS-3W

DETAIL NOTES

- Ⓐ SEE DETAIL 1
Ⓔ SEE DETAIL 2

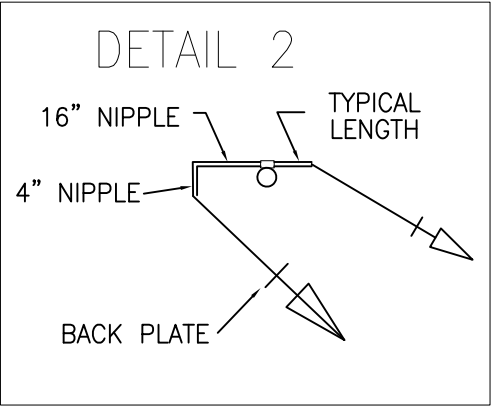

NO.	DATE	DESCRIPTION	BY	APPROVED
TABLE OF REVISIONS				
CHECKOUT DRAWING THROUGH THE SID CUSTODIAN FOR THE LATEST REVISION				
Δ	5/18/22	UPDATE PER FIELD - NOTE T/ANGLE VISORS. NEW HEADS ON POLE 4. POLE 5 MOUNTS	D. YEUNG	G. de LEON
Δ	4/5/22	INSTALL APS PER CALTRANS PROJECT 04-3J8904 & SRC 2021-342	D. YEUNG	G. de LEON
Δ	4/26/13	UPDATED BASED ON MUNI CONTRACT 1251 AS-BUILTS - NEW POLE 7	D. YEUNG	G. de LEON
Δ	9/27/99	CONVERTED FROM CONTRACT 1167N AS-BUILTS	D. YEUNG	G. de LEON



SFMTA

DRAWN BY: D. YEUNG	DATE: 5/2022
CHECKED BY: G. de LEON	DATE: 5/2022

SCALE AS SHOWN
SHEET OF SHEETS 1 OF 2

TRAFFIC SIGNAL INVENTORY DIAGRAM
5TH ST AND HARRISON AND I-80 OFF-RAMP

CNN NO: 23908000
REV NO: 3

