


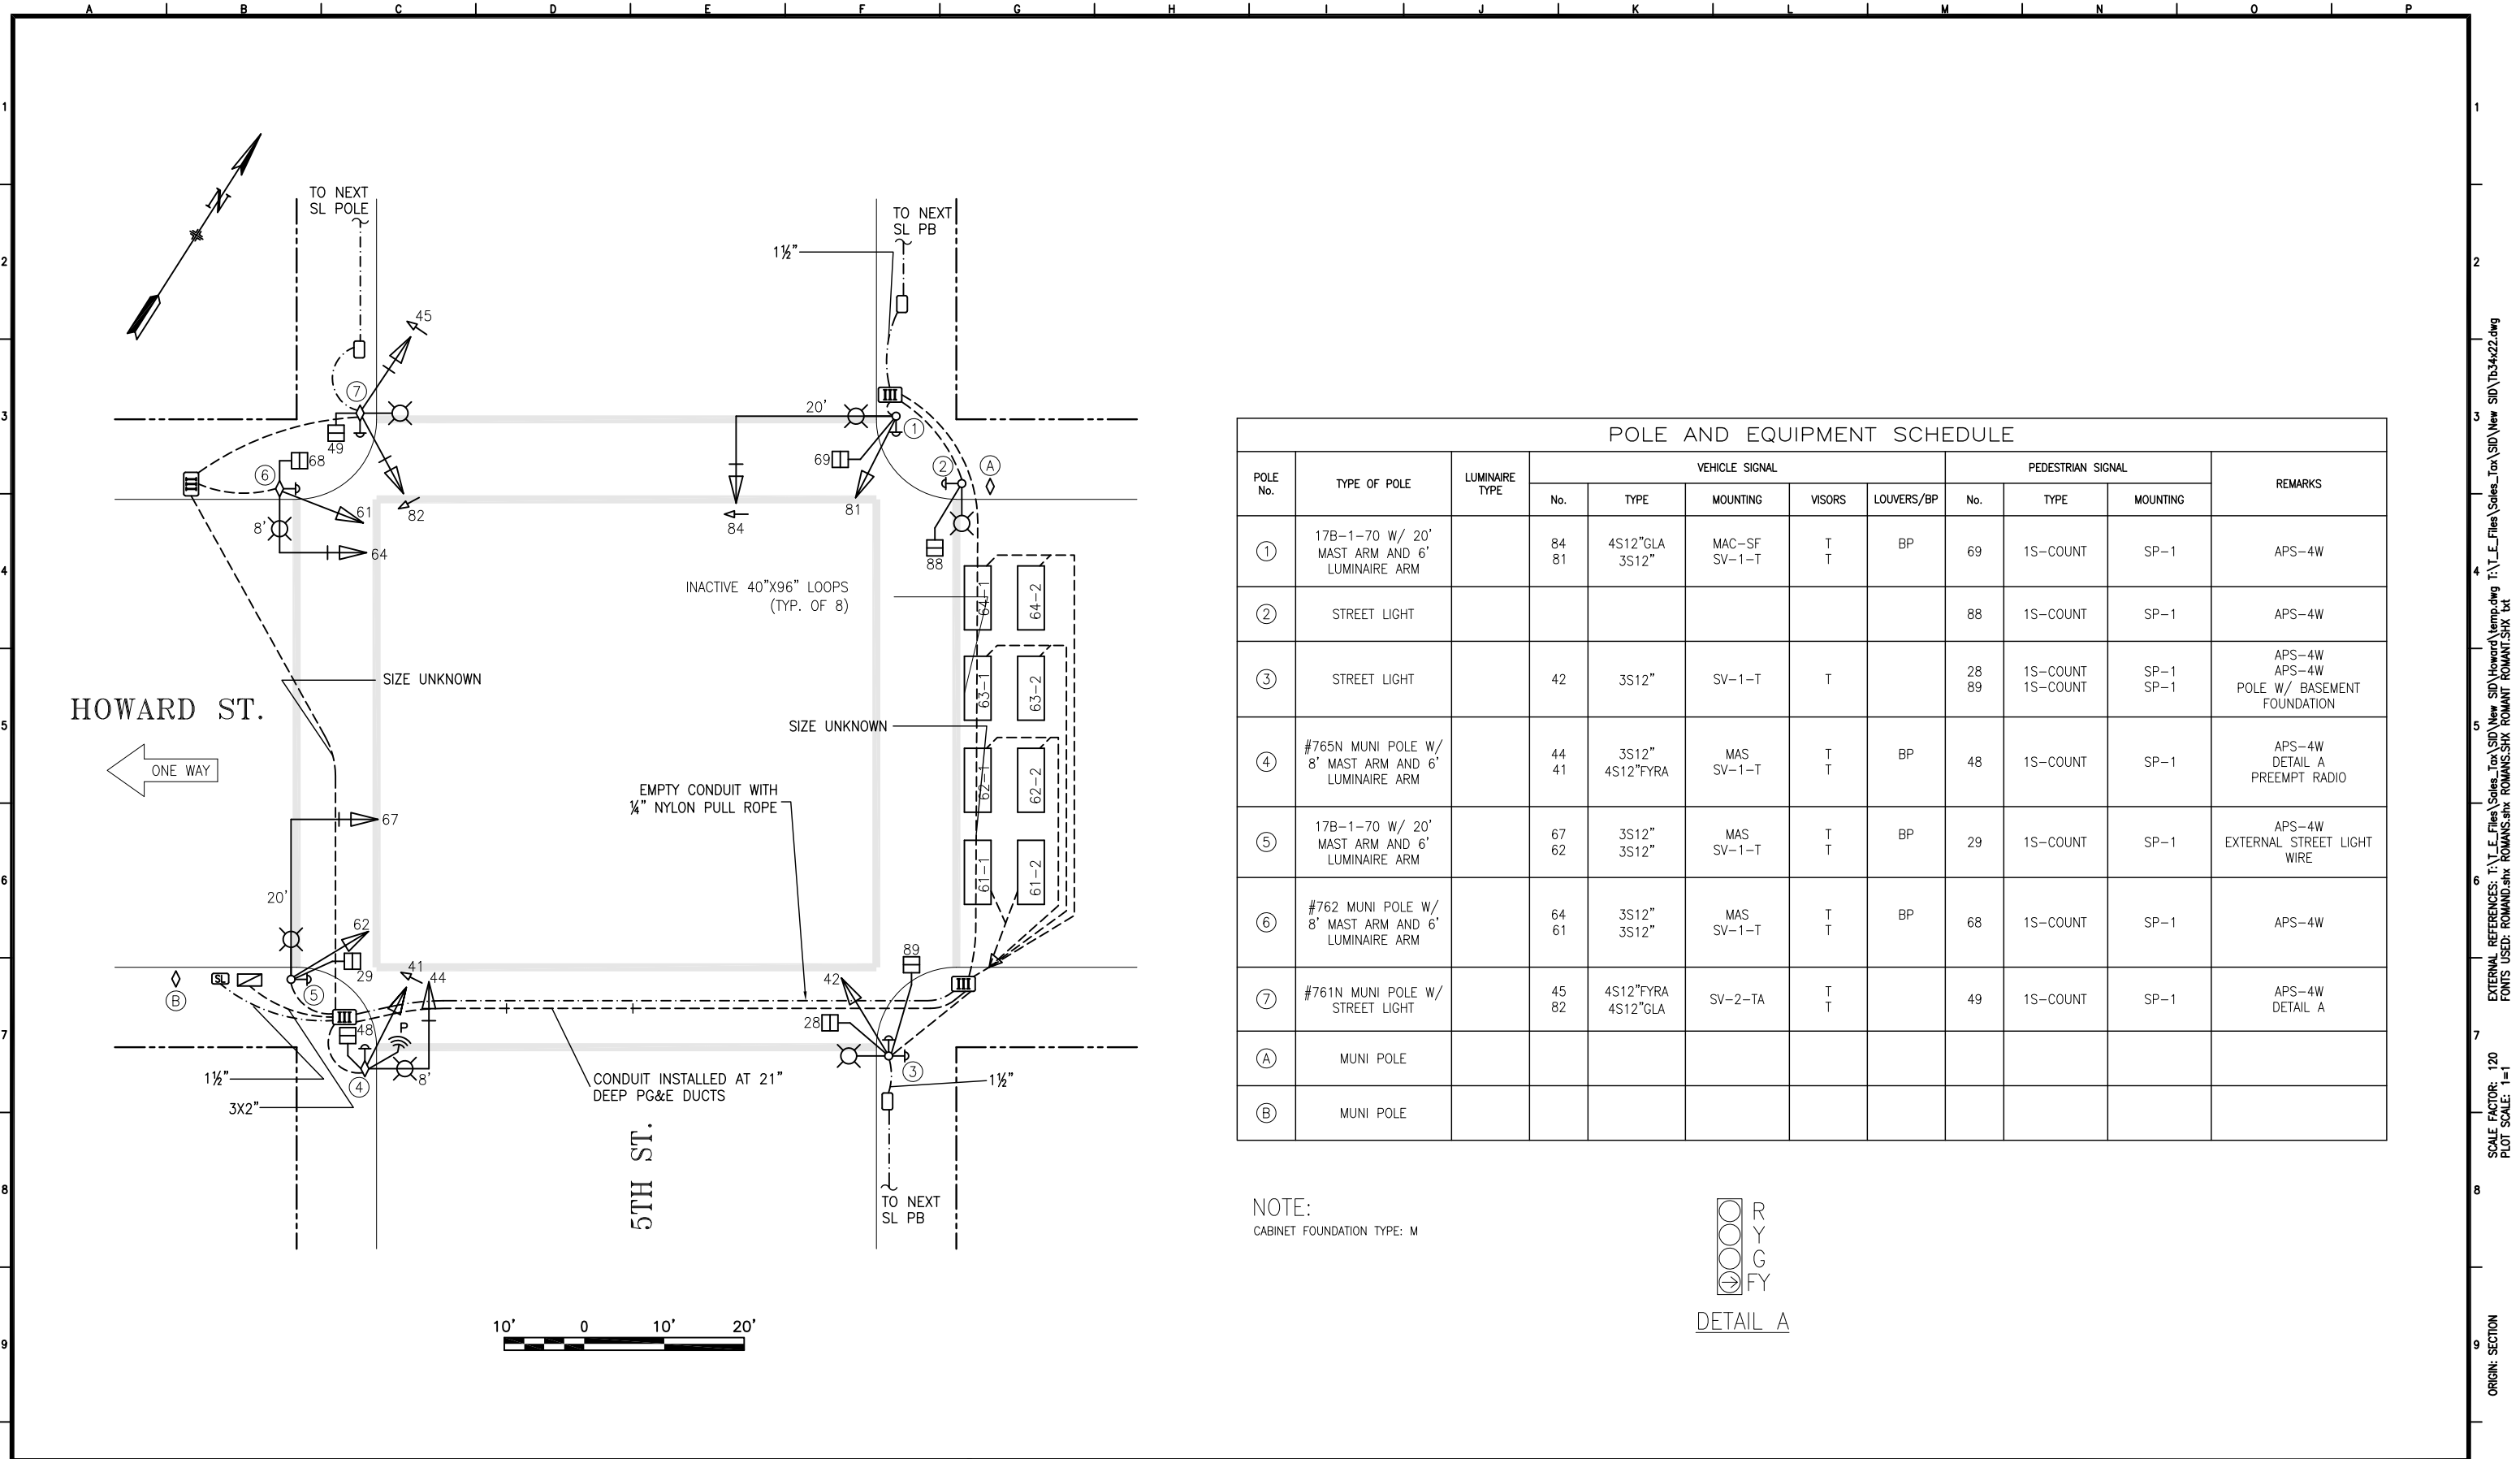

POLE AND EQUIPMENT SCHEDULE											
POLE No.	TYPE OF POLE	LUMINAIRE TYPE	VEHICLE SIGNAL					PEDESTRIAN SIGNAL			REMARKS
			No.	TYPE	MOUNTING	VISORS	LOUVERS/BP	No.	TYPE	MOUNTING	
①	17B-1-70 W/ 20' MAST ARM AND 6' LUMINAIRE ARM		84 81	4S12"GLA 3S12"	MAC-SF SV-1-T	T T	BP	69	1S-COUNT	SP-1	APS-4W
②	STREET LIGHT							88	1S-COUNT	SP-1	APS-4W
③	STREET LIGHT		42	3S12"	SV-1-T	T		28 89	1S-COUNT 1S-COUNT	SP-1 SP-1	APS-4W APS-4W POLE W/ BASEMENT FOUNDATION
④	#765N MUNI POLE W/ 8' MAST ARM AND 6' LUMINAIRE ARM		44 41	3S12" 4S12"FYRA	MAS SV-1-T	T T	BP	48	1S-COUNT	SP-1	APS-4W DETAIL A PREEMPT RADIO
⑤	17B-1-70 W/ 20' MAST ARM AND 6' LUMINAIRE ARM		67 62	3S12" 3S12"	MAS SV-1-T	T T	BP	29	1S-COUNT	SP-1	APS-4W EXTERNAL STREET LIGHT WIRE
⑥	#762 MUNI POLE W/ 8' MAST ARM AND 6' LUMINAIRE ARM		64 61	3S12" 3S12"	MAS SV-1-T	T T	BP	68	1S-COUNT	SP-1	APS-4W
⑦	#761N MUNI POLE W/ STREET LIGHT		45 82	4S12"FYRA 4S12"GLA	SV-2-TA	T T		49	1S-COUNT	SP-1	APS-4W DETAIL A
Ⓐ	MUNI POLE										
Ⓑ	MUNI POLE										

NOTE:
CABINET FOUNDATION TYPE: M

RYG
FY
DETAIL A

NO.	DATE	DESCRIPTION	BY	APPROVED
2	02/27/22	5TH ST QB (SRC 2022-042) - REPLACE SIGNALS 41, 82, AND, 84. INSTALL SIGNAL 45. UPGRADE ALL 8" TO 12" HEADS. PER FIELD PREEMPT RADIO.	J.CHIMENTO	M.SALLABERRY
1	03/99	HOWARD STREET SIGNAL UPGRADE CONTRACT #1430N	C.LEUNG	R.OLEA

TABLE OF REVISIONS
CHECKOUT DRAWING THROUGH THE SID CUSTODIAN FOR THE LATEST REVISION



SFMTA

DRAWN BY: JD/C.LEUNG	DATE: 12/28/00
CHECKED BY: R.OLEA	DATE: 5/30/01

SCALE 1" = 20'	TRAFFIC SIGNAL INVENTORY DIAGRAM	CNN NO: 23944000
SHEET OF SHEETS 1 OF 1		REV NO: 2

5TH ST & HOWARD ST

EXTERNAL REFERENCES: I:\L_E_Files\Sales_Tax\SID\New SID\Howard\Temp.dwg T:\L_E_Files\Sales_Tax\SID\New SID\Tb34422.dwg
FONTS USED: ROMANS.SHY ROMANS.SHY ROMANS.SHY ROMANS.SHY
SCALE FACTOR: 120
PLOT SCALE: 1"=1'
ORIGIN: SECTION 1
FILE NAME: 05ST_Howard.dwg
DATE: May 30 2001 16:00