

			С	ON	DU	ΙΤ	ΑN	D	WIF	RIN	G 5	SCH	HEC	UL	E.											
	CONDUIT RUN NUMBER	$\triangle$	2	3	4	<u>\$</u>	6	A	B	<u>\$</u>	199	$\triangle$	12	13	14	15	16	A	18	19	20	21	22			
	CONDUIT SIZE (INCH)	2	2	2	2	2	2	2	3	2	EX	EX	2	EX	2	3	2	2	1.5	2	1.5	2	2	-		
	NOTES								<b>(P)</b>	<b>P</b>						(P)	<b>(P)</b>	<b>P</b>		PSP			<b>P</b>			
	#14 WIRES					-					İ					1						<b></b>				
	SIGNAL 28	2	2		<b>-</b>	2			2		-							<del> </del>				<u> </u>	<del> </del>		<del>  </del>	
	SIGNAL 21	3	3			3			3							<b>†</b>							<b></b>		$\vdash$	
	SIGNAL 42	3	3			3			3																	
	SIGNAL 24	3	3			3			3										·							
	SIGNAL 89	2	2			2			2																	
	SIGNAL 41			3			3		3							<u> </u>										
	SIGNAL 44			3			3		3																	
	SIGNAL 29			2			2		2																	
2	SIGNAL 48 SIGNAL 62			ļ	2		2		2	<u> </u>					ļ <u>.</u>	ļ			<u> </u>							
(F/I)	SIGNAL 68				3		3	2	3_2										L						$\sqcup$	
	SIGNAL 61		_		ļ			3	3														<b>.</b>		igwdapsilon	
WIRING	SIGNAL 49							2	2	_	-														├	
	SIGNAL 64		<b></b>					3	3		·		-												$\vdash$	
_	SIGNAL 22 (EX)			-				-			3		3			3									$\vdash \vdash \vdash$	
	SIGNAL 88 (EX)				-							2	2			2			l	<b> </b>					$\vdash$	
	SIGNAL 81 (EX)											3	3			3				<del></del>					-	
li	SIGNAL 69 (EX)											2	2		-	2									-	
	SIGNAL 84 (EX)											3	3			3										
	SIGNAL 82								-"					3	3	3										
1 [																				-			-			
	#14 WIRES (NEUTRAL)	4		3	2			4			. 1	4		1											ш	
	#14 WIRES (SPARE)		3			3			3				3			3										
	TOTAL #14 WIRES	17	16	11	7	16	13	14	39		4	14	16	4	3	19										
1 1	#10 WIRES (NEUTRAL)		1			1	1		3			$\neg$	1		1	2				-						
	8 WIRES (120V SERVICE)								- 7							T-	2				2					
[	#6 BSCW								1	1						1	1				1					
[	#8 WIRES (ST. LIGHT)		2			2													2							
	#10 WIRES (ST. LIGHT)	2		2				2																		
	12/C INTERCONNECT									1												1				
	1/4" PULL ROPE		1			1	1						1					1				1				
	CAM.PHASE 3#14(BROWN)																					1	1			
	CAM.POWER 3#14 (PINK)																					1	1		$\square$	
																									, I	

			Р	OLE AI	ND EQUIF	PMENT	r sche	EDULE	
POLE No.	TYPE OF POLE	LUMINAIRE (HPS)	UMINAIRE (HPS) VEHICLE SIGNAL PEDESTRIAN SIGNAL					REMARKS	
140.	THE OF FOLL	VOLTAGE/ WATTS	No.	TYPE	MOUNTING (F/I)	No.	TYPE	MOUNTING (F/I)	112
1	EX 17-1-70 WITH 20' MAST ARM AND 6' LUMINAIRE ARM		84 (EX) 81 (EX)	3S12"(EX) V1 3S8" (EX) V1		69 (EX) 88 (EX)	1S-IN 1S-IN		
2	EX MUNI		22 (EX)	3S8"(EX) 🕠					
3	17-1-70 WITH 8' MAST ARM AND 6' LUMINAIRE ARM	120/200	24 21 42	3S12" 3S8" 3S8"	MAC-SF SV-2-TA	89 28	1S-IN 1S-IN	SP-1 SP-1	BACKPLATE
4	17-1-70 WITH 20' MAST ARM AND 6' LUMINAIRE ARM	120/200 (B2)	44 41	3S12" 3S8"	MAS (END) SV-1-T	29	1S-IN	SP-1	BACKPLATE
5	1-A (10')		62	358"	TV-1	48	1S-IN	SP-1	
6	17-1-70 WITH 8' MAST ARM AND 6' LUMINAIRE ARM	120/200 \$2	64 61	3S12" 3S8"	MAC-SF SV-1-T	49 68	1S-IN 1S-IN	SP-1 SP-1	BACKPLATE
7	EX 1-A(10')		82	358"	TV-1-T				

## **DETAIL NOTES:**

- F/I WITH INTEGRAL BALLAST AND PHOTOELECTRIC CONTROL. F/I FUSE AND FUSE HOLDERS PER SPDPWSF FILE #49,092.
- POLYVINYL CHLORIDE (PVC) CONDUIT SCHEDULE 80.
- EX HOUSING TO REMAIN. F/I LED RED, YELLOW, AND GREEN.

1	11-09-20	SRC 2020-255: UPDATED MOUNTING FOR SIGNALS 24 AND 64	HYu	MVelasco

					REFERENCE INFORMATION & FILE NO. OF SURVEYS
			ļ		
				<u> </u>	
NO.	DATE	DESCRIPTION	BY	APP.	
	CHE	TABLE OF REVISIONS CK WITH TRACING TO SEE IF YOU HAVE LATEST REVISION			


BUREAU OF ENGINEERING
DEPARTMENT OF PUBLIC WORKS
CITY AND COUNTY OF SAN FRANCISCO

	DESIGNED: DATE:	APPROVED	SCALE:	CONT. MIGGION CONDITION
	DSB/DVS 1/01	SECTION MANAGER DATE:	NONE	SOMA MISSION STREET TRAFFIC SIGNAL UPGRADE
	DRAWN: DATE: JS DSB/WL 1/01			
i		DMSION MANAGER DATE:	SHEET OF SHEETS	5TH STREET AND MISSION ST.
	CHECKED: DATE:		22 OF 39	TRAFFIC SIGNAL WORKS (SCHEDULES)
	SL/BW 1/01	CITY ENGINEER DATE:		(201112)

9

TLE NAME: 1663nE-17.dwg DATE: Oct 06 1999 14:4

75,579 REV. NO. 1

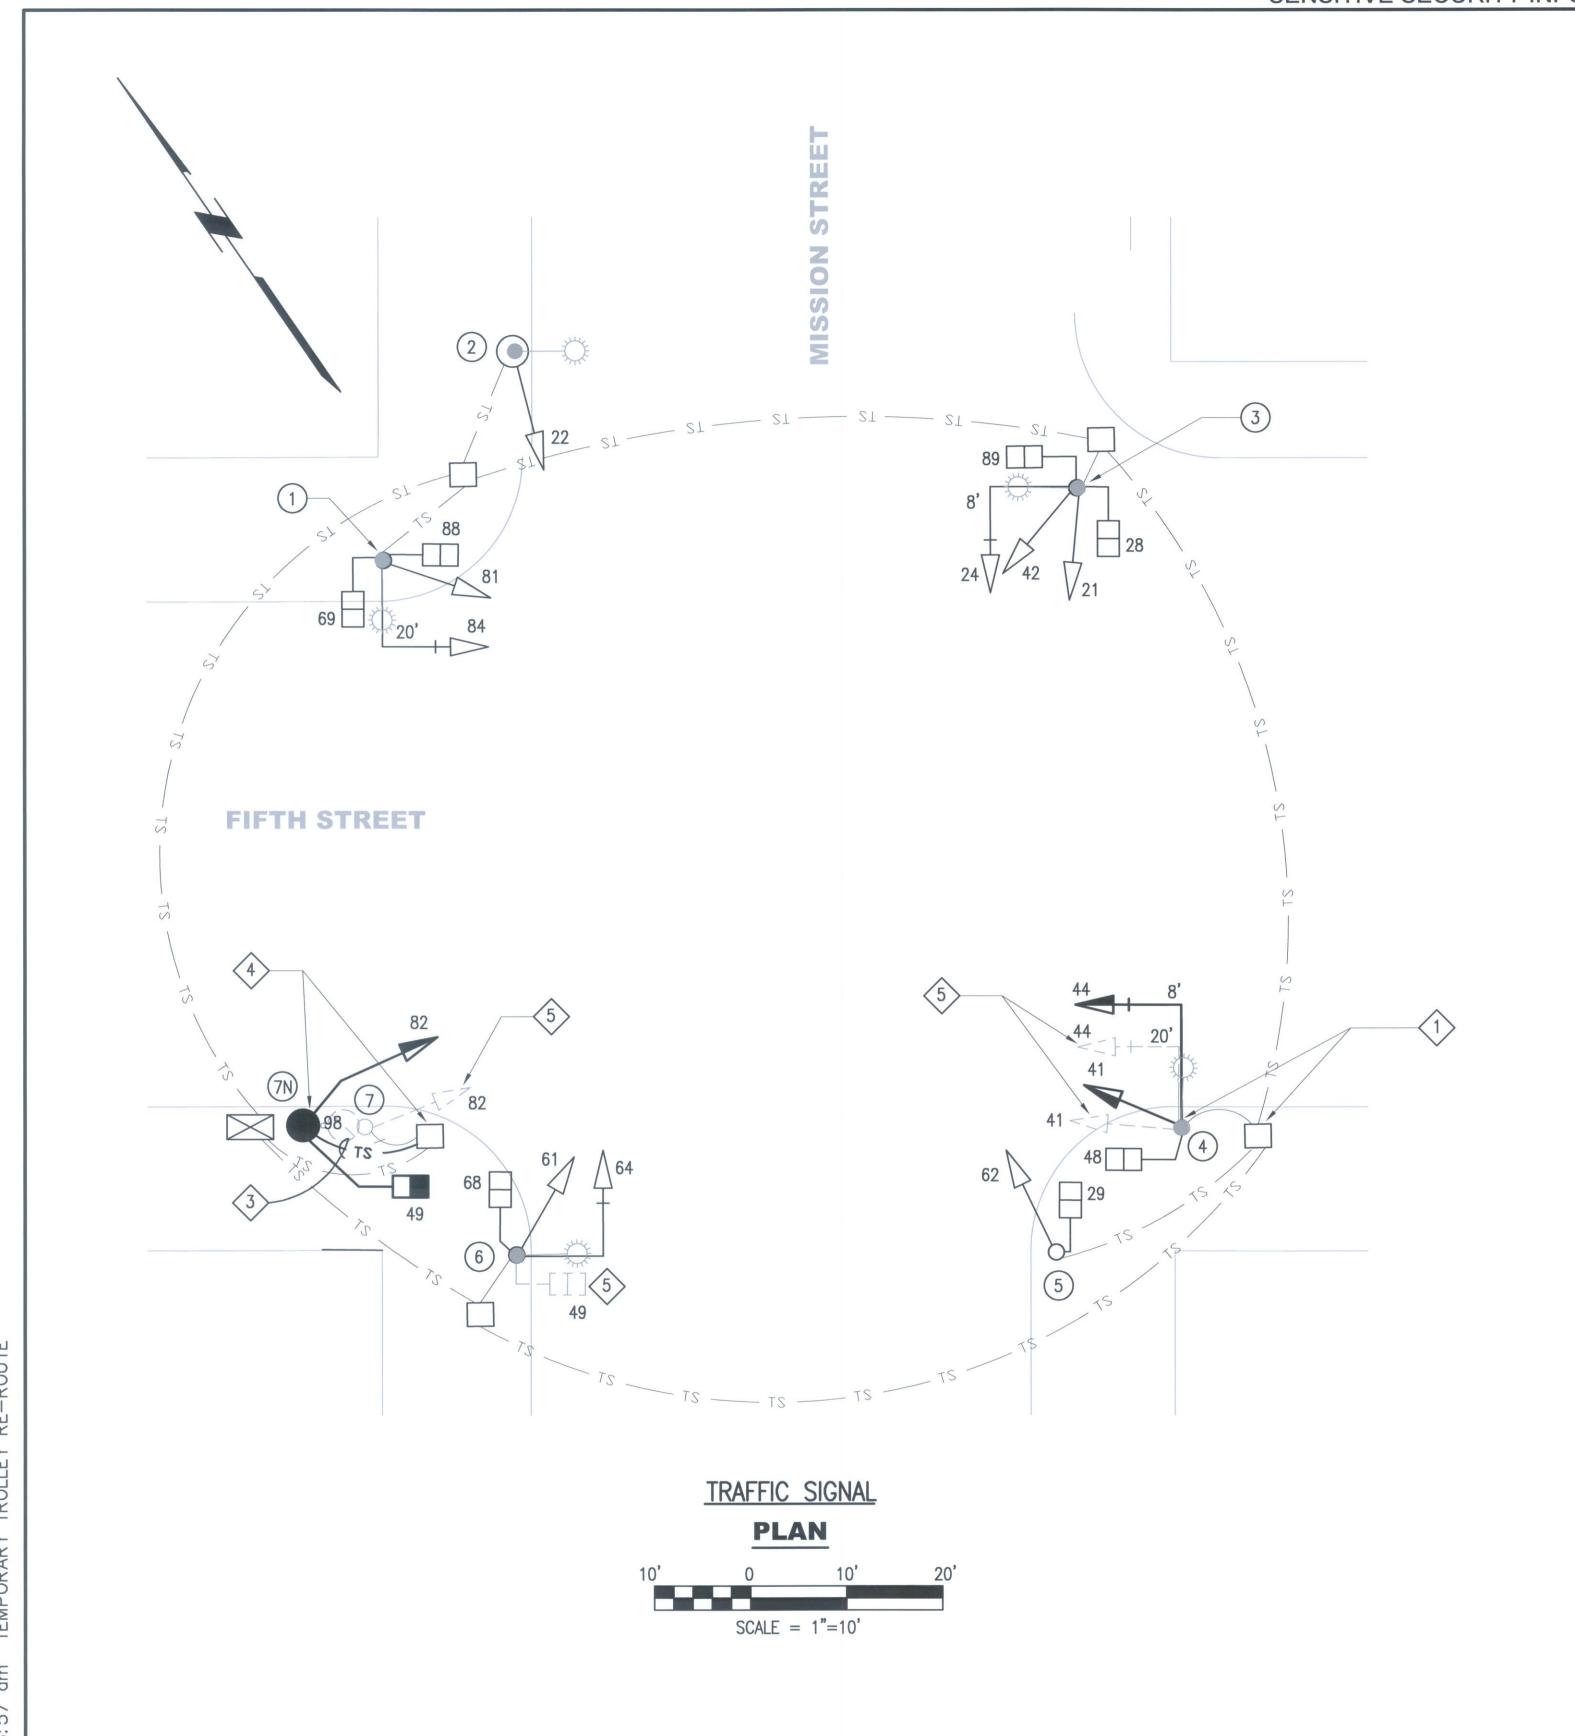



- 1. PULL (E) WIRES FROM (E) SIGNAL AND PEDESTRIAN HEADS TO (E) PULL BOX; REPULL AND RECONNECT WIRING TO (N) SIGNAL AND PEDESTRIAN HEADS AFTER (N) MAST ARM INSTALLATION IS COMPLETED.
- 2. CONTRACTOR WORK IN THIS TABLE IN BOLD.
- 3. F/I 2" GRSC.
- 4. PULL (E) WIRES FROM (E) SIGNAL HEAD TO (E) PULL BOX; REPULL AND RECONNECT WIRING TO (N) SIGNAL HEAD AFTER (N) TROLLEY POLE INSTALLATION IS COMPLETED.
- DISCONNECT (E) WIRES TO (E) TRAFFIC SIGNAL DEVICES PRIOR TO DEMO.

			POL	E AND	EQUIF	PMENT	SC	HEDUL	. <b>E</b> <2>		
POLE	TYPE OF POLE			VEHICLE SIG	GNAL		PE	DESTRIAN S	IGNAL	REMARKS	
No.		No.	TYPE	MOUNTING	VISORS	LOUVERS	No.	TYPE	MOUNTING		
1	17-1-70 WITH 20' MAST ARM & 6' LUMINAIRE ARM	81 84	3S8" 3S12"	SV-1-T MAS (END)			69 88	1S-IN 1S-IN			
2	TROLLEY	22	3S8"								
3	17-1-70 WITH 8' MAST ARM & 6' LUMINAIRE ARM	21 24 42	3S8" 3S12" 3S8"	SV-2-TA MAC-SF			28 89	1S-IN 1S-IN	SP-1 SP-1		
4	17-1-70 WITH 8' MAST ARM & 6' LUMINAIRE ARM	41 44	3S8" 3S12"	SV-1-T MAS (END)			48	1S-IN	SP-1	R/D SIGNAL HEADS 41, 44 AND, PEDESTRIAN HEAD 48, 20' MAST ARM, AND RELATED ACCESSORIES.	
		41 44	3S12" 3S12"	SV-1-T MAS (END)						F/I 8' MAST ARM, SIGNAL HEADS 41, 44 AND RELATED ACCESSORIES.	
5	1-A (10')	62	3S8"	TV-1			29	1S-IN	SP-1		
6	17-1-70 WITH 8' MAST ARM & 6' LUMINAIRE ARM	61 64	3S8" 3S12"	SV-1-T MAC-SF			<b>49</b> 68	<b>1S-IN</b> 1S-IN	<b>SP-1</b> SP-1	R/D PEDESTRIAN HEAD 49 AND RELATED ACCESSORIES.	
7	1-A (10')	82	358"	TV-1-T						R/D SIGNAL HEAD 82, POLE, AND RELATED ACCESSORIES.	
7N)	(N) TROLLEY	82	3S12*	SV-1-T			49	1S-IN	SP-1	F/I SIGNAL HEAD 82 , PEDESTRIAN HEAD 49, AND RELATED ACCESSORIES.	



AS BU	ILT
contractor	DAJE 26:13
RESIDENT ENGINEER	DATE 4/15/13
DESIGNER	DATE

11-09-20 SRC 2020-255: UPDATED MOUNTING FOR SIGNALS 24 AND 64 HYu

**MVelasco** 

W. SENG/A. HERCE **SFMTA** W. SENG S. PONG REV. 0 SEALED BY M. CHAN W. SENG/ A. HERCE RECOMMENDED

M. FOWLER 2/28/2013 AS BUILT R. EDWARD 7/08/2010 ISSUED FOR BID



CITY AND COUNTY OF SAN FRANCISCO **MUNICIPAL TRANSPORTATION AGENCY** 

> **APPROVED** CARTER R. ROHAN EXECUTIVE DIRECTOR/CEO

THIRD	STREET LIGHT	T RAIL PROGRAM	1
PHAS UNION SQUARE/MAR		ITRAL SUBWAY	
ONION SQUARE, MAI	WEI SINEEI	SIAHON OHEHE	5 KEEGOMIION

TRAFFIC SIGNALS
TEMPORARY TROLLEY RE-ROUTE
FIFTH STREET AND MISSION STREET

	1251						
TION	SFMTA CONTROL NO.  CL-178	345					
	DRAWING NO.	REVISION					
	ET-104	_					
	SHEET NO.	1					
	158	·					

WARNING: THIS RECORD CONTAINS SENSITIVE SECURITY INFORMATION THAT IS CONTROLLED UNDER 49 CFR PARTS 15 AND 1520. NO PART OF THIS RECORD MAY BE DISCLOSED TO PERSON WITHOUT A "NEED TO KNOW", AS DEFINED IN 49 CFR PARTS 15 AND 1520. NO PART OF THE ADMINISTRATION OR THE SECRETARY OF TRANSPORTATION. UNAUTHORIZED RELEASE MAY RESULT IN CIVIL PENALTY OR OTHER ACTION.