


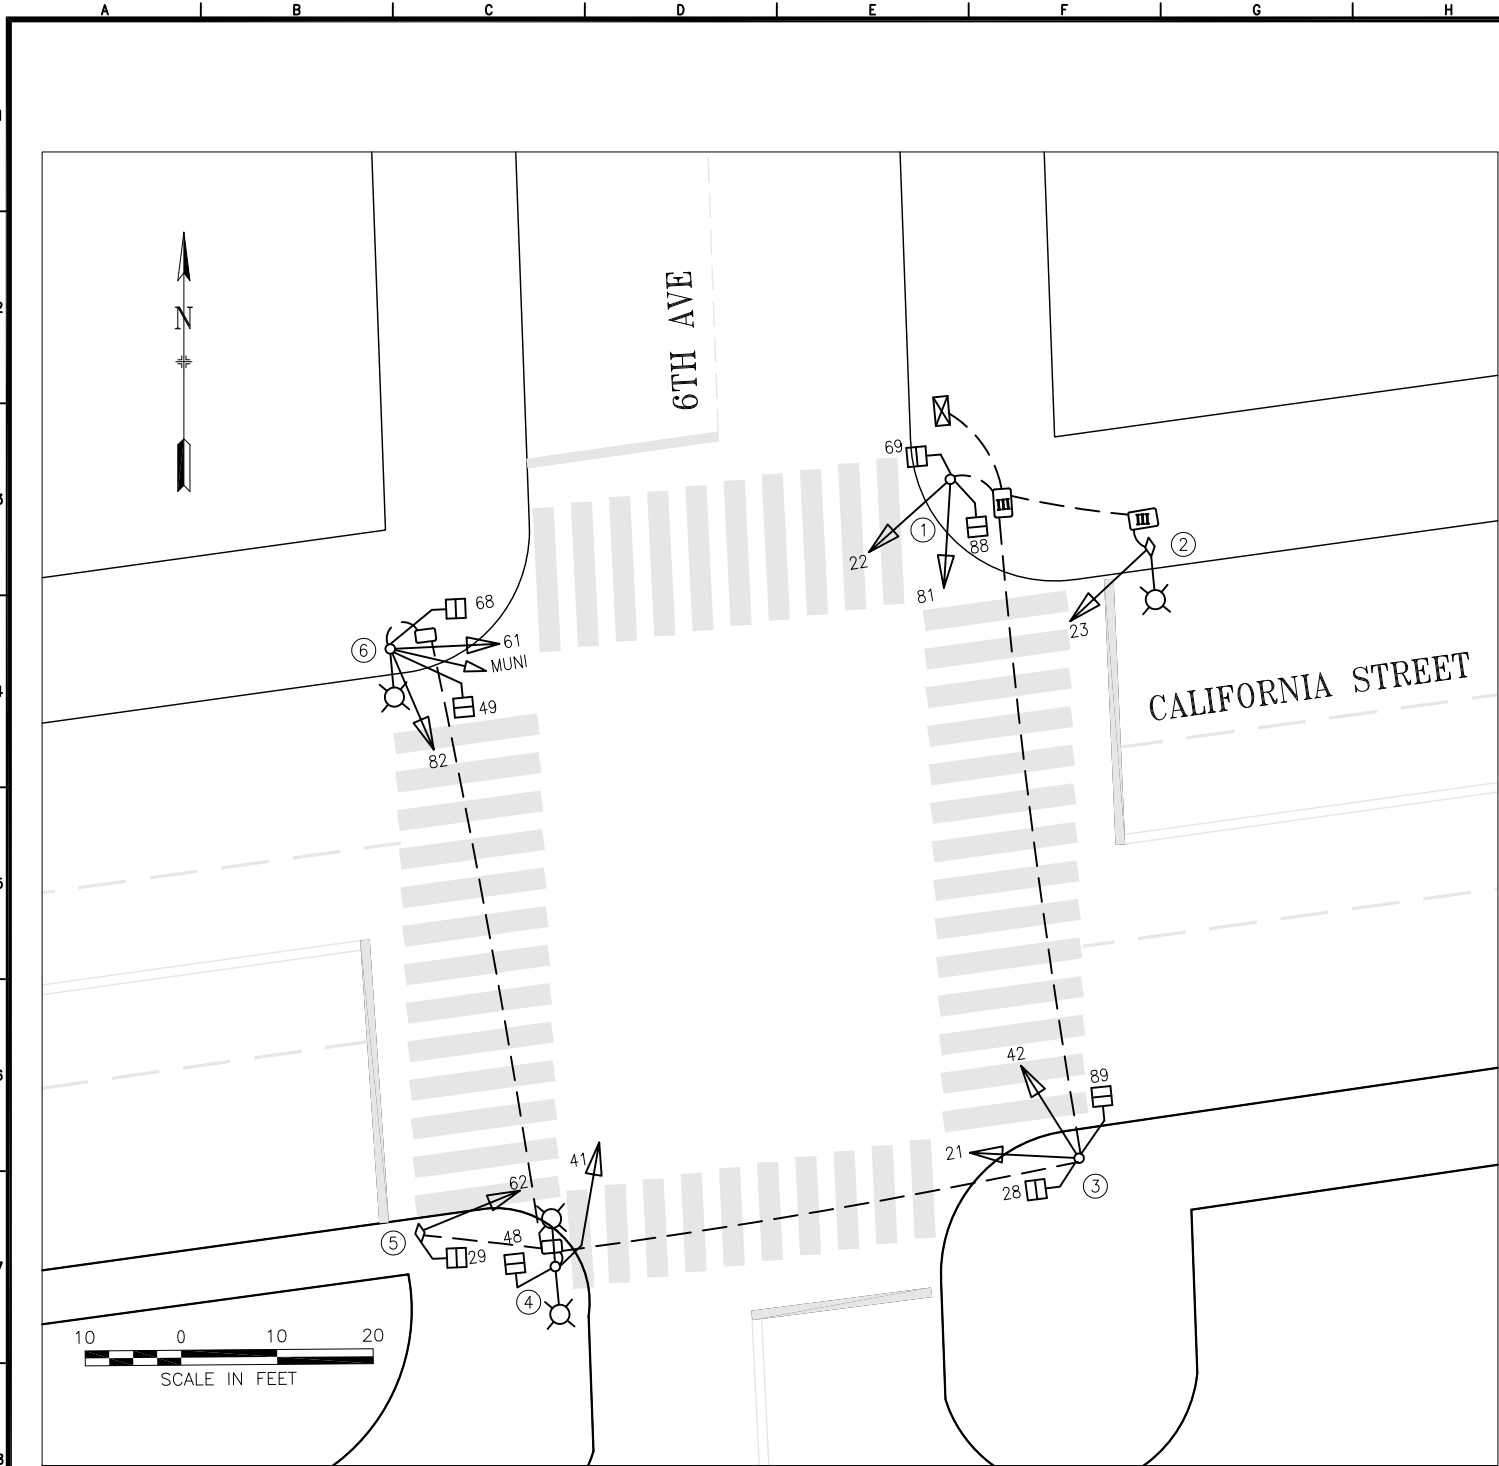

POLE AND EQUIPMENT SCHEDULE											
POLE No.	TYPE OF POLE	LUMINAIRE VOLTAGE/ WATTAGE	VEHICLE SIGNAL					PEDESTRIAN SIGNAL			REMARKS
			No.	TYPE	MOUNTING	VISORS	LOUVERS	No.	TYPE	MOUNTING	
①	MARBELITE		81 22	3S12" 3S12"	TV-2-T	T T		88 69	1S-COUNT 1S-COUNT	SP-1 SP-1	
②	MUNI POLE		23	3S12"	SV-1-T	T					
③	MARBELITE		42 21	3S12" 3S12"	TV-2-T	T T		89 28	1S-COUNT 1S-COUNT	SP-1 SP-1	
④	MARBELITE STREET LIGHT		41	3S12"	SV-1-T	T		48	1S-COUNT	SP-1-T	EXTERNAL CONDUIT
⑤	MUNI POLE		62	3S12"	SV-1-T	T		29	1S-COUNT	SP-1-T	EXTERNAL CONDUIT
⑥	STREET LIGHT		61 82 MUNI	3S12" 3S12" 2S8"LB	SV-2-TC SV-1	T T T		68 49	1S-COUNT 1S-COUNT	SP-2-T	EXTERNAL CONDUIT

Δ	04/08/19	ADDED SIGNAL 23 ON POLE 2 PER CONTRACT NO. 2805J	KAS	MV	
Δ	05/14/10	ADDED PCS & MUNI SIGNAL PER FIELD	KAS	MV	
NO.	DATE	DESCRIPTION	BY	APP.	

TABLE OF REVISIONS
CHECK WITH TRACING TO SEE IF YOU HAVE LATEST REVISION

REFERENCE INFORMATION
& FILE NO. OF SURVEYS



SAN FRANCISCO MUNICIPAL TRANSPORTATION AGENCY
CITY AND COUNTY OF SAN FRANCISCO

DRAWN:	DATE:
KAS	9/2018
CHECKED:	DATE:
DLA	9/2018

SCALE:
1" = 10'

SHEET OF SHEETS
1 OF 1

TRAFFIC SIGNAL INVENTORY DIAGRAM

CALIFORNIA STREET AND 6TH AVENUE

CNN NO.
27596000

REV NO.
1