


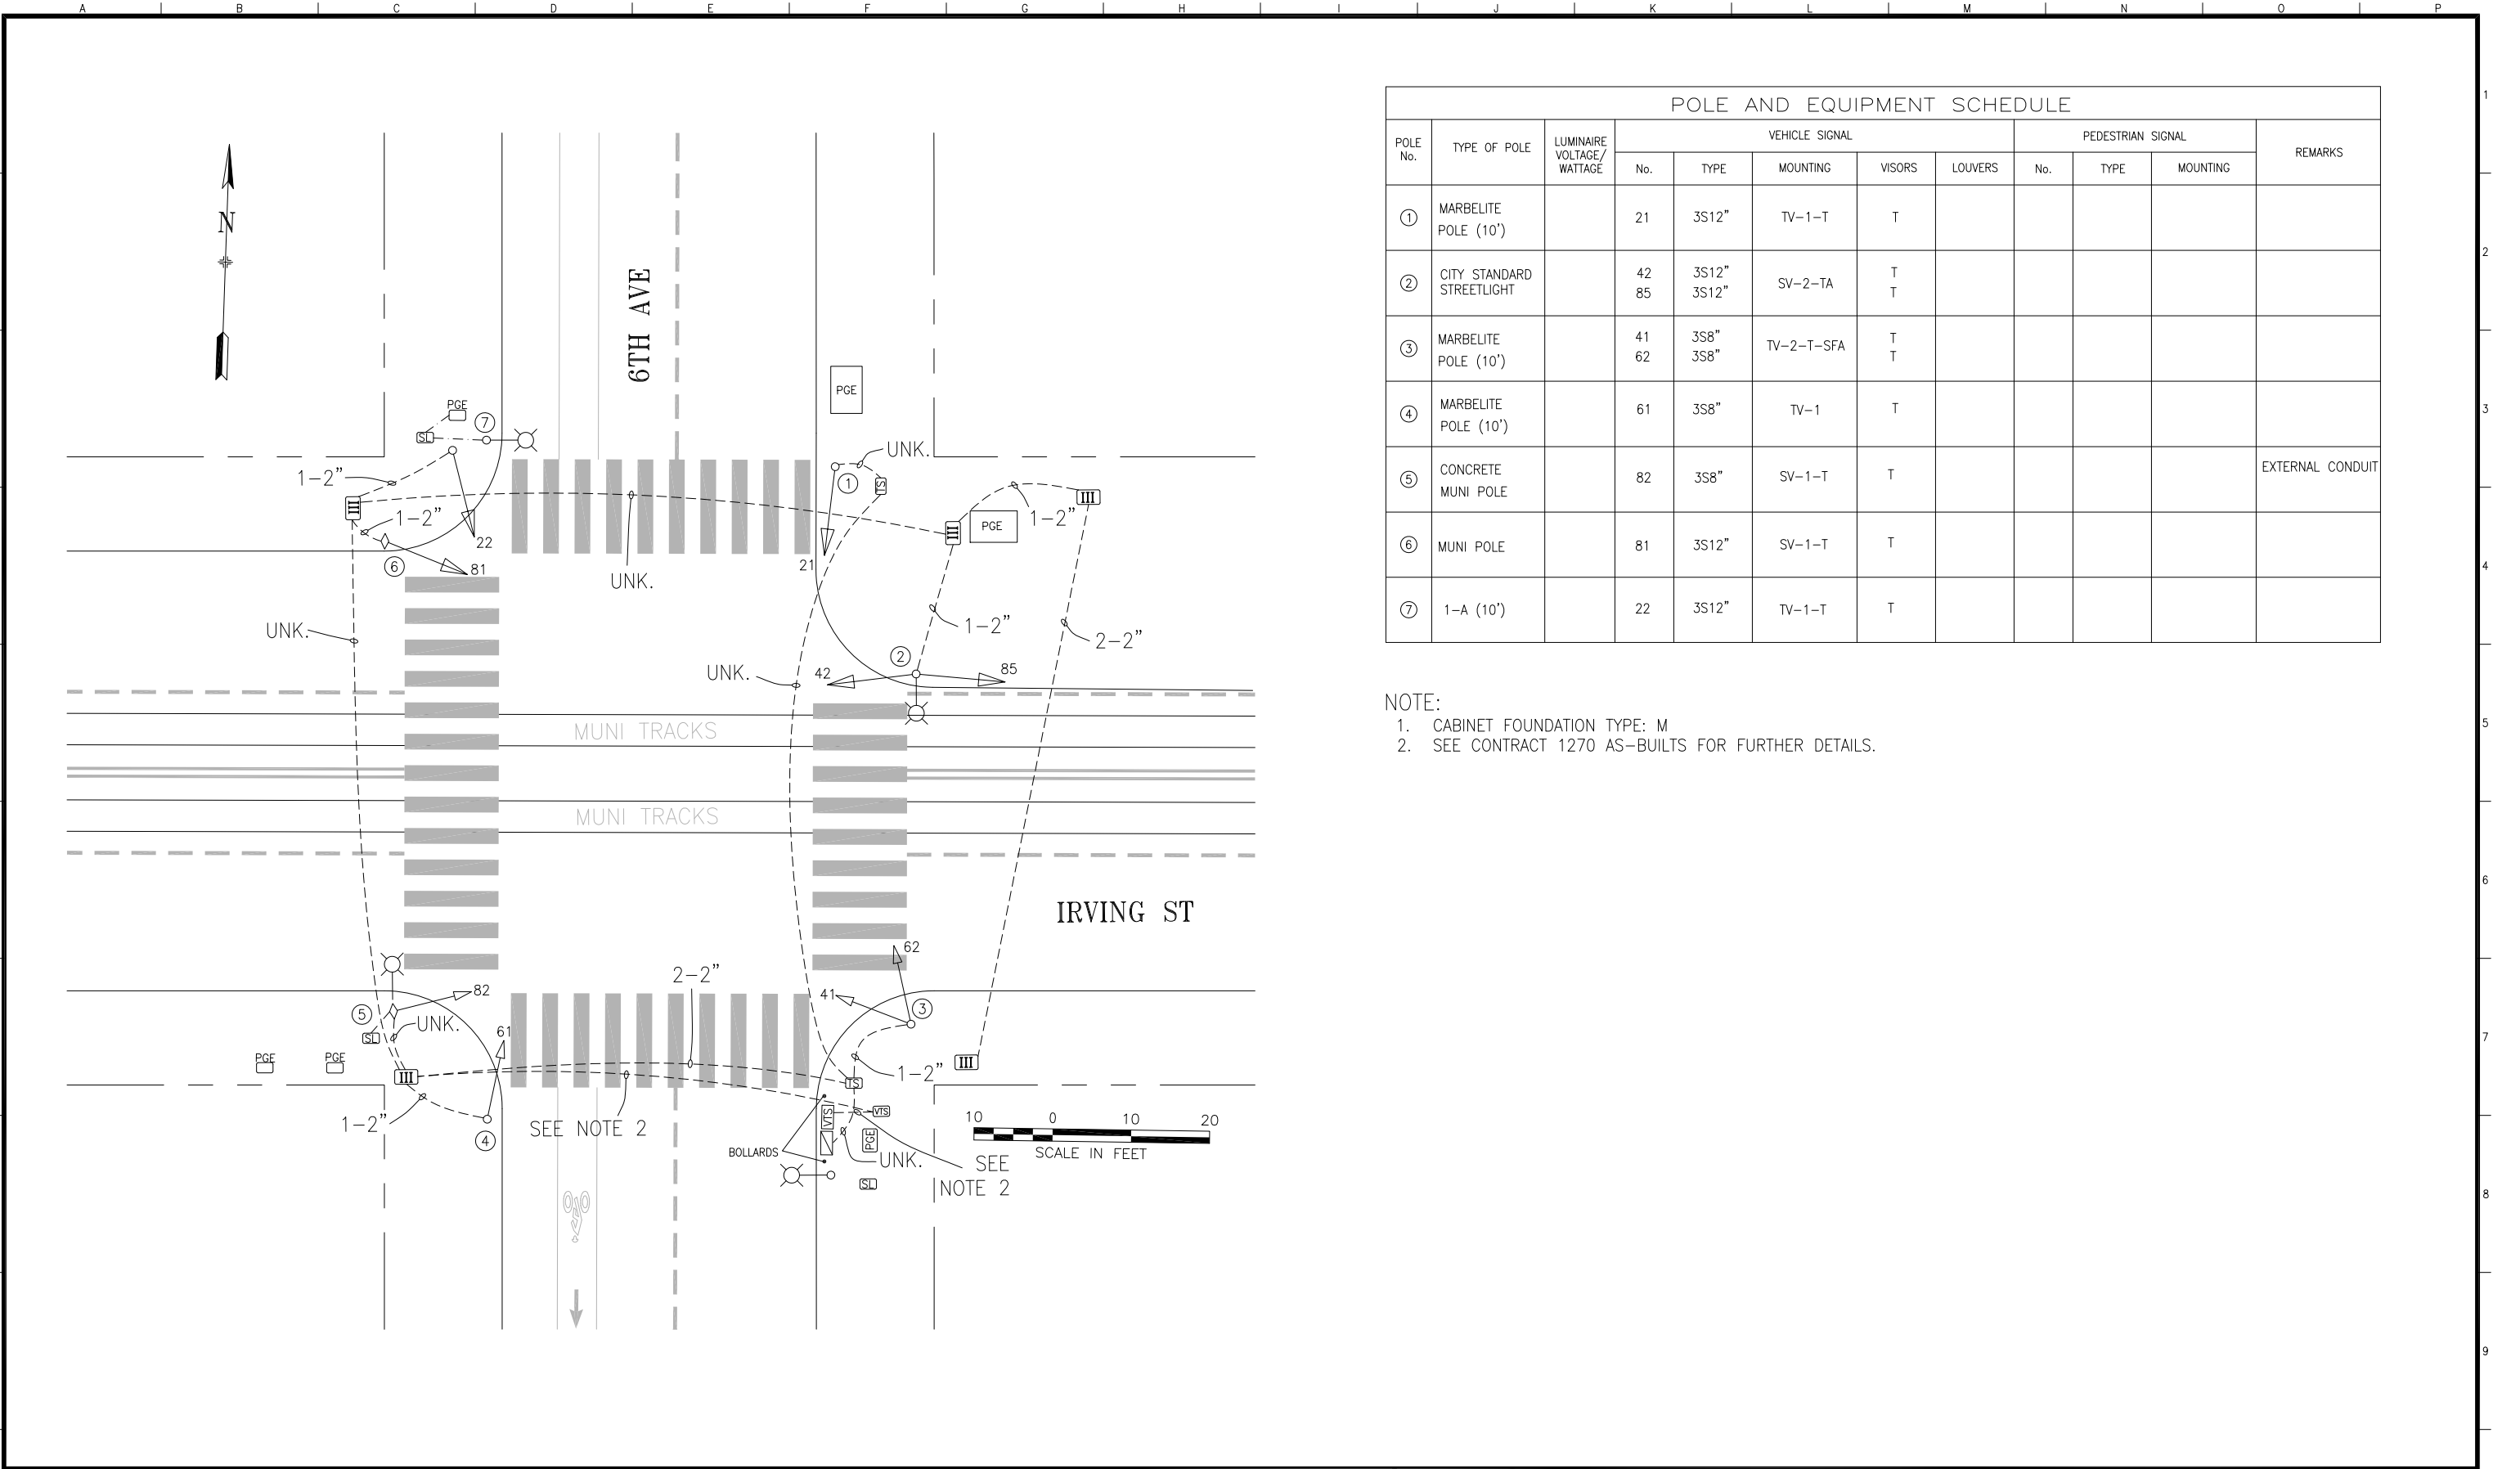

POLE AND EQUIPMENT SCHEDULE											
POLE No.	TYPE OF POLE	LUMINAIRE VOLTAGE/ WATTAGE	VEHICLE SIGNAL					PEDESTRIAN SIGNAL			REMARKS
			No.	TYPE	MOUNTING	VISORS	LOUVERS	No.	TYPE	MOUNTING	
①	MARBELITE POLE (10')		21	3S12"	TV-1-T	T					
②	CITY STANDARD STREETLIGHT		42 85	3S12" 3S12"	SV-2-TA	T T					
③	MARBELITE POLE (10')		41 62	3S8" 3S8"	TV-2-T-SFA	T T					
④	MARBELITE POLE (10')		61	3S8"	TV-1	T					
⑤	CONCRETE MUNI POLE		82	3S8"	SV-1-T	T					EXTERNAL CONDUIT
⑥	MUNI POLE		81	3S12"	SV-1-T	T					
⑦	1-A (10')		22	3S12"	TV-1-T	T					

NOTE:
1. CABINET FOUNDATION TYPE: M
2. SEE CONTRACT 1270 AS-BUILTS FOR FURTHER DETAILS.

0	6/5/20	CONVERTED FROM MSID AND CT-1270 AS-BUILTS;	TY	CL	
		SRC 2019-327: RELOCATED SIGNAL 42 FROM POLE 1 TO POLE 2 & INSTALLED SIGNAL 85 ON POLE 2			
NO.	DATE	DESCRIPTION	BY	APP.	

TABLE OF REVISIONS
CHECK WITH TRACING TO SEE IF YOU HAVE LATEST REVISION

REFERENCE INFORMATION
& FILE NO. OF SURVEYS



SAN FRANCISCO MUNICIPAL TRANSPORTATION AGENCY
CITY AND COUNTY OF SAN FRANCISCO

DRAWN: TY
CHECKED: MV

DATE: 07/2020
DATE: 07/2020

SCALE:
AS SHOWN
SHEET OF SHEETS
1 OF 1

TRAFFIC SIGNAL INVENTORY DIAGRAM

6TH AVE & IRVING ST

CNN NO.
27084000

REV NO.
0