


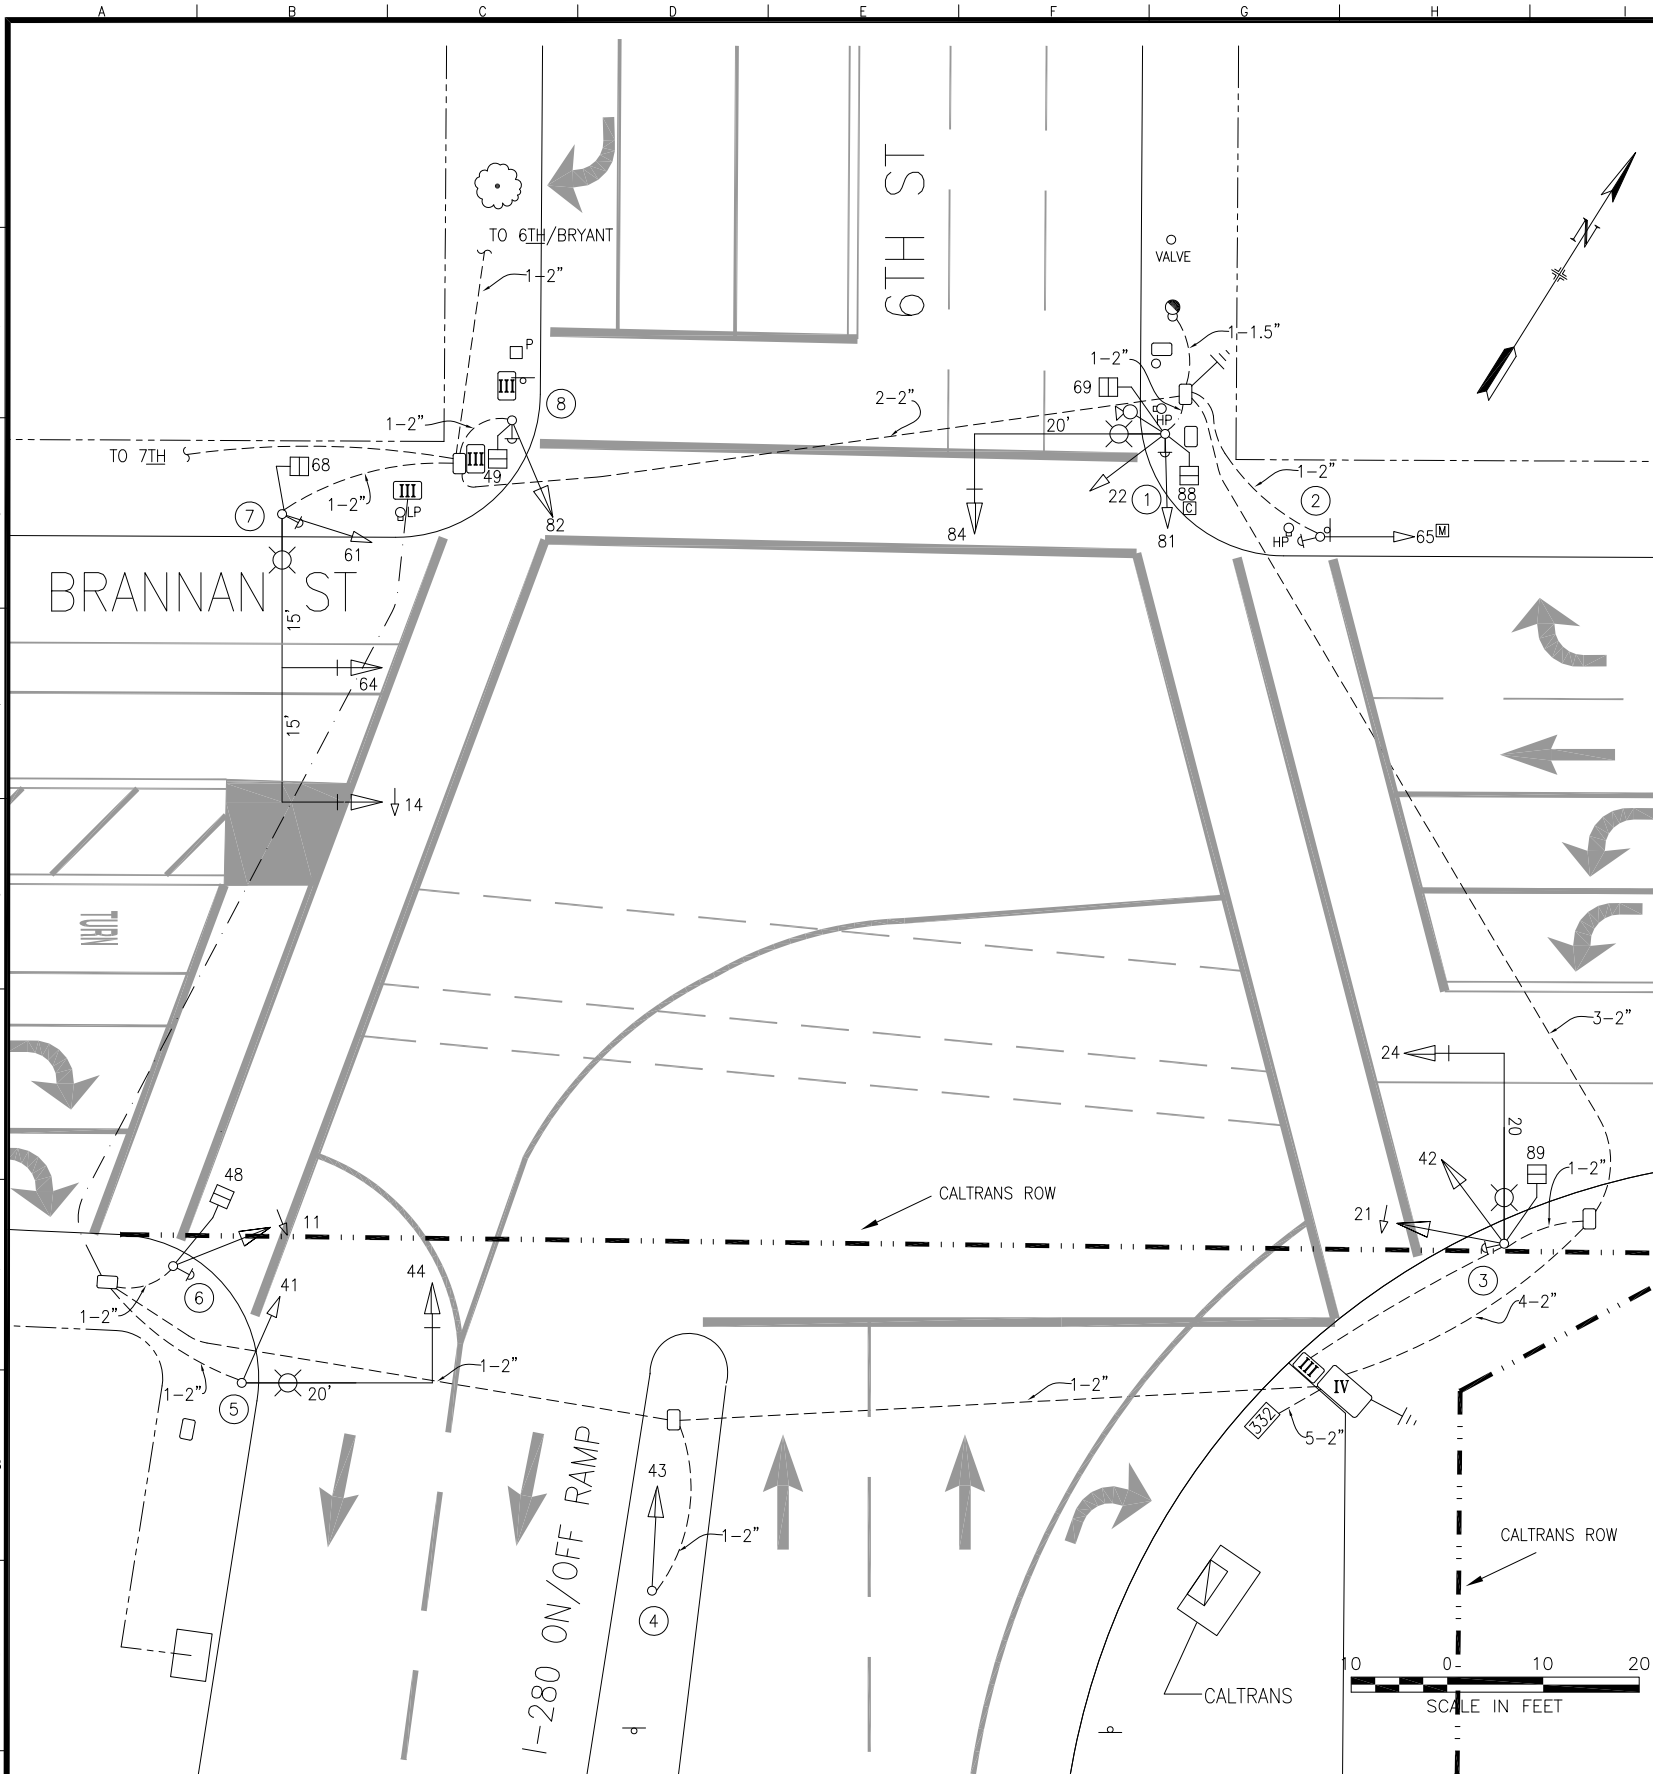

POLE AND EQUIPMENT SCHEDULE									
POLE No.	TYPE OF POLE	LUMINAIRE (HPS)	VEHICLE SIGNAL			PEDESTRIAN SIGNAL			REMARKS
		VOLTAGE/ WATTS	No.	TYPE	MOUNTING (F/I)	No.	TYPE	MOUNTING (F/I)	
①	POLE WITH 20' MA AND 6' LA		84 81 22	3S12" 3S8" 3S8"	MAT (TIP) SV-2-TA	88 69	1S-C 1S-C	SP-2-T	APS-3W BACKPLATE PTZ CAMERA
②	1-A (10')		65	3S8"	TV-1-T				APS-3W
③	POLE WITH 20' MA AND 6' LA		24 21 42	3S12" 4S12"GRA 3S12"	MAS (TIP) SV-1 SV-1	89	1S-C	SP-1-SF(12")	APS-3W BACKPLATE
④	1-A (10')		43	3S12"					
⑤	POLE WITH 20' MA AND 12' LA		44 41	3S12" 3S8"	MAS (TIP) SV-1-T				BACKPLATE
⑥	1-A (10')		11	3S12"LA	TV-1-T	48	1S-C	SP-1	APS-3W
⑦	19-3-70 W/ 30' MAST AND 6' LUM ARM	240/150	14 64 61	3S12"LA 3S12" 3S8"	MAS MAS SV-1-T	68	1S-C	SP-1	BACKPLATE BACKPLATE APS-3W
⑧	1-A (10')		82	3S12"	TV-1-T	49	1S-C	SP-1	APS-3W

NO.	DATE	DESCRIPTION	BY	APPROVED
3	5/16/22	UPDATE PER FIELD: 1S-C. NOTE BP & PTZ. UPDATE MOUNTINGS & MA/LA LENGTH.	D. Yeung	G. de Leon
2	4/5/22	INSTALL APS PER CALTRANS PROJECT 04-3J8904 AND SRC 2021-342	D. Yeung	G. de Leon
1	12/23/15	SIGNAL 42 UPGRADED TO 12"; NEW MOUNTINGS ON POLE 3	JHornbostel	ETsui
0	04/16/02	SIGNAL UPGRADE THRU 1989N; CONVERTED FROM AS-BUILT	JHornbostel	ETsui
NO.	DATE	DESCRIPTION	BY	APPROVED
TABLE OF REVISIONS CHECKOUT DRAWING THROUGH THE SID CUSTODIAN FOR THE LATEST REVISION				



SFMTA

DRAWN BY:	DATE:
JH	2/2016
CHECKED BY:	DATE:
ET	2/2016

SCALE
AS SHOWN
SHEET OF SHEETS
1 OF 1

TRAFFIC SIGNAL INVENTORY DIAGRAM
6th ST. AND BRANNAN ST.

CNN NO:
2389000
REV NO:
3

EXTERNAL REFERENCES:
FONTS USED:
SCALE FACTOR:
PLOT SCALE:
ORIGIN:
FILE NAME:
DATE: