


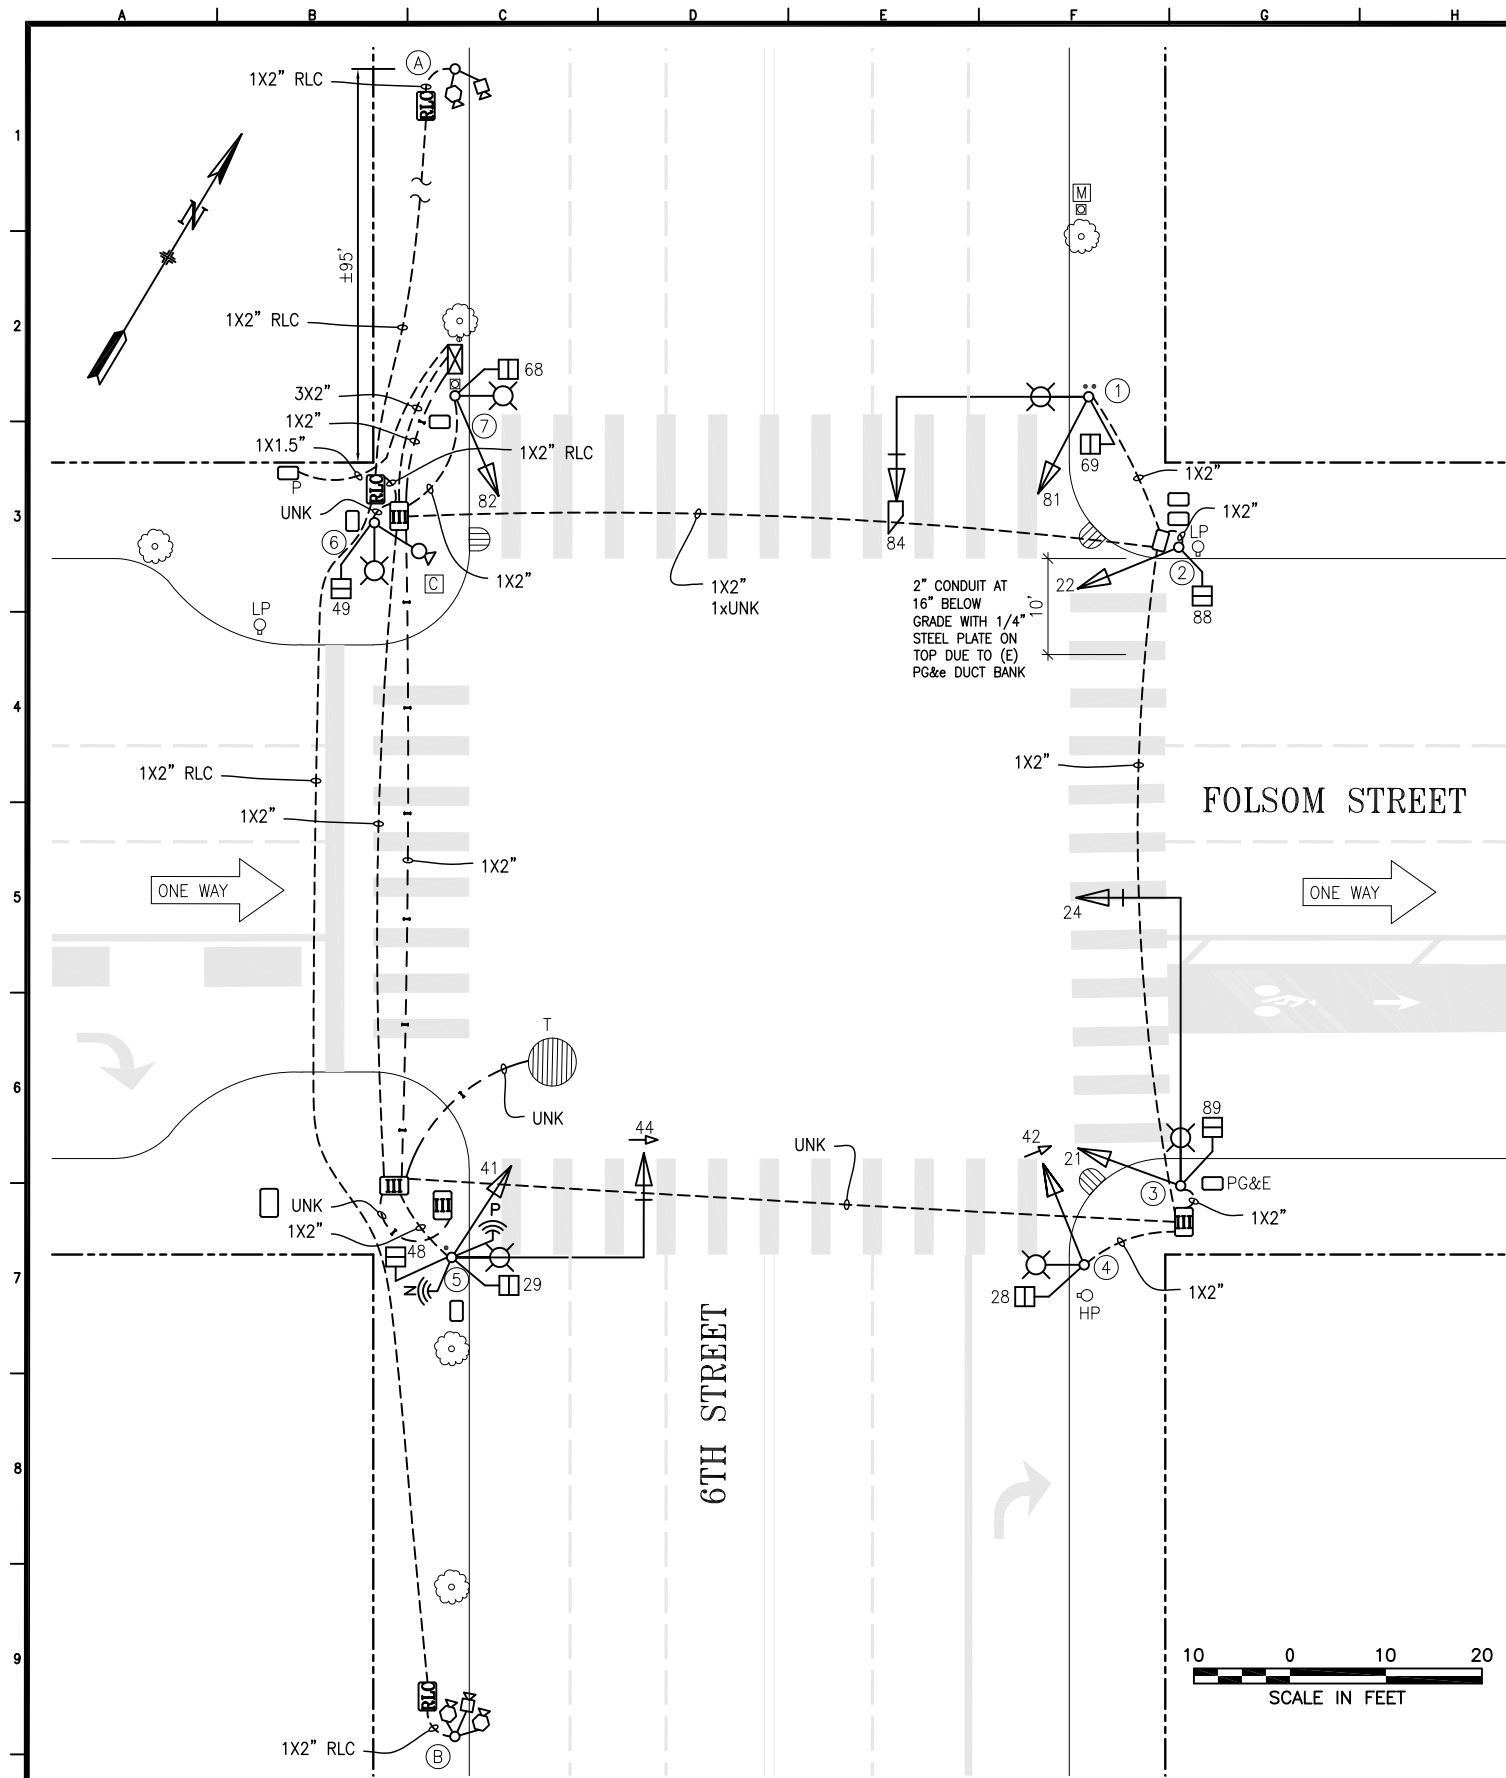

POLE AND EQUIPMENT SCHEDULE											
POLE No.	TYPE OF POLE	LUMINAIRE VOLTAGE/ WATTAGE	VEHICLE SIGNAL					PEDESTRIAN SIGNAL			REMARKS
			No.	TYPE	MOUNTING	VISORS	LOUVERS	No.	TYPE	MOUNTING	
①	17B-1-70 W/ 20' MAST ARM AND 6' LUMINAIRE ARM		81 84	3S12" 3S12"	SV-1-T MAS	T RA		69	1S-COUNT	SP-1	BACKPLATE
②	1-A (10')		22	3S12"	TV-1-T	T		88	1S-COUNT	SP-1	
③	17B-1-70 W/ 20' MAST ARM AND 6' LUMINAIRE ARM		21 24	3S12" 3S12"	SV-1-T MAS	T T		89	1S-COUNT	SP-1	BACKPLATE
④	CITY STANDARD STREET LIGHT		42	PV4S12"GLA	SV-1-T			28	1S-COUNT	SP-1-SF(12")	
⑤	17B-1-70 W/ 20' MAST ARM AND 6' LUMINAIRE ARM		41 44	3S12" 4S12"GLA	SV-1-T MAS	T T		29 48	1S-COUNT 1S-COUNT	SP-1 SP-1	NETWORK RADIO PREEMPT RAIDO BACKPLATE
⑥	CITY STANDARD STREET LIGHT							49	1S-COUNT	SP-1	CCTV CAMERA
⑦	CITY STANDARD STREET LIGHT		82	3S12"	SV-1-T	T		68	1S-COUNT	SP-1	
Ⓐ	REAR RLC POLE (20')										REAR CAMERA STROBE ATS CABINET
Ⓑ	FRONT RLC POLE (15')										FRONT CAMERA STROBE x2 3D RADAR SSCI CTRL BOX

NO.	DATE	DESCRIPTION	BY	APPROVED
4	9/3/22	ADDED CCTV CAMERA (SRC 2022-154)	SAlexander	MVelasco
3	8/23/19	ACTIVATE RLC SYSTEM; CONVERTED FROM 2855J AS-BUILTS; RADIOS PER FIELD	JHornbostel	GdeLeon
2	8/06/13	2543J PUNCHLIST WALKTHRU; UPGRADE 21,22,41,81,&82 TO 12"	DYeung	MVelasco
1	02/99	FOLSOM STREET SIGNAL IMPROVEMENT CT # 1302N	DVCangco	ROlea

TABLE OF REVISIONS
CHECKOUT DRAWING THROUGH THE SID CUSTODIAN FOR THE LATEST REVISION



SFMTA

DRAWN BY:
D.V.Cangco

DATE:
05/01/01

CHECKED BY:
R. OLEA

DATE:
09/10/01

SCALE
AS SHOWN

SHEET OF SHEETS
1 OF 1

TRAFFIC SIGNAL INVENTORY DIAGRAM

6TH ST AND FOLSOM ST

CNN NO:
23941000

REV NO:
4