


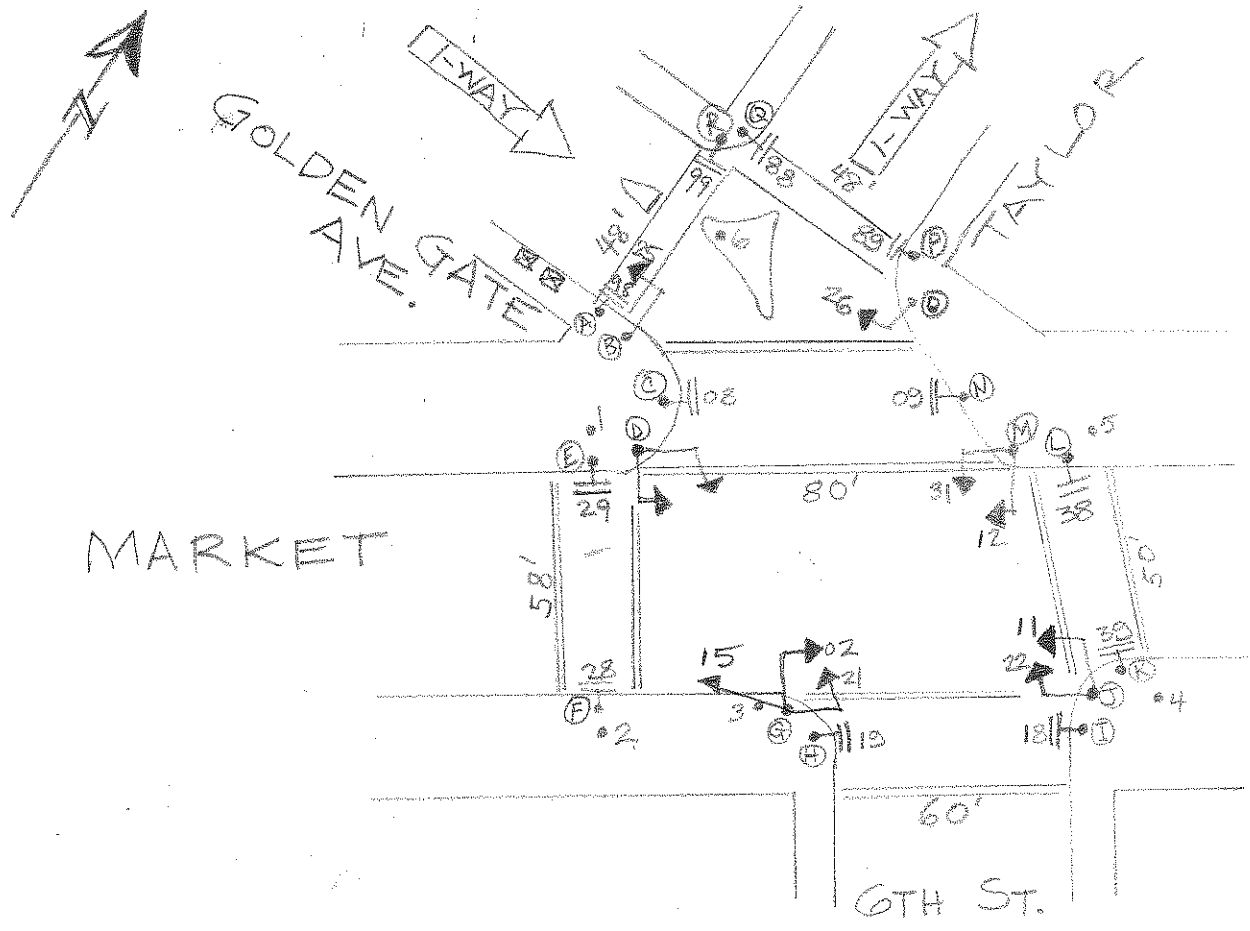

9-23-09

[illegible]

COMMENTS: * MARKET STREET MASTARM SIGNALS
SRC 09-183 TO INSTALL SIGNAL 15 - R OLEA