



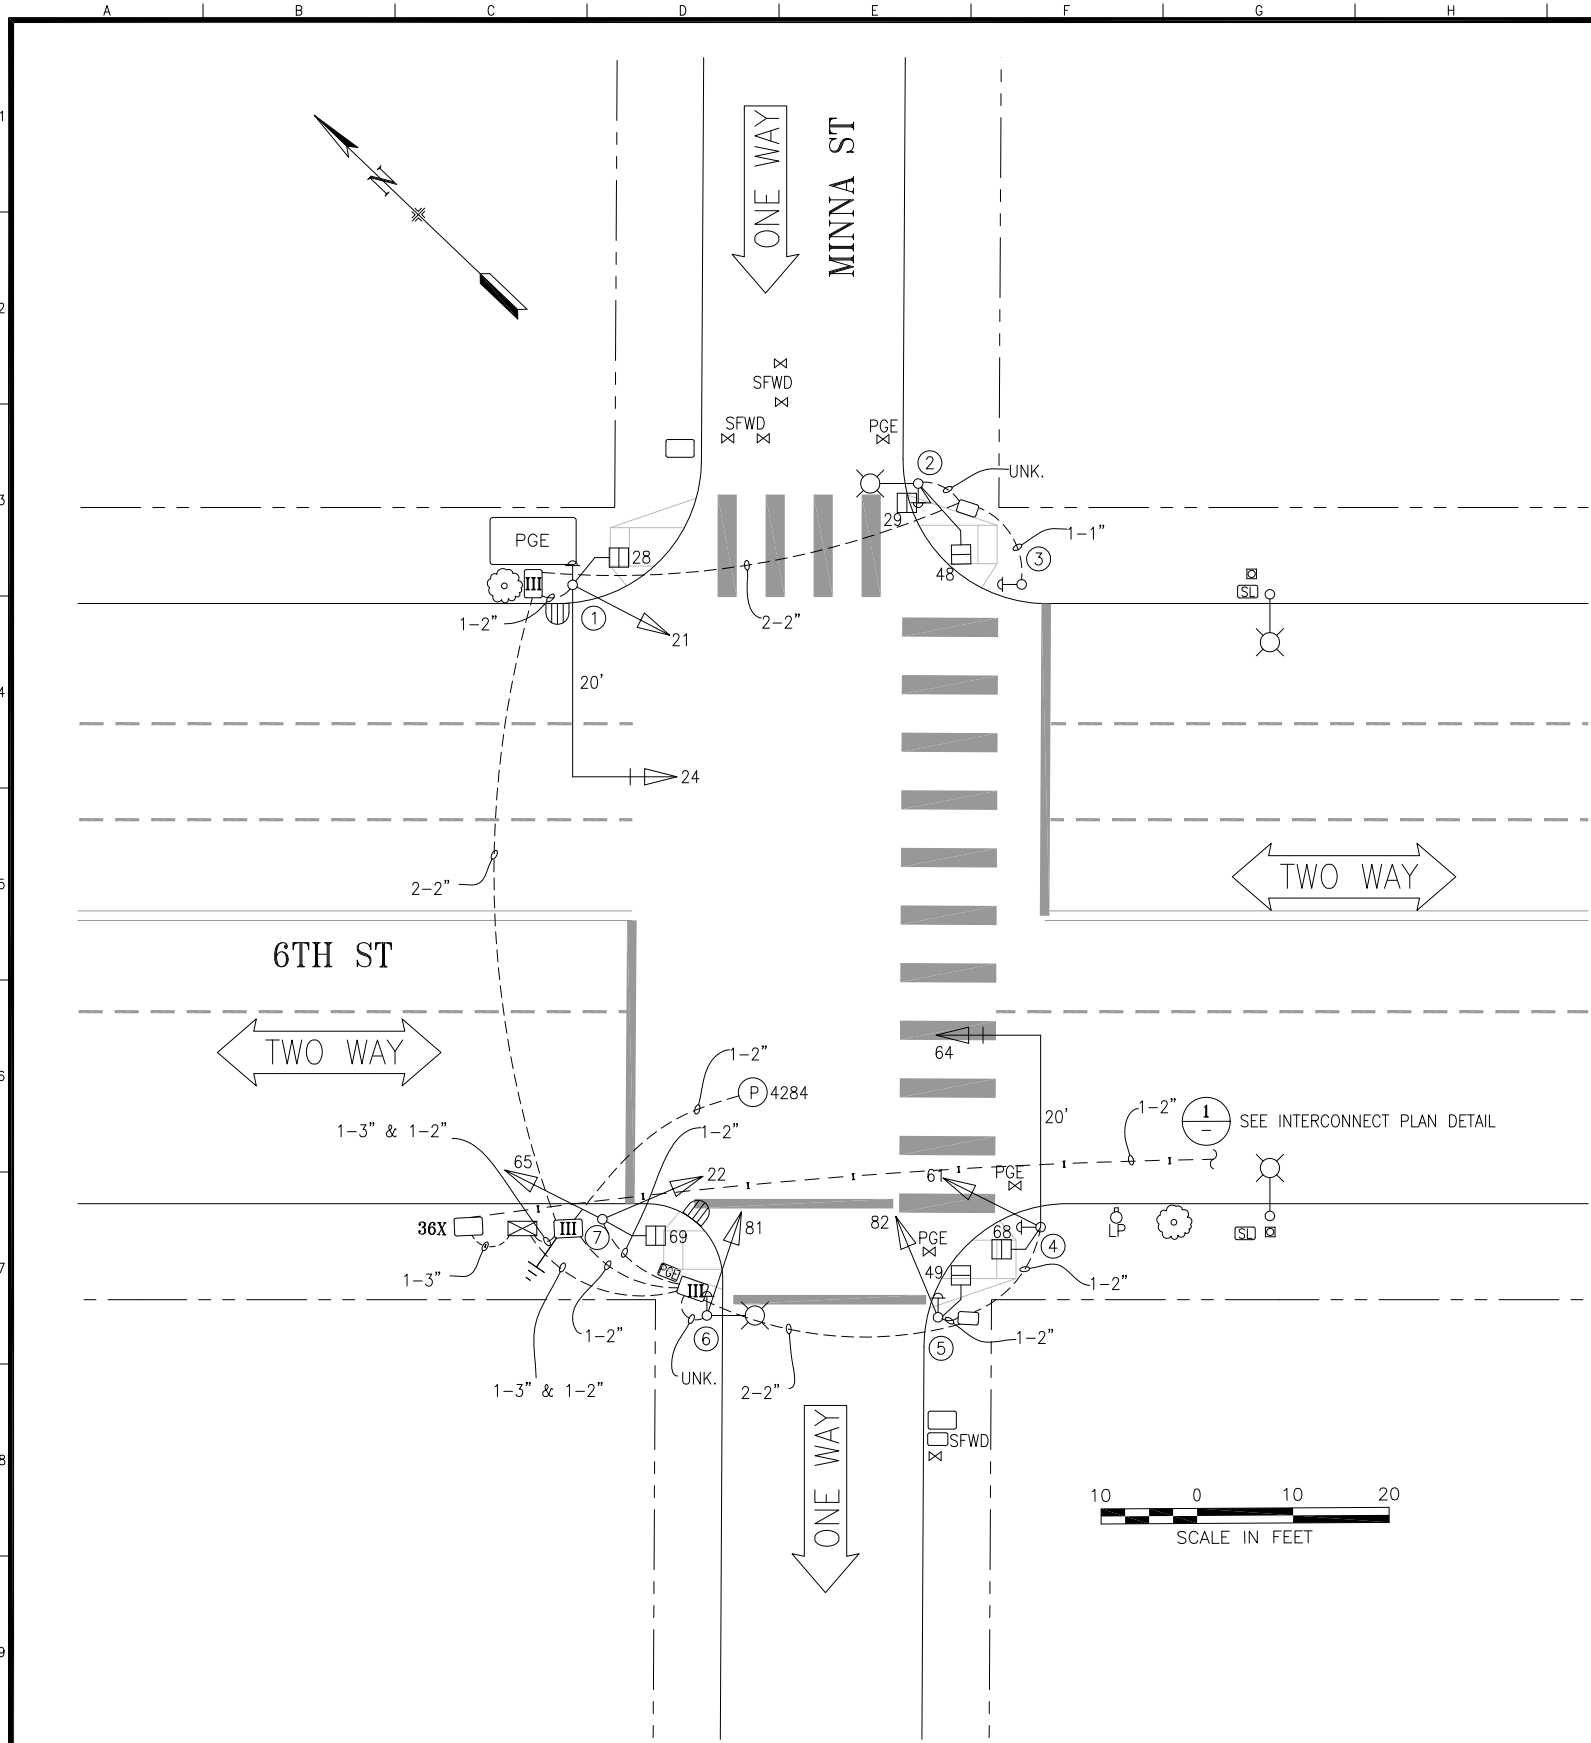

POLE AND EQUIPMENT SCHEDULE											
POLE No.	TYPE OF POLE	LUMINAIRE VOLTAGE/ WATTAGE	VEHICLE SIGNAL					PEDESTRIAN SIGNAL			REMARKS
			No.	TYPE	MOUNTING	VISORS	LOUVERS	No.	TYPE	MOUNTING	
①	16-2-100 WITH 20' MAST ARM		21 24	3S12" 3S12"	SV-1-T MAS	T T		28	1S-COUNT	SP-1	APS BACKPLATE
②	CITY STANDARD STREETLIGHT							48 29	1S-COUNT 1S-COUNT	SP-1 (22") SP-1-SF	APS
③	PPBP										APS
④	16-2-100 WITH 20' MAST ARM		61 64	3S12" 3S12"	SV-1-T MAS	T T		68	1S-COUNT	SP-1	APS BACKPLATE
⑤	1-A (10')		82	3S12"	TV-1-T	T		49	1S-COUNT	SP-1	APS
⑥	CITY STANDARD STREETLIGHT		81	3S12"	SV-1-T	T					APS
⑦	1-A (10')		22 65	3S12" 3S12"	TV-2-T	T T		69	1S-COUNT	SP-1	

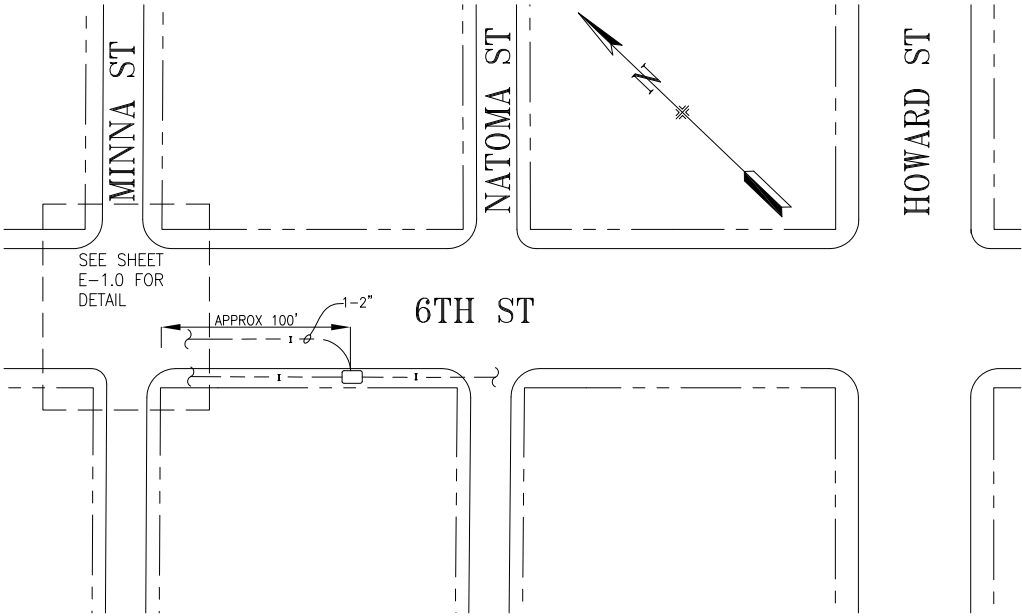

INTERCONNECT PLAN DETAIL
NOT TO SCALE

TABLE OF REVISIONS		CHECK WITH TRACING TO SEE IF YOU HAVE LATEST REVISION	
NO.	DATE	DESCRIPTION	BY APP.
0	10/30/14	ACTIVATED THRU 2246J; CONVERTED FROM CONTRACT PLANS	JH MV

REFERENCE INFORMATION & FILE NO. OF SURVEYS



SAN FRANCISCO MUNICIPAL TRANSPORTATION AGENCY
CITY AND COUNTY OF SAN FRANCISCO

DRAWN:	DATE:
JH	08/15
CHECKED:	DATE:
MV	08/15

SCALE:
AS SHOWN
SHEET OF SHEETS
1 OF 1

TRAFFIC SIGNAL INVENTORY DIAGRAM
6TH STREET AND MINNA STREET

CNN NO.
24285000
REV NO.
0