


POLE AND EQUIPMENT SCHEDULE											
POLE No.	TYPE OF POLE	LUMINAIRE VOLTAGE/ WATTAGE	VEHICLE SIGNAL					PEDESTRIAN SIGNAL			REMARKS <div>3</div>
			No.	TYPE	MOUNTING	VISORS	LOUVERS/BP	No.	TYPE	MOUNTING	
①	1-A (10')		41	3S12"	TV-1-T	T		48	1S-COUNT	SP-1	APS 2W
②	STEEL STREET LIGHT (28.5') W/ 6' LUMINAIRE ARM	<div>A57</div>	25 62	3S12" 3S12"	SV-2-TA	T T		29	1S-COUNT	SP-1	APS 2W
③	17-2-100 WITH 20' MAST ARM, 6' LUMINAIRE ARM	<div>A57</div>	61 64	3S12" 3S12"	SV-1-T MAC	T T	BP				APS 2W
④	1-A (10')							49 68	1S-COUNT 1S-COUNT	SP-1 SP-1	APS 2W POLE CAP
⑤	STEEL STREET LIGHT (28.5') W/ 6' LUMINAIRE ARM	<div>B108</div>						88	1S-COUNT	SP-1	APS 2W
⑥	1-A (10')		22 65	3S12" 3S12"	TV-2-T	T T		69	1S-COUNT	SP-1	APS 2W
⑦	17-2-100 W/20' MAST ARM & 6' LUMINAIRE ARM	<div>A57</div>	21 24	3S12" 3S12"	SV-1-T MAC	T T	BP	28	1S-COUNT	SP-1	APS 2W <div>2</div>
⑧	STEEL STREET LIGHT (28.5') W/ 6' LUMINAIRE ARM	<div>B108</div>	42	3S12"	SV-1-T	T		89	1S-COUNT	SP-1	APS 2W <div>2</div>

SHEET NOTES

- ① NEW CONTROLLER SERVICE POINT IS A MANHOLE LOCATED NEAR THE SOUTHEAST CORNER. COORDINATE WITH PG&E THROUGH SFPUC FOR SERVICE ACTIVATION. PROVIDE 60 DAYS NOTICE. REFER TO PG&E CONSTRUCTION SKETCH.
- ② SPECIAL FOUNDATION. SEE STRUCTURAL DRAWINGS.
- ③ CONTRACTOR TO INSTALL APS WIRING, CITY FORCES TO INSTALL APS BUTTONS PER ADA REQUIREMENTS.
- ④ ABANDON (E) SL CONDUIT AND WIRING. SEE GENERAL NOTE 21.

PHASE DIAGRAM

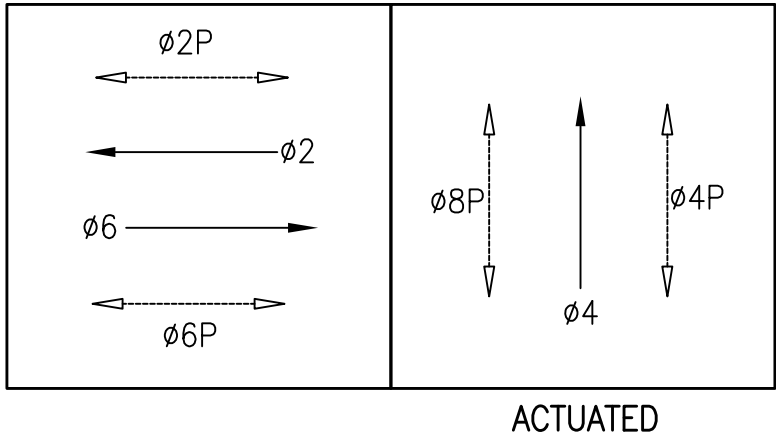

SIGNAL FLASH Wednesday, 11/08/2023 11:03 AM
Daniel Carr (MTA)
Marcus Todd, Trevor Pettigrew (MTA)
Dennis Tse (Bay Area Light Works)

SIGNAL 3-COLOR Friday, 11/10/2023 9:50 AM
Marcus Todd, Trevor Pettigrew (MTA)

1/13/2021

NO.	DATE	DESCRIPTION	BY	APP.
①	10/06/2022	RELOCATED POLE 4; MOVED SIGNAL 68 FROM POLE 3 TO POLE 4	DR	
TABLE OF REVISIONS				


REFERENCE INFORMATION
& FILE NO. OF SURVEYS



BUREAU OF ENGINEERING
CITY & COUNTY OF SAN FRANCISCO
SAN FRANCISCO PUBLIC WORKS
49 SOUTH VAN NESS AVENUE, 8TH FLOOR
SAN FRANCISCO, CA 94103

Acting Section Mgr:	CHI IAO
Acting Deputy Bureau Mgr:	LESLEY WONG
Acting Bureau Mgr:	IQBAL DHAPA

DESIGNED:	DATE:
DC/GL	09/2019
DRAWN:	DATE:
DC/GL	09/2019
CHECKED:	DATE:
SL/KL	03/2020

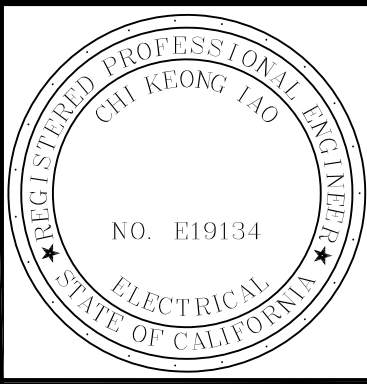

SCALE:
AS SHOWN
SHEET OF SHEETS
186 OF 212

6TH STREET PEDESTRIAN SAFETY PROJECT
TRAFFIC SIGNAL 6TH STREET AND STEVENSON STREET POLE AND EQUIPMENT WORK


CONTRACT NO. 1000015023(R)
DRAWING NO. ET-1.0
FILE NO. 116,538
REV. NO. 1

CONDUIT AND WIRING SCHEDULE (FURNISH AND INSTALL CONDUIT AND WIRES)																																														
CONDUIT RUN NUMBER		1	2	3	4	5	6	7	8	9	10	11	12	13	14	15	16	17	18	19		20	21	22	23	24	25	26	27	28		29	30	31	32	33	34	35	36	37	38		39	40	41	42
CONDUIT SIZE (INCH)		2	2	2	2	2	2	2	2	2	2	2	2	2	2	2	3	2	3	2		2	2	2	2	2	2	2	2	2		2	2	2	2	2	2	2	2	2	2	2	3	2		
					SP				SP	SP	GRS	GRS	GRS	GRS	GRS			SP		SP		GRS	GRS	GRS	GRS	GRS	GRS	GRS	GRS	GRS																
NOTES													SP																																	
	VEHICLE SIGNAL 22	3		3				3									3																													
	VEHICLE SIGNAL 65	3		3				3									3																													
	PED SIGNAL 69	2		2				2									2																													
	APS PPB XING 6TH ON POLE 6	2		2				2									2																													
	PED SIGNAL 88		2	2				2									2																													
	APS PPB XING STEVENSON ON POLE 5		2	2				2									2																													
	PED SIGNAL 49					2		2									2																													
	APS PPB XING STEVENSON ON POLE 4					2		2									2																													
	VEHICLE SIGNAL 64							3	3								3																													
①	VEHICLE SIGNAL 61							3	3								3																													
	PED SIGNAL 68					2		2									2																													
	APS PPB XING 6TH ON POLE 3							2	2								2																													
	VEHICLE SIGNAL 21											2		2					2																											
	VEHICLE SIGNAL 24											2		2					2																											
	PED SIGNAL 28											2		2					2																											
	APS PPB XING 6TH ON POLE 7											2		2					2																											
	VEHICLE SIGNAL 42												3	3					3																											
	PED SIGNAL 89												2	2					2																											
	APS PPB XING STEVENSON ON POLE 8												2	2					2																											
	VEHICLE SIGNAL 41															3			3																											
	PED SIGNAL 48															2			2																											
	APS PPB XING STEVENSON ON POLE 1															2			2																											
	VEHICLE SIGNAL 25																3		3																											
	VEHICLE SIGNAL 62																3		3																											
	PED SIGNAL 29																2		2																											
	APS PPB XING 6TH ON POLE 2																2		2																											
	#14 NEUTRAL	2	1			1	3					3	2			2	2																													
	#14 SPARE			3				3						3			3		3																											
	TOTAL #14 WIRES	12	5	17		5	13	31			11	9	18		9	12	31		35																											
	#10 WIRES NEUTRAL			1				2					1				2		2																											
	#10 WIRES STREET LIGHT																						2			2			2		2	2														
	#8 WIRES STREET LIGHT																																													
	#8 WIRES (120V SL SERVICE)																																													
	#8 WIRES (120V TS SERVICE)																																													
	#8 WIRES (120/240V SERVICE)																																													
	#6 BSCW (SEE GENERAL NOTE 10)																																													

REFERENCE INFORMATION & FILE NO. OF SURVEYS



		Date:
Acting Section Mgr:	CHI IAO	
Acting Deputy Bureau Mgr:	LESLEY WONG	
Acting Bureau Mgr:	IQBAL DHAPA	

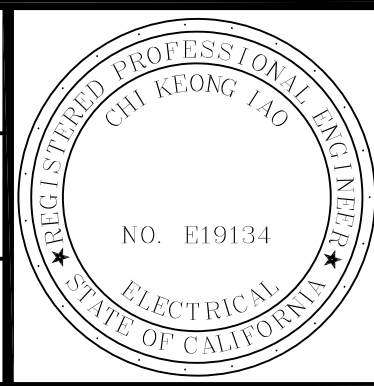

6TH STREET PEDESTRIAN SAFETY PROJECT	CONTRACT NO. 1000015023(R)
	DRAWING NO. ET-1.1
TRAFFIC SIGNAL 6TH STREET AND STEVENSON STREET CONDUIT AND WIRING SCHEDULE	FILE NO. 116,539
	REV. NO. 1