


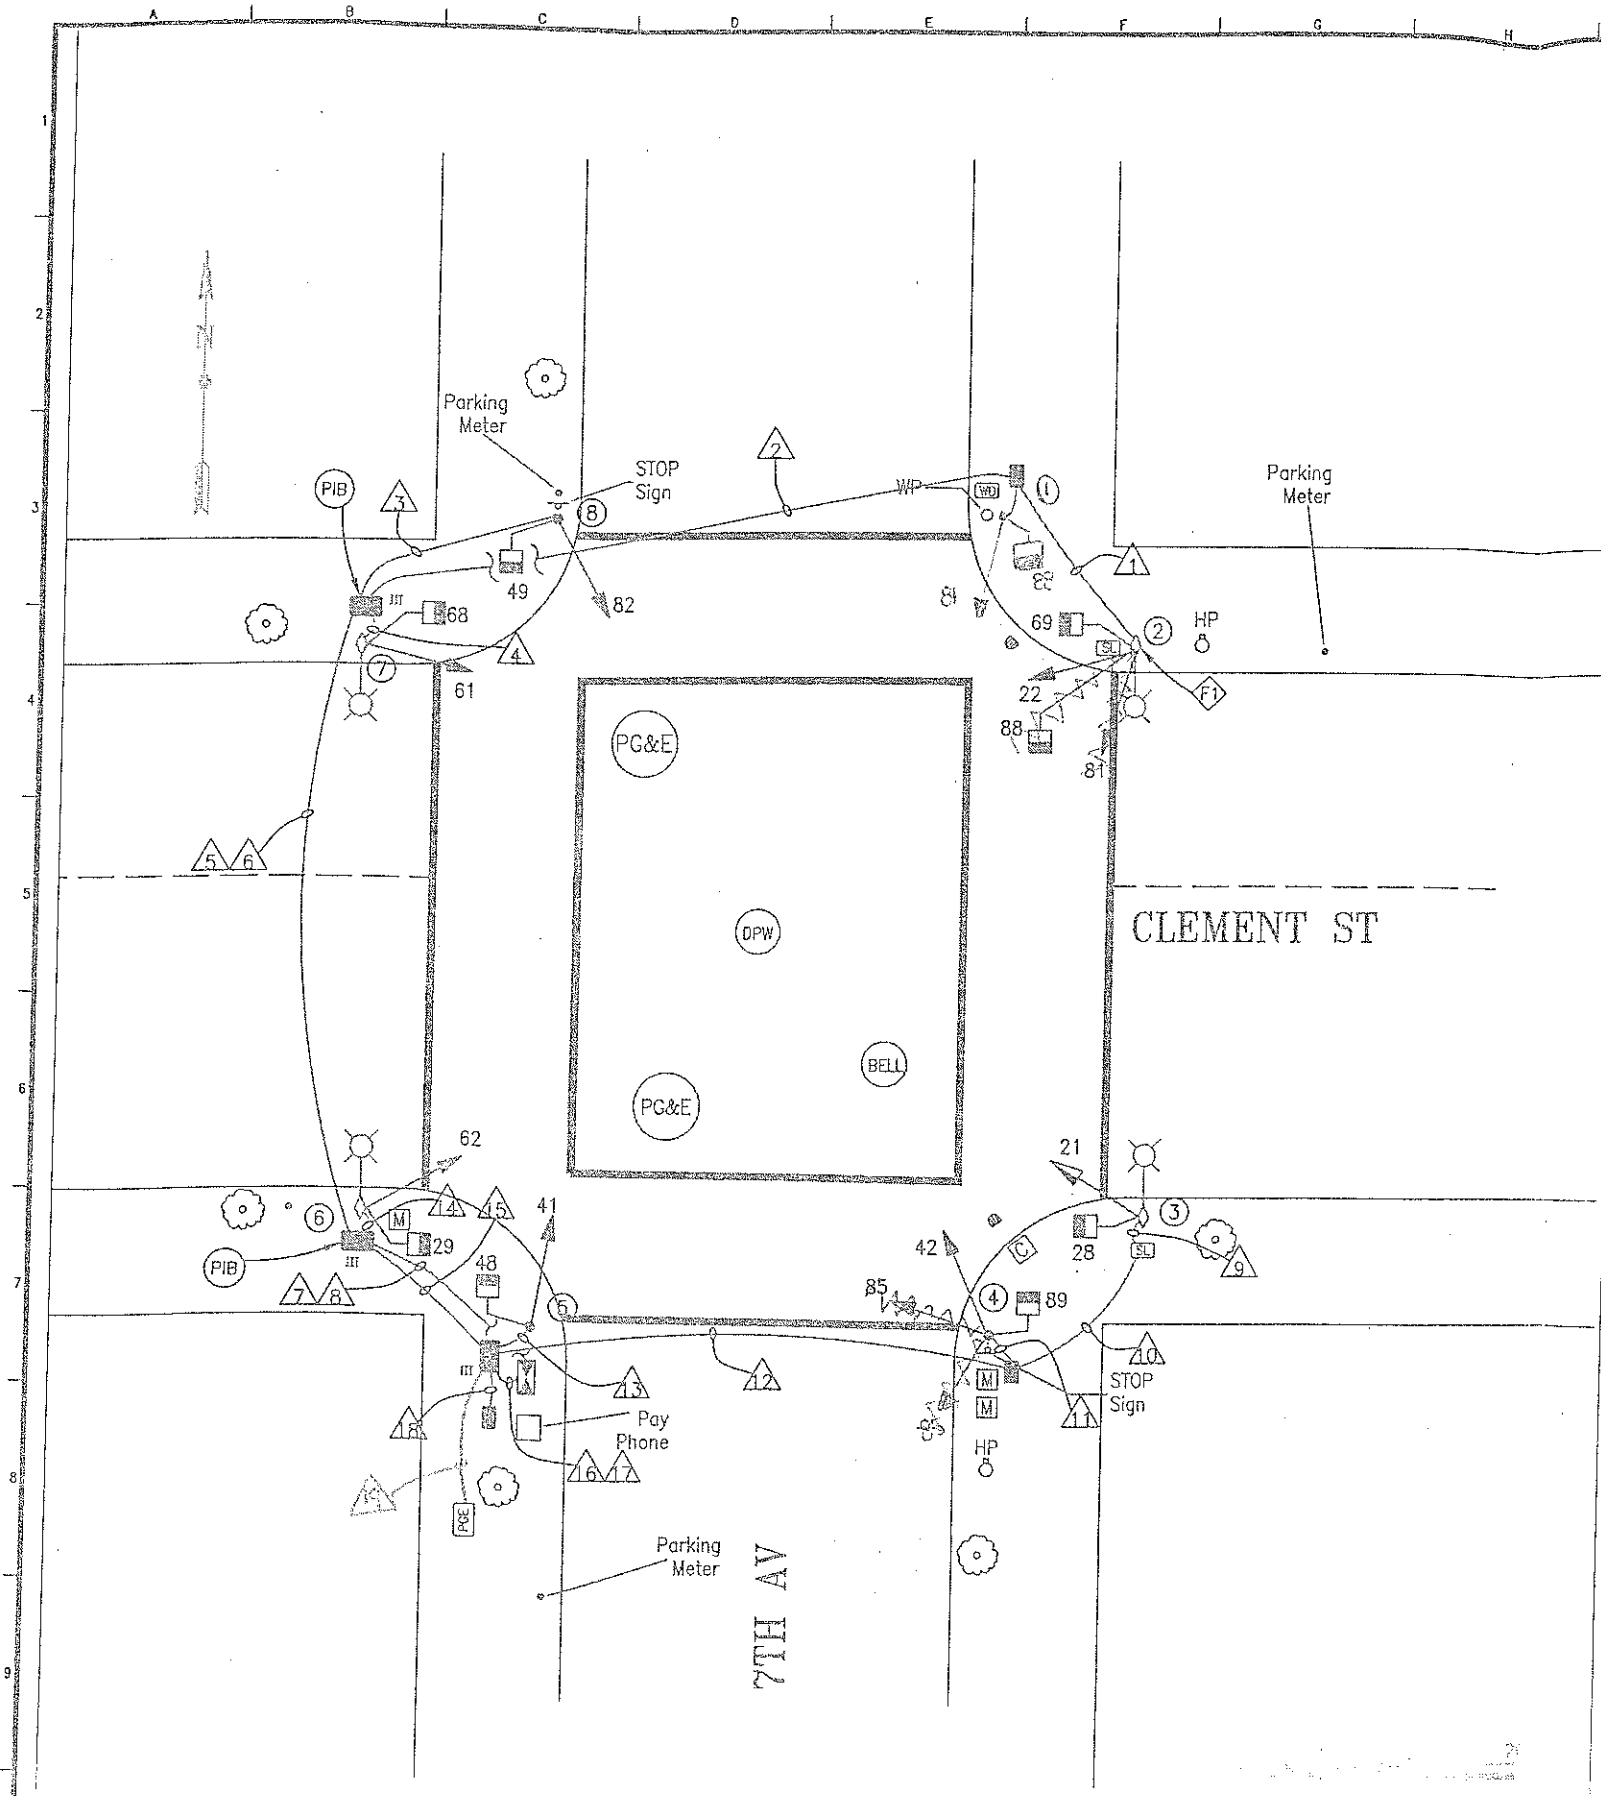

POLE AND EQUIPMENT SCHEDULE										
POLE No.	TYPE OF POLE	VEHICLE SIGNAL					PEDESTRIAN SIGNAL			REMARKS
		No.	TYPE	MOUNTING	VISORS	LOUVERS	No.	TYPE	MOUNTING	
①	NOT-USED 1-A (10')	81	3S8"	TV-1	T		88	1S-COUNT	SP-1	
②	EX. MUNI POLE w/SL	22 84	3S8" 3S8"	SV-1-T SV-2-T=SP	T		69 88	1S-COUNT 1S-COUNT	SP-1 (22") SP-1-SF SP-1-SF SP-1-SF (12")	
③	EX. MUNI POLE w/SL	21	3S12"	SV-1-T	T		28	1S-COUNT	SP-1	
④	1-A (10')	42 85	3S8" 3S8"	TV-1 TV-2=T	T		89	1S-COUNT	SP-1	
⑤	1-A (10')	41	3S8"	TV-1	T		48	1S-COUNT	SP-1	
⑥	EX. MUNI POLE w/SL	62	3S8"	SV-1-T	T		29	1S-COUNT	SP-1	
⑦	EX. MUNI POLE w/SL	61	3S8"	SV-1-T	T		68	1S-COUNT	SP-1	
⑧	1-A (10')	82	3S8"	TV-1	T		49	1S-COUNT	SP-1	


SHEET NOTES

VEHICLE SIGNAL SHALL USE NEW EXTERNAL CONDUIT. SURFACE MOUNTED CONDUIT SHALL BE INSTALLED ON THE SIDE OPPOSITE THE ROADWAY OR INTERSECTION.

SIGNALS ACTIVATED WED 1-26-05 1015 (FLASHING YELLOW/RED) < SIGNAL SHOP: WZ, LM
ENGRS: ET, DP

CHANGED FLASH COLOR TO RED/RED FRI 1-28-05 0945
SIGNALS TURN-ON FRI 1-28-05 1005 (3-COLOR) < SIGNAL SHOP: WZ
ENGRS: ET, DP, BMY, JF

PHASE DIAGRAM

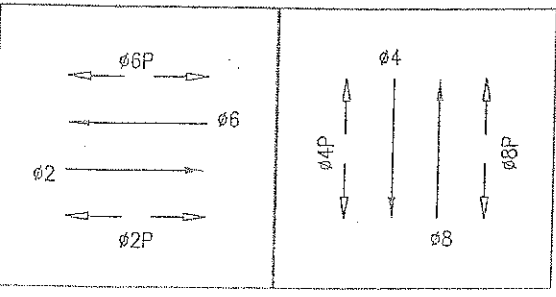

PHASE SEQUENCE

G	Y	R	CLEMENT STREET
R		G	7TH AVENUE
WM	FRH	RH	PED XING 7TH AVENUE
RH	WM	FRH	PED XING CLEMENT STREET

NO.	DATE	DESCRIPTION	BY	APP.
TABLE OF REVISIONS				
CHECK WITH TRACING TO SEE IF YOU HAVE LATEST REVISION				

REFERENCE INFORMATION
& FILE NO. OF SURVEYS



BUREAU OF ENGINEERING
DEPARTMENT OF PUBLIC WORKS
CITY AND COUNTY OF SAN FRANCISCO


DESIGNED: DATE:	APPROVED:	SCALE:
DRC/EF/WN 5/04		1" = 10'
DRAWN: DATE:	SECTION MANAGER DATE:	
DRC/EF/WN 5/04		
CHECKED: DATE:	DEPUTY BUREAU MANAGER DATE:	SHEET OF SHEETS
BC 5/04		1 of 2
	CITY ENGINEER DATE:	

CONTRACT 55
NEW TRAFFIC SIGNALS
SEVENTH AVENUE
SEVENTH STREET & CLEMENT STREET

SPECIFICATION NO.	0494J
DRAWING NO.	E-8.0
FILE NO.	
REV. NO.	

Dimension Scale: 10
Model Units: Undefined

Plotting Path: V:\0494J\CT55\PCO-0494J.E0.0 & EB.1_PCO-0494J.L0.0
Plot Time: Thu, 20 May 2004 - 3:12pm

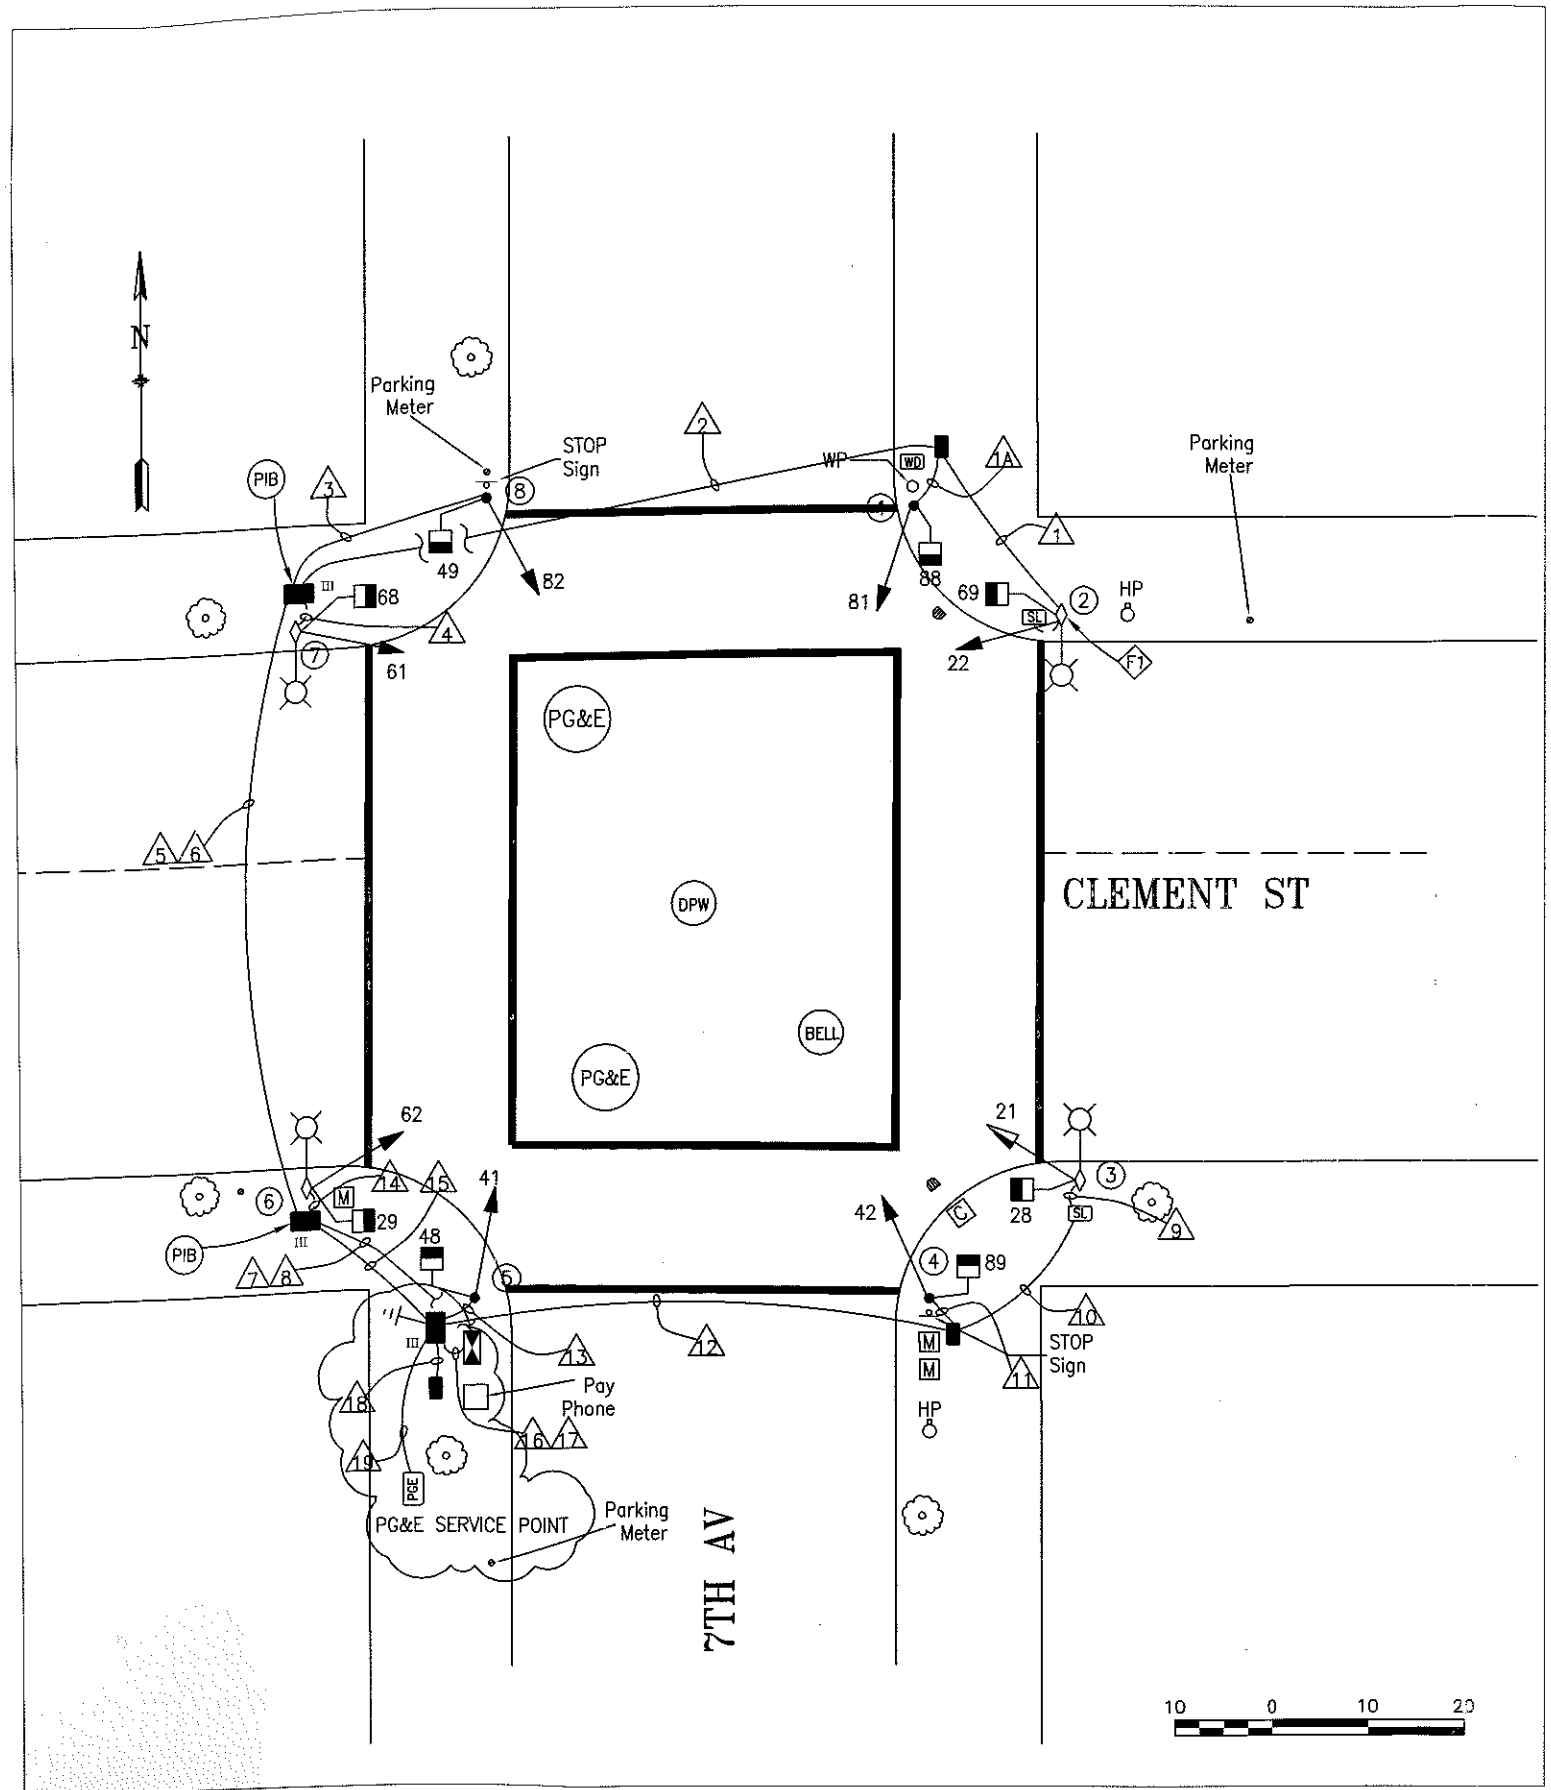


POLE AND EQUIPMENT SCHEDULE									
POLE No.	TYPE OF POLE	VEHICLE SIGNAL					PEDESTRIAN SIGNAL		
		No.	TYPE	MOUNTING	VISORS	LOUVERS	No.	TYPE	MOUNTING
①	1-A (10')	81	3S8"	TV-1	T		88	1S-COUNT	SP-1
②	EX. MUNI POLE w/SL	22	3S8"	SV-1-T	T		69	1S-COUNT	SP-1
③	EX. MUNI POLE w/SL	21	3S12"	SV-1-T	T		28	1S-COUNT	SP-1
④	1-A (10')	42	3S8"	TV-1	T		89	1S-COUNT	SP-1
⑤	1-A (10')	41	3S8"	TV-1	T		48	1S-COUNT	SP-1
⑥	EX. MUNI POLE w/SL	62	3S8"	SV-1-T	T		29	1S-COUNT	SP-1
⑦	EX. MUNI POLE w/SL	61	3S8"	SV-1-T	T		68	1S-COUNT	SP-1
⑧	1-A (10')	82	3S8"	TV-1	T		49	1S-COUNT	SP-1

SHEET NOTES

F1 VEHICLE SIGNAL SHALL USE NEW EXTERNAL CONDUIT. SURFACE MOUNTED CONDUIT SHALL BE INSTALLED ON THE SIDE OPPOSITE THE ROADWAY OR INTERSECTION.

PHASE DIAGRAM

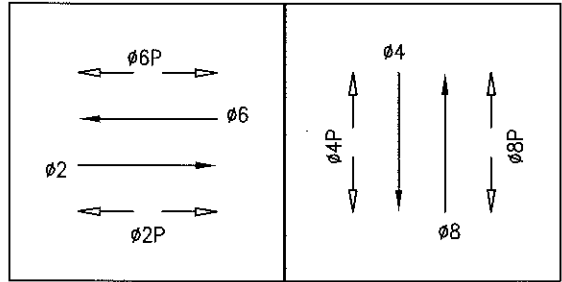

PHASE SEQUENCE

G	Y	R		CLEMENT STREET
R		G	Y	7TH AVENUE
WM	FRH	RH		PED XING 7TH AVENUE
RH		WM	FRH	RH
				PED XING CLEMENT STREET

