


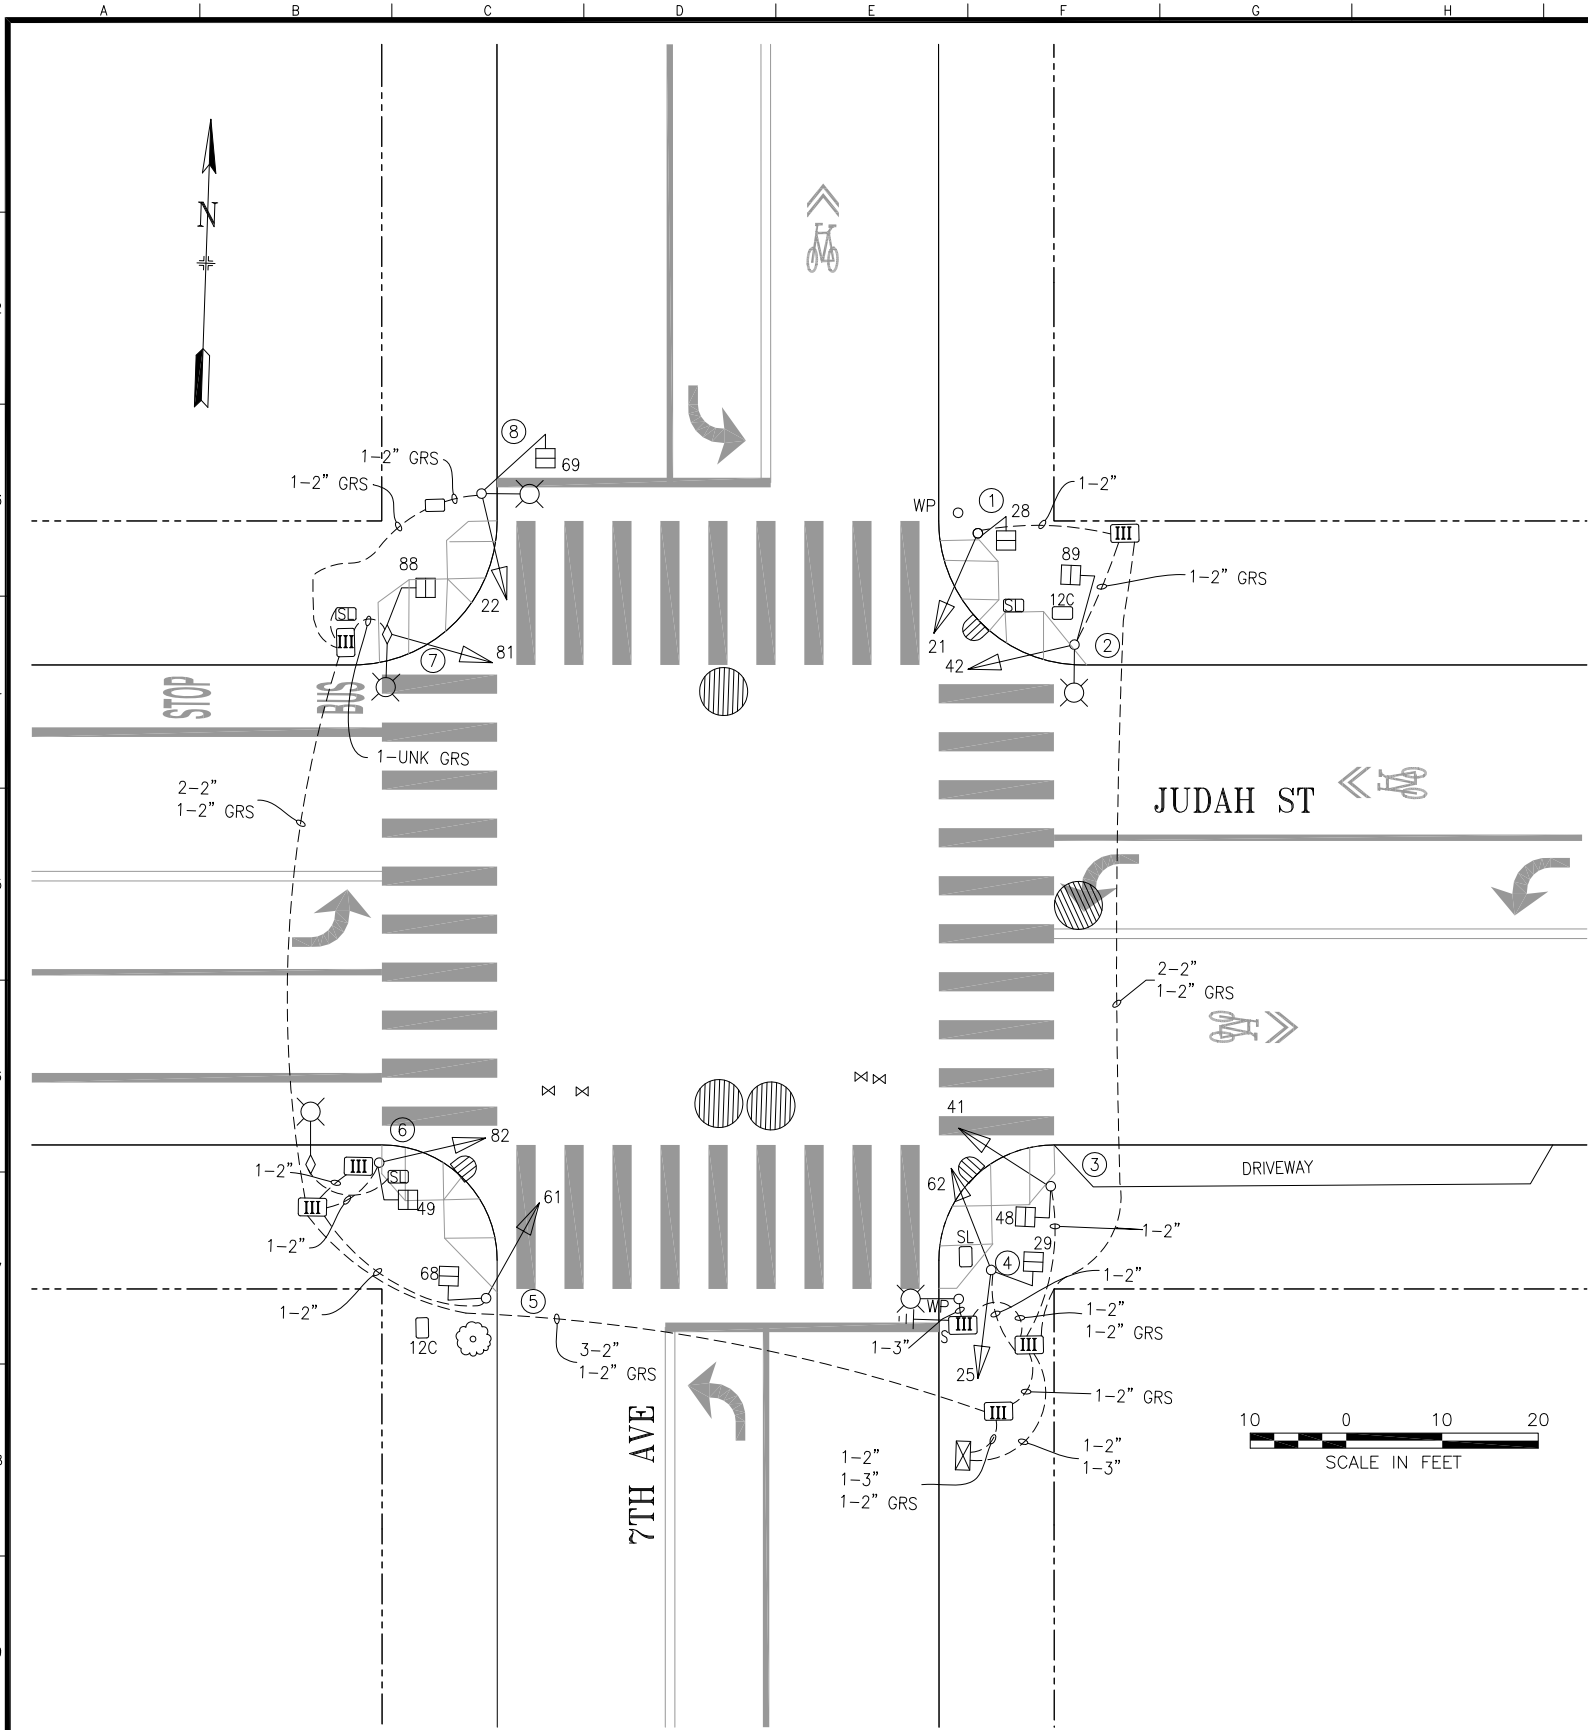

POLE AND EQUIPMENT SCHEDULE											
POLE No.	TYPE OF POLE	LUMINAIRE VOLTAGE/WATTAGE	VEHICLE SIGNAL					PEDESTRIAN SIGNAL			REMARKS
			No.	TYPE	MOUNTING	VISORS	LOUVERS	No.	TYPE	MOUNTING	
①	1-A (10')		21	3S12"	TV-1-T	T		28	1S-COUNT	SP-1	
②	CITY STANDARD STREETLIGHT	150W HPS	42	3S12"	SV-1-T	T		89	1S-COUNT	SP-1	
③	1-A (10')		41	3S12"	TV-1-T	T		48	1S-COUNT	SP-1	
④	1-A (10')		25 62	3S12" 3S12"	TV-2-T-SFA	T T		29	1S-COUNT	SP-1	
⑤	1-A (10')		61	3S12"	TV-1-T	T		68	1S-COUNT	SP-1	
⑥	1-A (10')		82	3S12"	TV-1-T	T		49	1S-COUNT	SP-1	
⑦	MUNI POLE W/ 6' LA		81	3S12"	SV-1-T	T		88	1S-COUNT	SP-1	
⑧	CITY STANDARD STREETLIGHT	150W HPS	22	3S12"	SV-1-T	T		69	1S-COUNT	SP-1	

0	03/15/17	SIGNAL UPGRADED THROUGH 2595J	D.YEUNG	G.DELEON	
NO.	DATE	DESCRIPTION	BY	APP.	
TABLE OF REVISIONS					
CHECK WITH TRACING TO SEE IF YOU HAVE LATEST REVISION					

REFERENCE INFORMATION & FILE NO. OF SURVEYS



SAN FRANCISCO MUNICIPAL TRANSPORTATION AGENCY

CITY AND COUNTY OF SAN FRANCISCO

DRAWN:	DATE:
A.SCALES	5/26/2017
CHECKED:	DATE:
G.DELEON	6/2/2017

SCALE:
AS SHOWN
SHEET OF SHEETS
1 OF 1

TRAFFIC SIGNAL INVENTORY DIAGRAM
7TH AVENUE AND JUDAH STREET

CNN NO.
27143000
REV NO.
0