


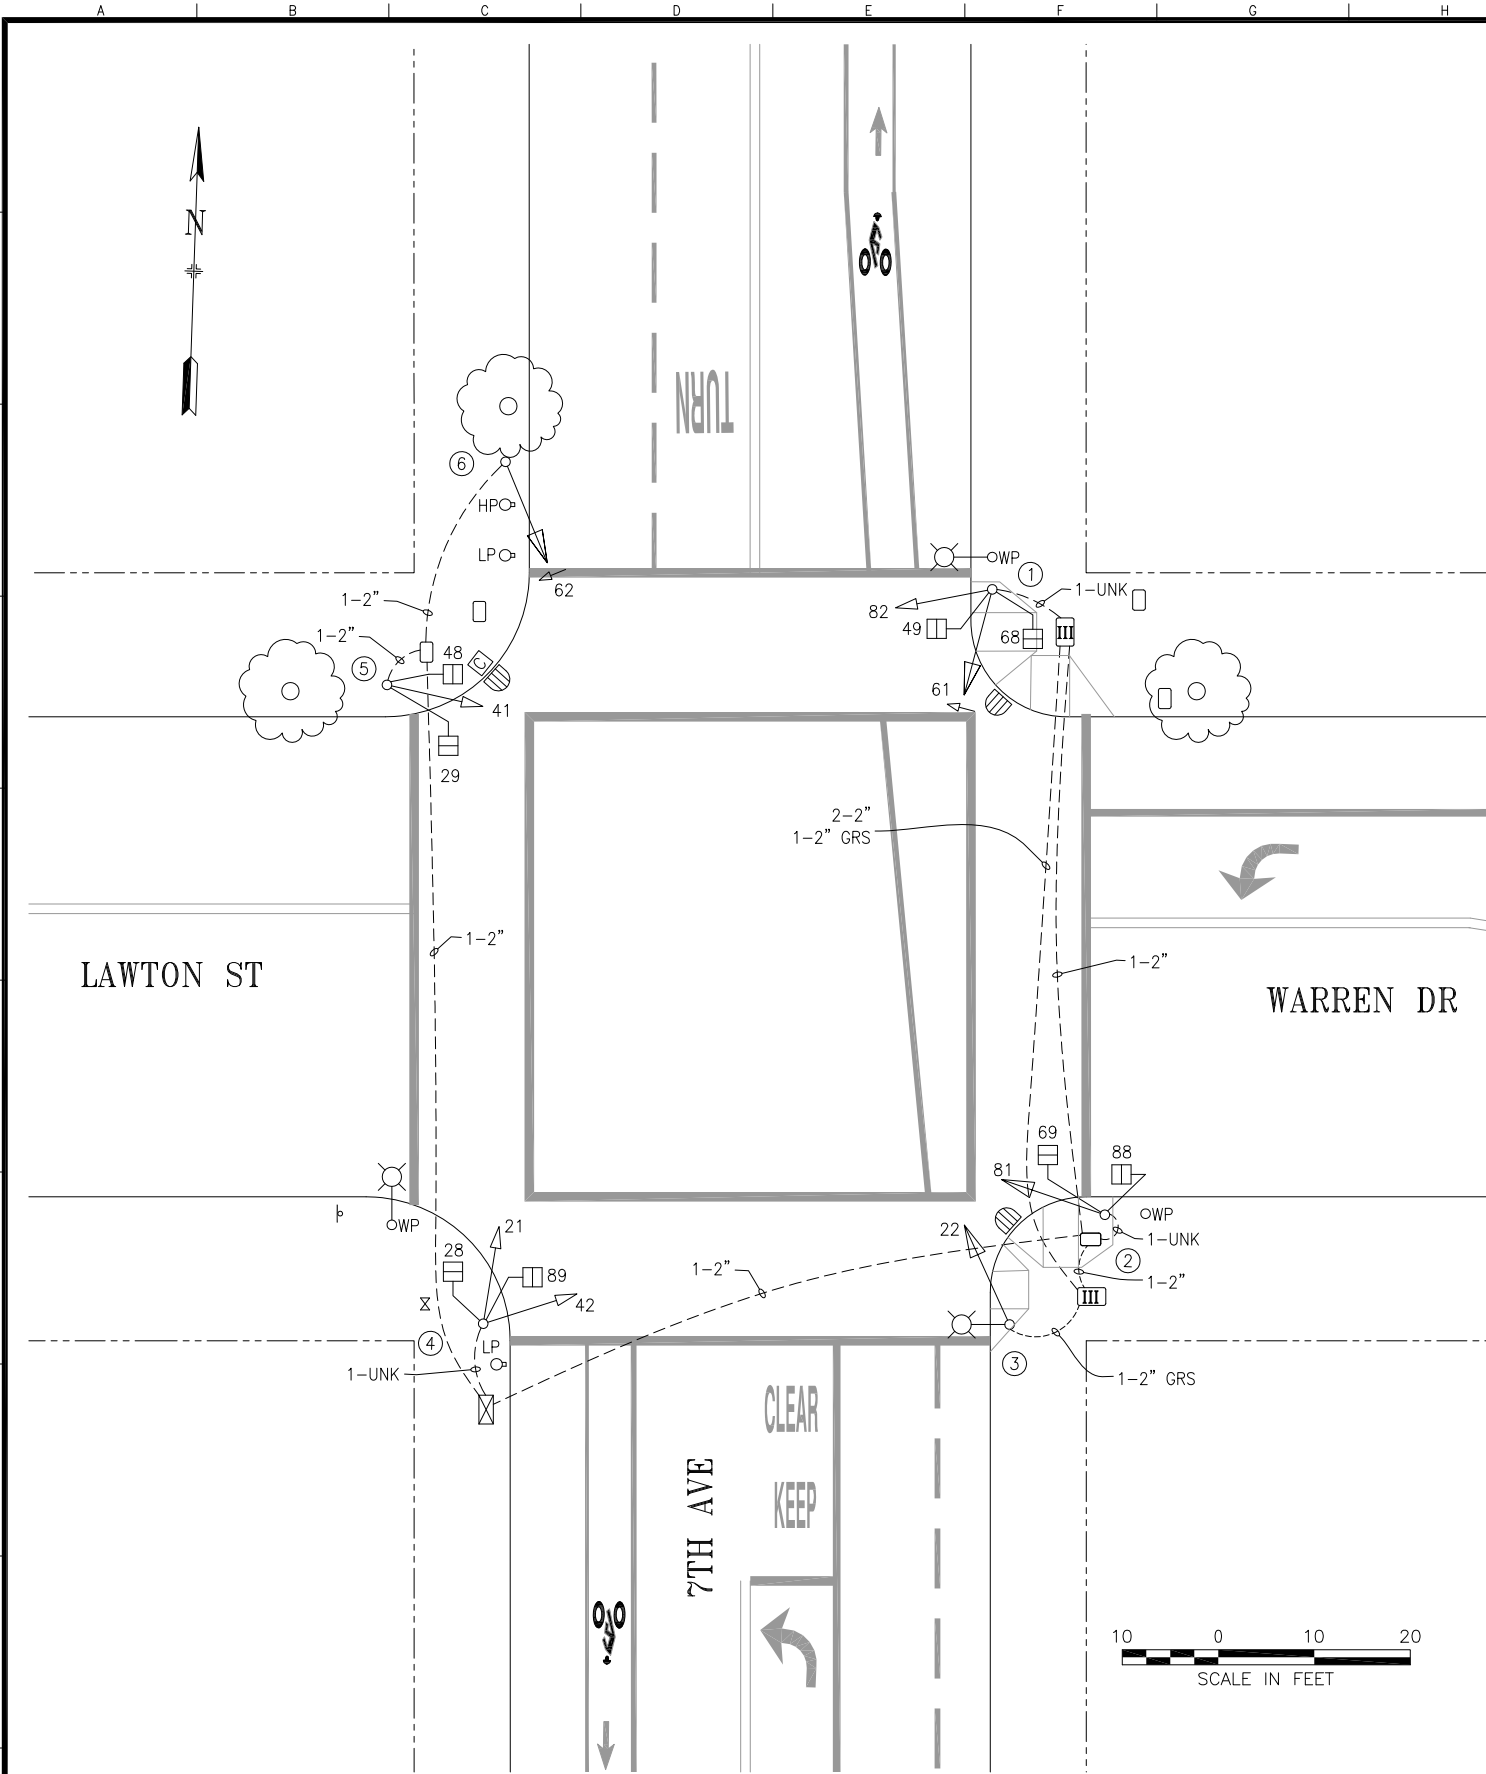

POLE AND EQUIPMENT SCHEDULE											
POLE No.	TYPE OF POLE	LUMINAIRE VOLTAGE/ WATTAGE	VEHICLE SIGNAL					PEDESTRIAN SIGNAL			REMARKS
			No.	TYPE	MOUNTING	VISORS	LOUVERS	No.	TYPE	MOUNTING	
①	1-A (10')		61 82	3S12" 3S8"/ 1S12"GLA	TV-2-T-SF	T T		49 68	1S-COUNT 1S-COUNT	SP-1 SP-1	
②	MARBELITE POLE (10')		81	3S12"	TV-1-T	T		69 88	1S-COUNT 1S-COUNT	SP-1 SP-1	
③	MARBELITE SL POLE		22	3S12"	SV-1-T	T					
④	MARBELITE POLE (10')		21 42	3S8" 3S8"	TV-2-T	T T		28 89	1S-COUNT 1S-COUNT	SP-1 SP-1	
⑤	1-A (10')		41	3S8"	TV-1	T		29 48	1S-COUNT 1S-COUNT	SP-1 SP-1	
⑥	1-A (10')		62	4S12"GLA	TV-1-T	T					

1	2/22/18	PCS XING 7TH AVE; UPGRADE TO MSF & 22/81 TO 12" PER SRC 2017-401	AScales	GDeLeon	
0	9/1/17	SIGNALS PER FIELD CHECK; CONDUITS PER 2821J	DYeung	GDeLeon	
NO.	DATE	DESCRIPTION	BY	APP.	
TABLE OF REVISIONS					
CHECK WITH TRACING TO SEE IF YOU HAVE LATEST REVISION					

REFERENCE INFORMATION & FILE NO. OF SURVEYS



SAN FRANCISCO MUNICIPAL TRANSPORTATION AGENCY

CITY AND COUNTY OF SAN FRANCISCO

DRAWN:	DATE:
AScales	04/09/2018
CHECKED:	DATE:
GDeLeon	04/10/2018

SCALE:
AS SHOWN
SHEET OF SHEETS
1 OF 1

TRAFFIC SIGNAL INVENTORY DIAGRAM
7TH AVENUE, LAWTON STREET, AND WARREN STREET

CNN NO.
27104000
REV NO.
1