


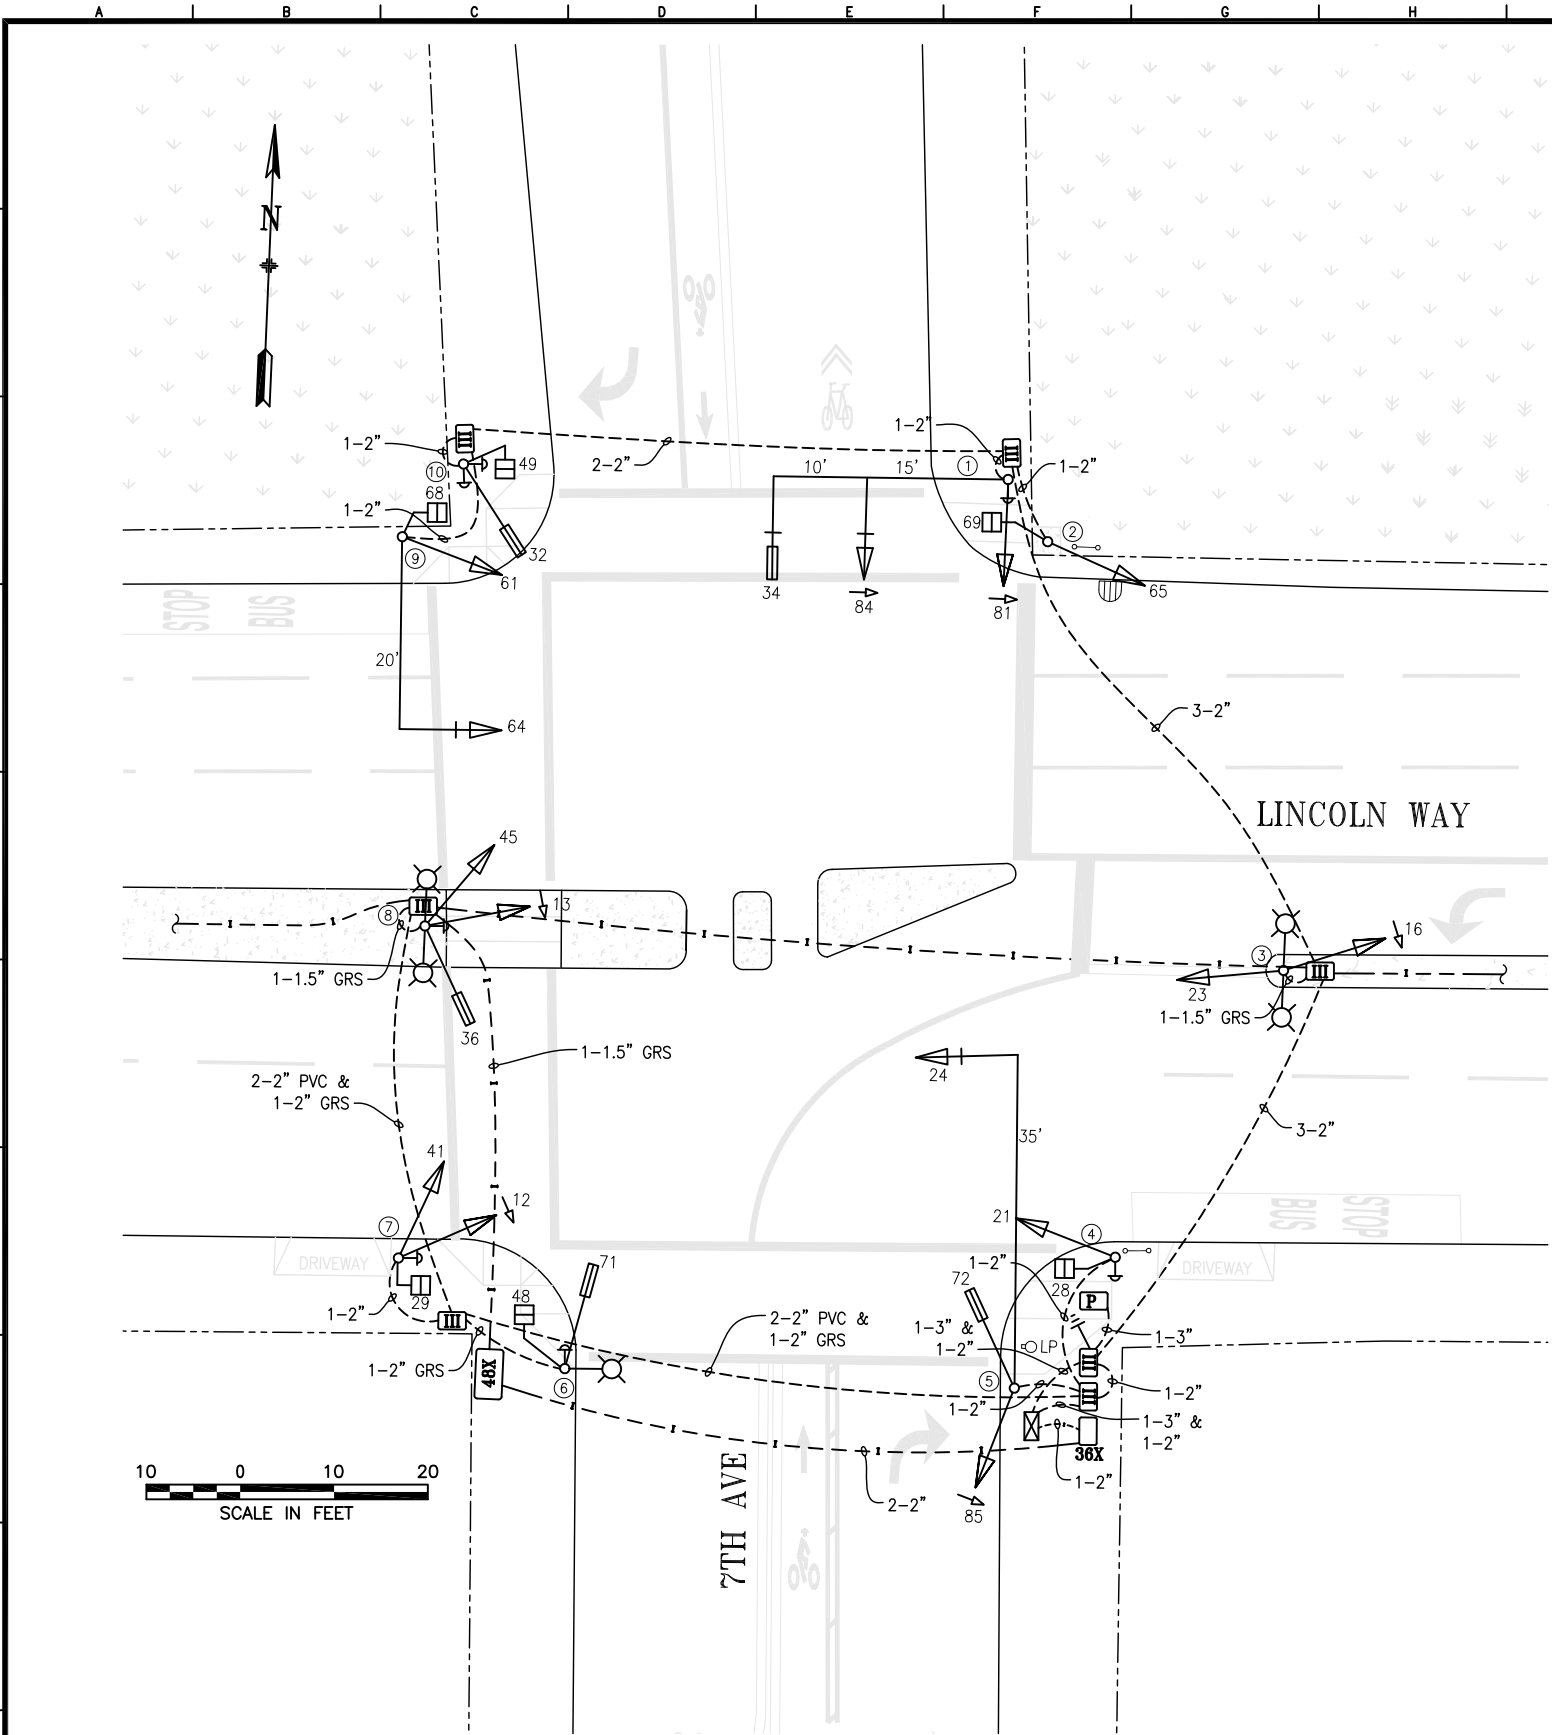

POLE AND EQUIPMENT SCHEDULE											
POLE No.	TYPE OF POLE	LUMINAIRE VOLTAGE/ WATTAGE	VEHICLE SIGNAL					PEDESTRIAN SIGNAL			REMARKS
			No.	TYPE	MOUNTING	VISORS	LOUVERS	No.	TYPE	MOUNTING	
①	18-2-100 W/ 25' MAST ARM		81 84 34	3S12"RA 3S12"RA 3S12" BIKE	SV-1-T MAS MAS	T T T					APS-2W BACKPLATE BACKPLATE
②	1-A (10')		65	3S12"	TV-1-T	T		69	1S-COUNT	SP-1	
③	EX. MARBELITE STREET LIGHT	120V 150W	16 23	3S12"LA 3S12"	SV-1 SV-1	T T					MOUNT 16 @ 4'6"
④	1-A (10')		21	3S12"	TV-1-T	T		28	1S-COUNT	SP-1	APS-2W MOUNT 21 AT 45'
⑤	23-3-100 W/ 35' MAST ARM		24 72 85	3S12" 3S12"BIKE 3S12"RA	MAS SV-2-TA	T T T					BACKPLATE MOUNT 72 & 85 AT 11'
⑥	CITY STANDARD STREET LIGHT	120V 150W	71	3S12" BIKE	SV-1-T	T		48	1S-COUNT	SP-1	APS-2W MOUNT 71 AT 45' AND 11'
⑦	1-A (15')		12 41	3S12"LA 3S12"FY	SV-2-T-SF	T T		29	1S-COUNT	SP-1	APS-2W
⑧	EX. MARBELITE STREET LIGHT	120V 150W	13 36 45	3S12"LA 3S12" BIKE 3S12"FY	SV-3-TA	T T T					APS-2W
⑨	16-2-100 W/ 20' MAST ARM		61 64	3S12" 3S12"	SV-1-T MAS	T T		68	1S-COUNT	SP-1	BACKPLATE
⑩	1-A (10')		32	3S12" BIKE	TV-1-T	T		49	1S-COUNT	SP-1	APS-2W APS-2W

1	6/21/16	SIGNAL UPGRADES ACTIVATED BY 24764; CONVERTED FROM CONTRACT PLANS	JH	GD
0	4/22/11	FO INTERCONNECT BY 10994; CONVERTED FROM AS-BUILTS	JH	GD
NO.	DATE	DESCRIPTION	BY	APP.
TABLE OF REVISIONS				
CHECK WITH TRACING TO SEE IF YOU HAVE LATEST REVISION				

REFERENCE INFORMATION & FILE NO. OF SURVEYS



SAN FRANCISCO MUNICIPAL TRANSPORTATION AGENCY
CITY AND COUNTY OF SAN FRANCISCO

DRAWN:	DATE:
JH	10/17
CHECKED:	DATE:
GD	10/17

SCALE:
AS SHOWN
SHEET OF SHEETS
01 OF 01

TRAFFIC SIGNAL INVENTORY DIAGRAM
7TH AVENUE AND LINCOLN WAY

CNN NO.
33561000
REV NO.
1