


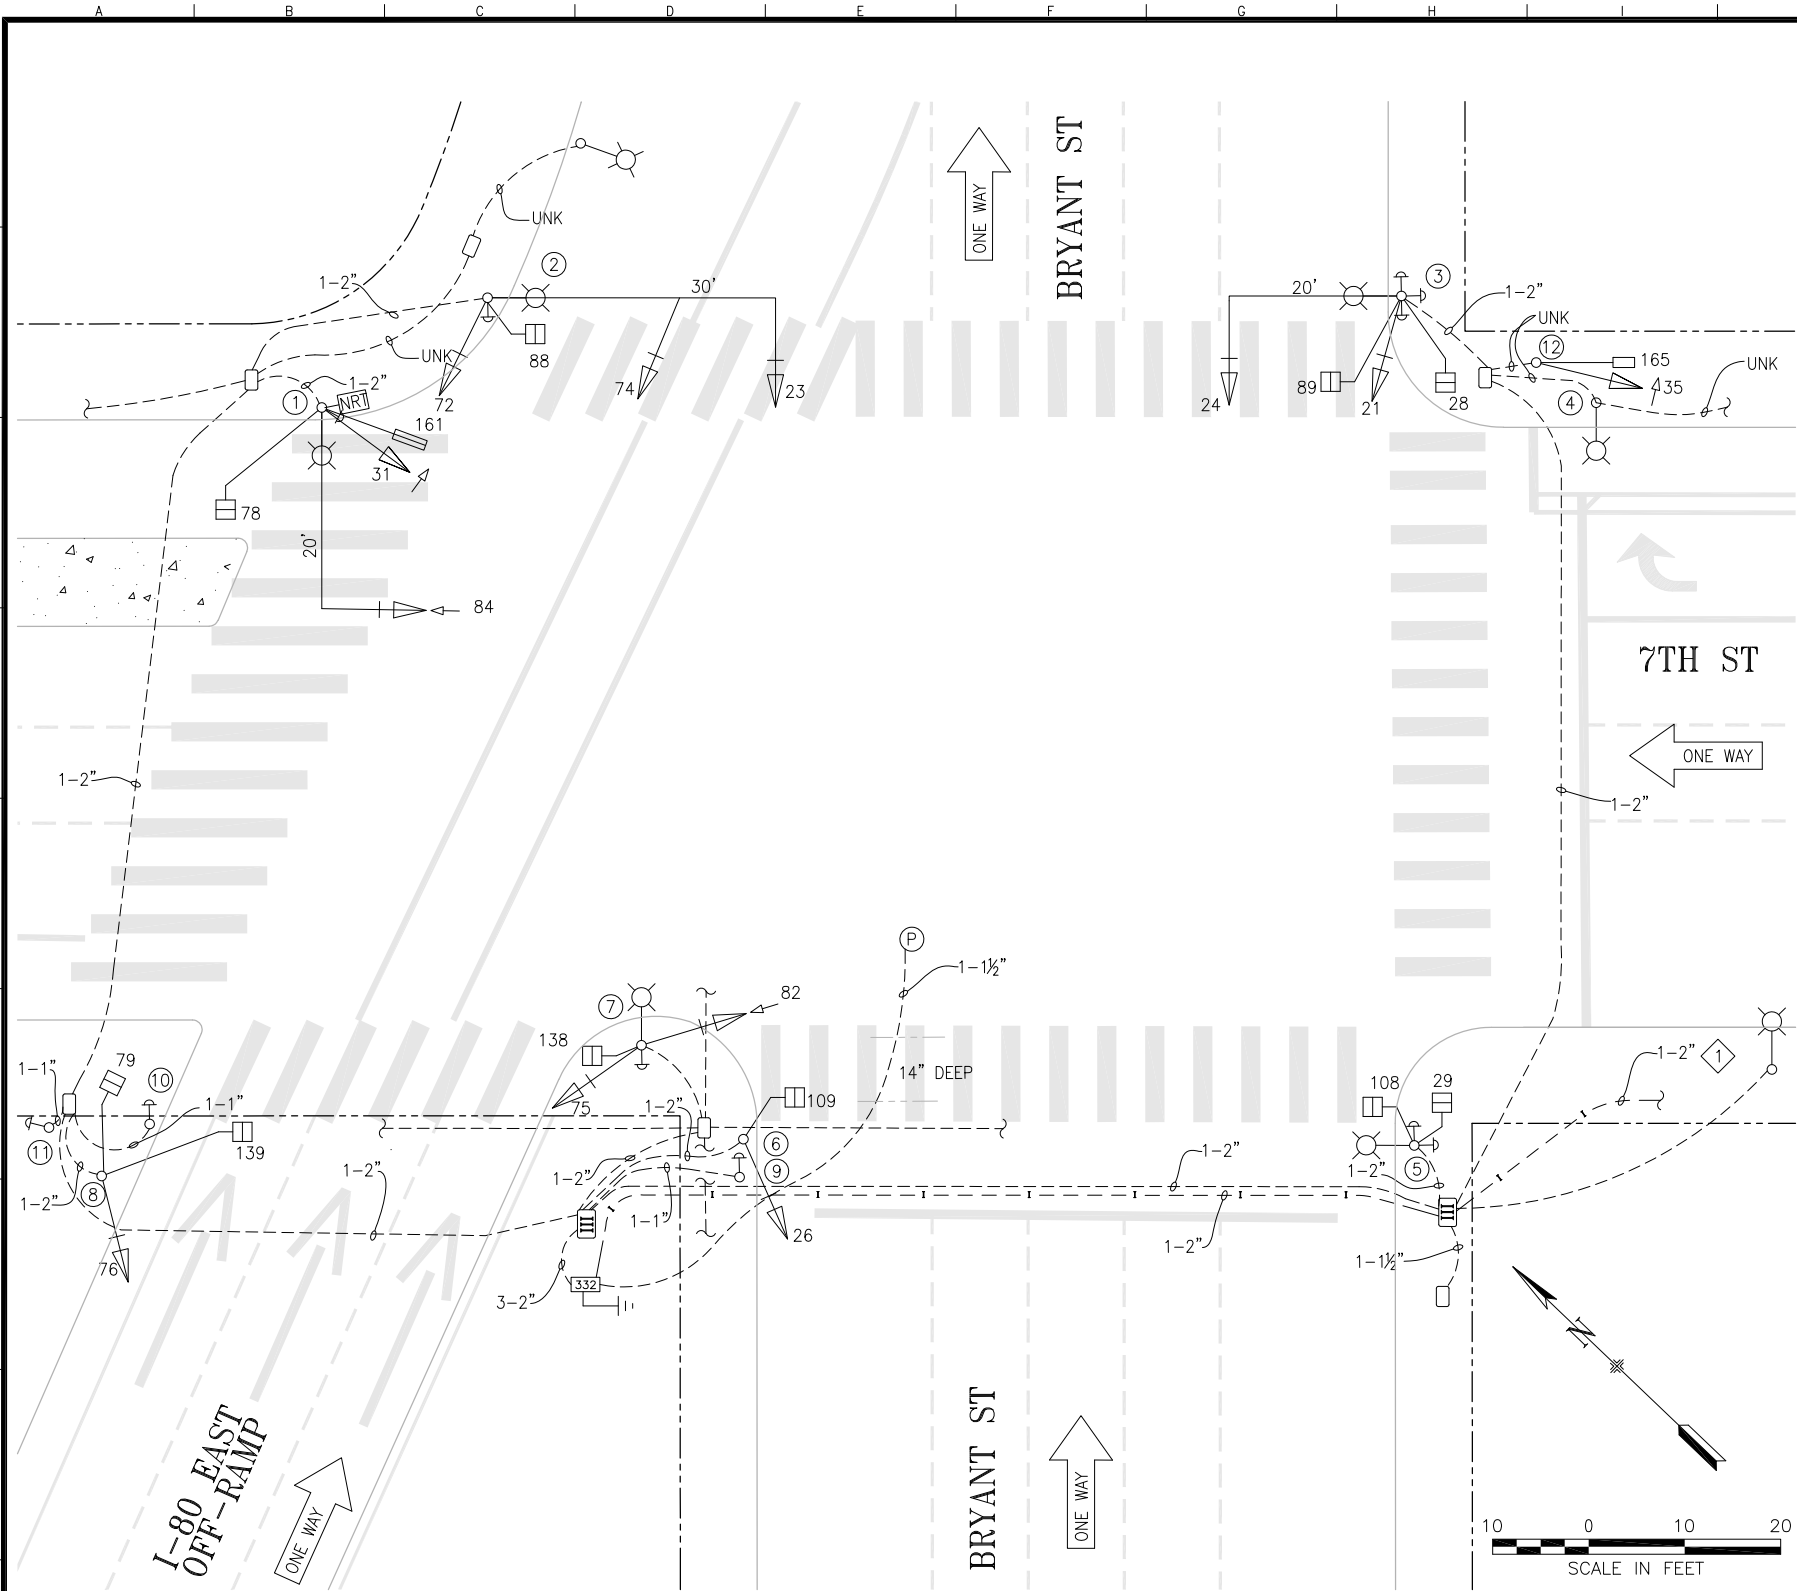

POLE AND EQUIPMENT SCHEDULE											
POLE No.	TYPE OF POLE	LUMINAIRE TYPE	VEHICLE SIGNAL					PEDESTRIAN SIGNAL			REMARKS
			No.	TYPE	MOUNTING	VISORS	LOUVERS/BP	No.	TYPE	MOUNTING	
①	17B-1-70 WITH 20' MAST ARM		84 31 161 NRT	3S12"GVA 3S12"FYRA 3S12"BIKE IS 24"X24"	MAC SV-2-TA SV-1	T T T	BP	78	1S-COUNT	SP-1	APS-3W
②	19-3-70 WITH 30' MAST ARM		74 23 72	3S12" 3S12" 3S12"	MAS MAS SV-1-T	FC FC FC	VERT/BP VERT/BP VERT/BP	88	1S-COUNT	SP-1	APS-3W
③	17B-1-70 WITH 20' MAST ARM		24 21	3S12" 3S12"	MAS SV-1-T	FC T	BP BP	89 85	1S-COUNT 1S-COUNT	SP-2-T	APS-3W X 3
④	STREET LIGHT										
⑤	STREET LIGHT							108 29	1S-COUNT 1S-COUNT	SP-2-T	APS-3W APS-3W
⑥	1-A (10')		26	3S12"	TV-1-T	T	BP	109	1S-COUNT	SP-1	
⑦	STREET LIGHT		75 82	3S12" 3S12"GVA	SV-2-TA	T T	BP	138	1S-COUNT	SP-1	APS-3W
⑧	1-A (10')		76	3S12"	TV-1-T	T	BP BP	139 79	1S-COUNT 1S-COUNT	SP-2-T	
⑨	PPB POST										APS-3W
⑩	PPB POST										APS-3W
⑪	PPB POST										APS-3W
⑫	TEMPORARY 1-A POLE		35 165	3S12"FYRA 3S8"BIKE	CUSTOM	T T					

NOTE: CONTROLLER FOUNDATION TYPE: TYPE '332'

SHEET NOTES

- ① 502 7TH ST PROJECT PIB TYPE III PULLBOX ON SWC, MODIFIED EXISTING CONDUIT AND INSTALLED NEW TYPE IV PULLBOX TO INTERCEPT GSRC ON THE WEST SIDE OF 7TH ST, SOUTH OF BRYANT ST
- ② 3S12"FYRA ARE 3-SECTION HEADS WITH SOLID RED RIGHT ARROW, SOLID YELLOW RIGHT ARROW, AND FLASHING YELLOW RIGHT ARROW FROM TOP TO BOTTOM.

4/5/22	SRC 2021-342 & CALTRANS APS PROJECT - ADD 3 PPB POLES & APS. CLARIFY POLE 6 CONDUIT ROUTING PER FIELD	D.Yeung	G.deLeon	
06/04/20	SRC 2020-036: ADDED BIKE PHASE 16, RT PHASE 3, BLANKOUT NRT.	AU	MS	
09/12/19	CONDUIT MOD ON SWC TO CONNECT TO PULLBOX AND GSRC S/O INT	WM	NW	
10/29/16	UPGRADED ALL 3S8" TO 3S12" (SRC 2016-180).	AU	MS	
8/2001	CAD DRAWING UPDATED.	TL	RO	
9/1997	BRYANT STREET SIGNAL MODIFICATION CONTRACT 7430E.	JY	TS	
NO.	DATE	DESCRIPTION	BY	APPROVED

TABLE OF REVISIONS
CHECKOUT DRAWING THROUGH THE SID CUSTODIAN FOR THE LATEST REVISION



SFMTA

DRAWN BY:	DATE:
AH	11/07/16
CHECKED BY:	DATE:
WT	11/14/16

SCALE
AS SHOWN
SHEET OF SHEETS
1 OF 1

TRAFFIC SIGNAL INVENTORY DIAGRAM
7TH STREET AND BRYANT STREET

CNN NO:
23875000
REV NO:
5