


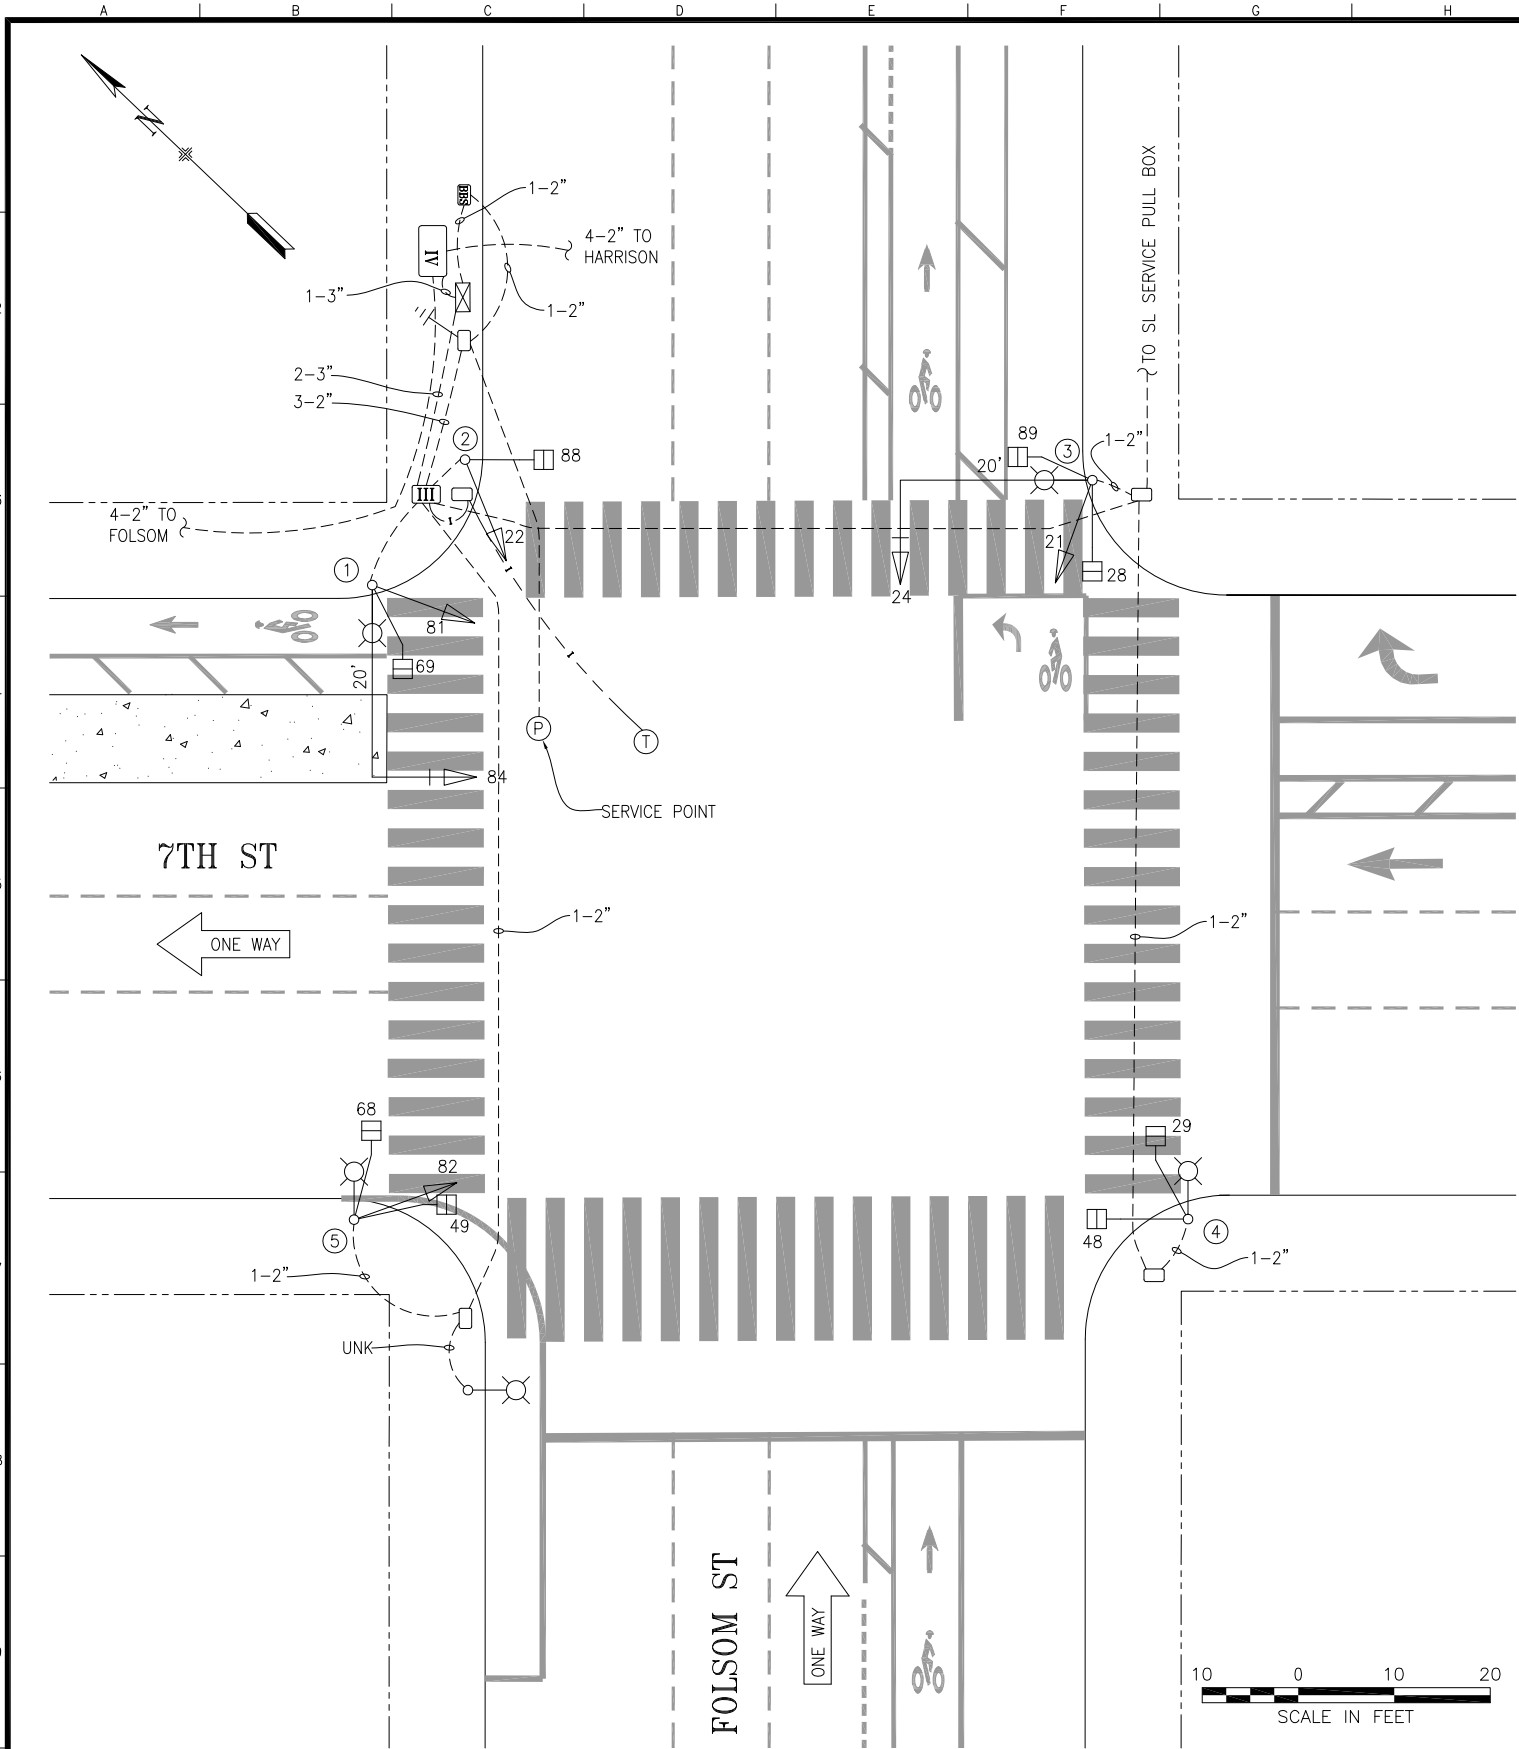

POLE AND EQUIPMENT SCHEDULE										
POLE No.	TYPE OF POLE	VEHICLE SIGNAL					PEDESTRIAN SIGNAL			REMARKS
		No.	TYPE	MOUNTING	VISORS	LOUVERS	No.	TYPE	MOUNTING	
①	17B-1-70 WITH 20' MAST AND 6' LUMINAIRE ARMS	84 81	3S12" 3S12"	MAS SV-1-T	T T		69	1S-COUNT	SP-1	BACKPLATE
②	1-A (10')	22	3S12"	TV-1-T	T		88	1S-COUNT	SP-1	
③	17B-1-70 WITH 20' MAST AND 6' LUMINAIRE ARMS	24 21	3S12" 3S12"	MAS SV-1-T	T T		28 89	1S-COUNT 1S-COUNT	SP-1 SP-1	BACKPLATE
④	SL						29 48	1S-COUNT 1S-COUNT	SP-1 SP-1	
⑤	SL	82	3S12"	SV-1-T	T		49 68	1S-COUNT 1S-COUNT	SP-1 SP-1	

NO.	DATE	DESCRIPTION	BY	APP.
1	10/29/16	UPGRADED ALL SIGNALS 358" TO 3S12" (SRC 2016-180).	AU	MS
2	10/29/16	UPDATED PER 0780J AS BUILTS.	AU	MS
3	02/1999	FOLSOM ST SIGNAL IMPROVEMENT CT#1302N	DVS	RO
TABLE OF REVISIONS				
CHECK WITH TRACING TO SEE IF YOU HAVE LATEST REVISION				

REFERENCE INFORMATION & FILE NO. OF SURVEYS
--



SAN FRANCISCO MUNICIPAL TRANSPORTATION AGENCY

CITY AND COUNTY OF SAN FRANCISCO

DRAWN:	DATE:
AH	11/07/16
CHECKED:	DATE:
WT	11/14/16

SCALE:
AS SHOWN
SHEET OF SHEETS
1 OF 1

TRAFFIC SIGNAL INVENTORY DIAGRAM
7TH STREET AND FOLSOM STREET

CNN NO.
24262000
REV NO.
2