

POLE AND EQUIPMENT SCHEDULE										
POLE No.	TYPE OF POLE	LUMINAIRE (HPS)	VEHICLE SIGNAL				PEDESTRIAN SIGNAL			REMARKS
		VOLTAGE/ WATTS	No.	TYPE	MOUNTING	VISORS	No.	TYPE	MOUNTING	
①	17B-1-70 W/ 20' MAST ARM AND 6' LUMINAIRE ARM.		81 84	3S12" 3S12"	SV-1-T MAS	T T	69 88	1S-COUNT 1S-COUNT	SP-1 SP-1	BACKPLATE BACKPLATE APS-2W APS-2W
②	19-4-100 WITH 30'MAST ARM & 6' LUMINAIRE ARM.		32 34 87	3S12"LA 3S12"LA 3S12"	SV-1-T MAS MAS	T T T	68	1S-COUNT	SP-1-T	BACKPLATE BACKPLATE BACKPLATE APS-2W
③	17B-1-70 W/ 20' MAST ARM AND 6' LUMINAIRE ARM.		61 64	3S12" 3S12"	SV-1-T MAS	T T				BACKPLATE BACKPLATE
④	UNK-UNK-70 W/ 20' MAST ARM & UNK LUMINAIRE ARM		62 67	3S12" 3S12"	SV-1-T MAS	T T				BACKPLATE BACKPLATE
⑤	MODIFIED SL POLE						29	1S-COUNT	SP-1	
⑤A	1-A (10')		36	3S12"LA	TV-1-T	T				APS-2W
⑥	CITY STANDARD SL WITH 6' LUMINAIRE ARM.		66	3S12"	SV-1-T	T	28 89	1S-COUNT 1S-COUNT	SP-1 SP-1	BACKPLATE APS-2W APS-2W
⑦	PPB POLE									APS-2W
⑧	CALTRANS TYPE 15 TS POLE						108	1S-COUNT	SP-1-T	
⑨	1-A (7')						109	1S-COUNT	TP-1-T	APS-2W


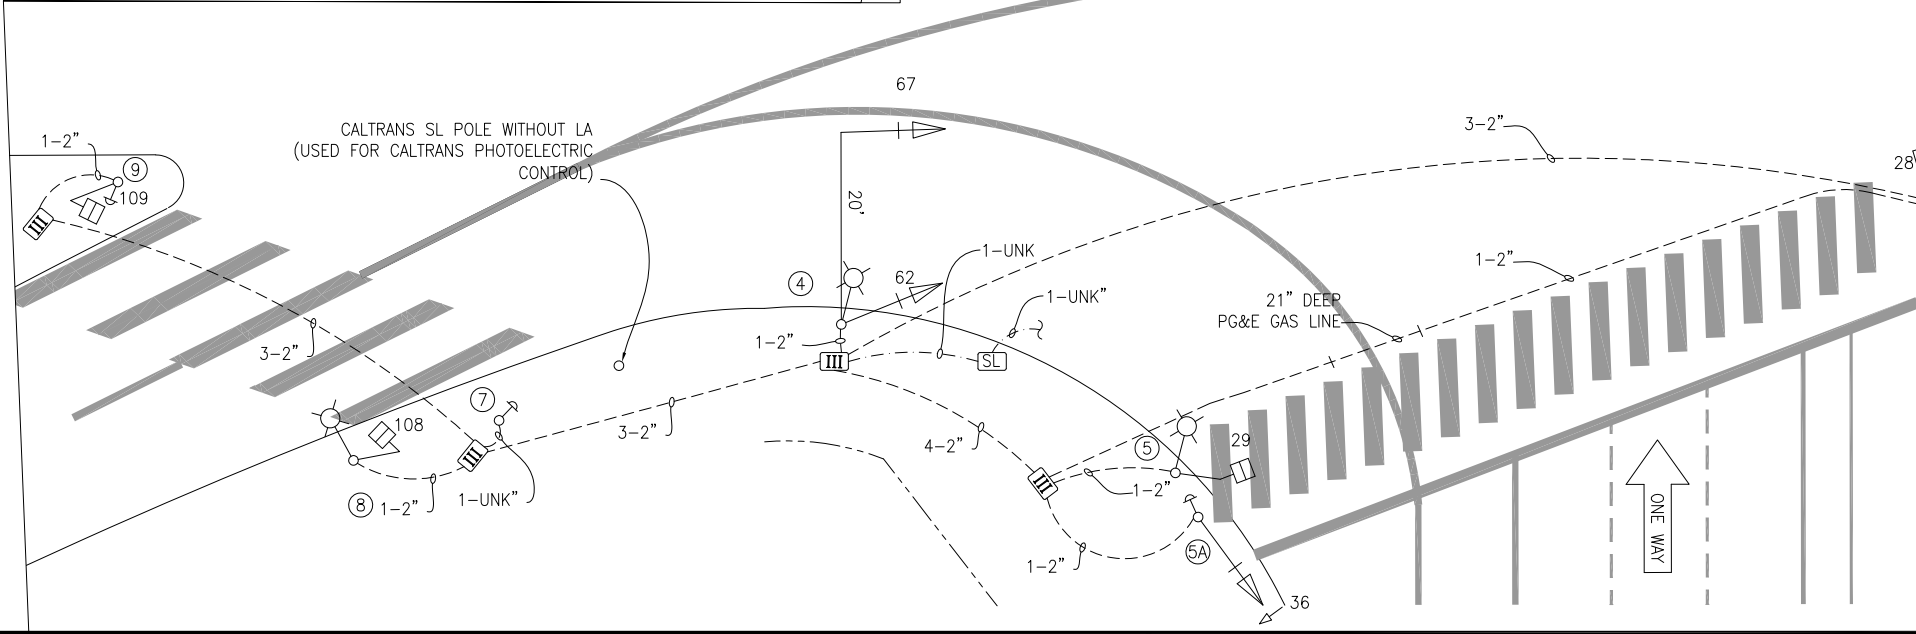


TABLE OF REVISIONS			
NO.	DATE	DESCRIPTION	BY APP.
1	4/7/20	ADD APS, SIGNALIZE RAMP XWALK & NBLT PER CALTRANS (04-4H7514)	Dyeung GdeLeon
2	10/29/16	UPDATED PER FIELD. UPGRADED ALL 358" TO 3S12" (SRC 2016-180).	AU MS
3	09/27/99	UPDATED PER 0780J AS-BUILTS.	BC
4	11/07/97	REVISED PER DPT REQUEST DURING WALKTHROUGH.	BC CF

REFERENCE INFORMATION & FILE NO. OF SURVEYS	

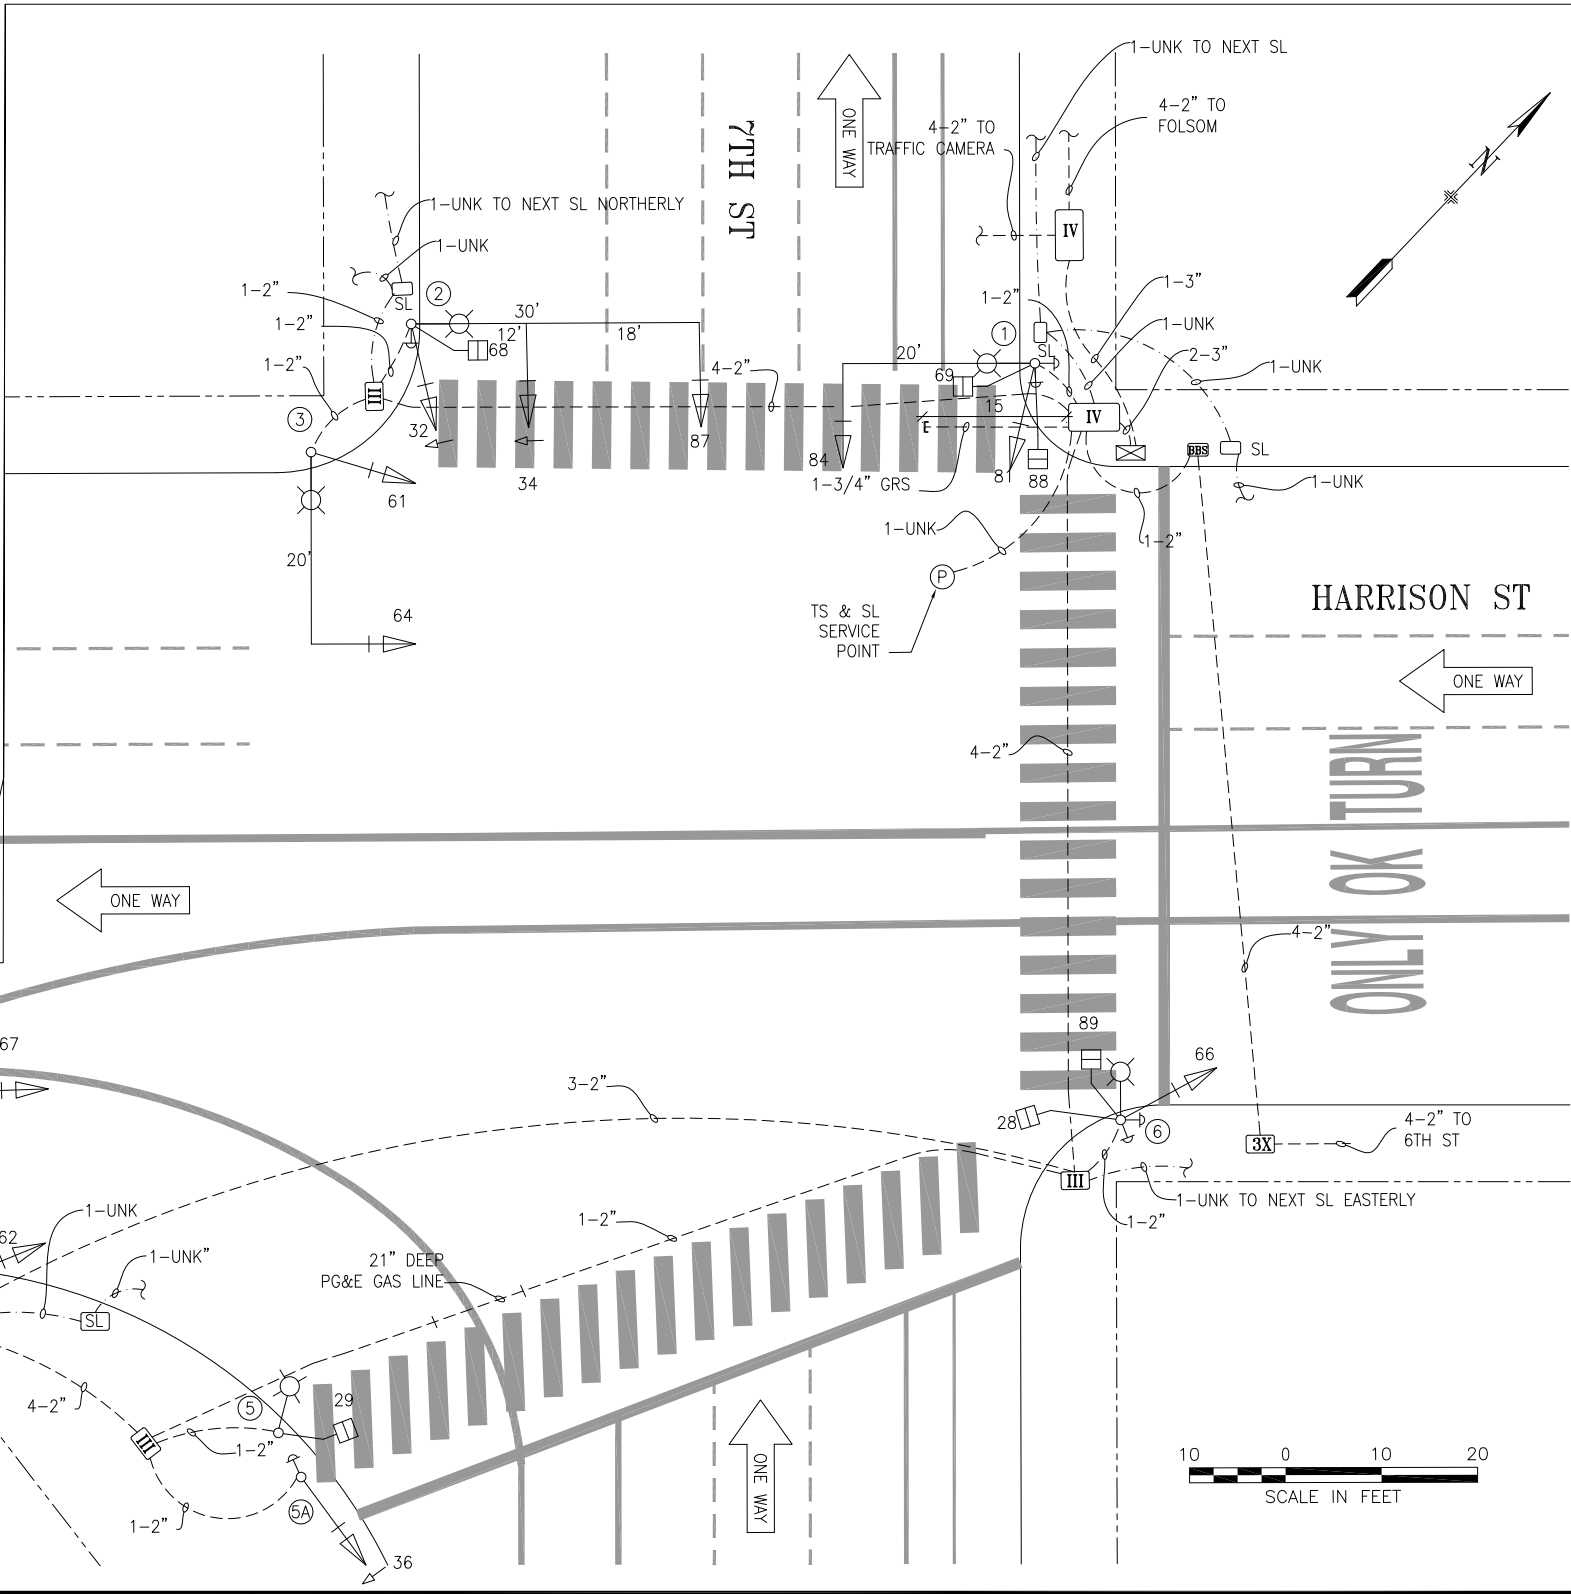

SAN FRANCISCO MUNICIPAL TRANSPORTATION AGENCY

CITY AND COUNTY OF SAN FRANCISCO

DRAWN:	DATE:
AH	11/07/16
CHECKED:	DATE:
WT	11/14/16

SCALE:
AS SHOWN
SHEET OF SHEETS
1 OF 1

TRAFFIC SIGNAL INVENTORY DIAGRAM
7TH STREET AND HARRISON STREET

CNN NO.
23929000
REV NO.
3