


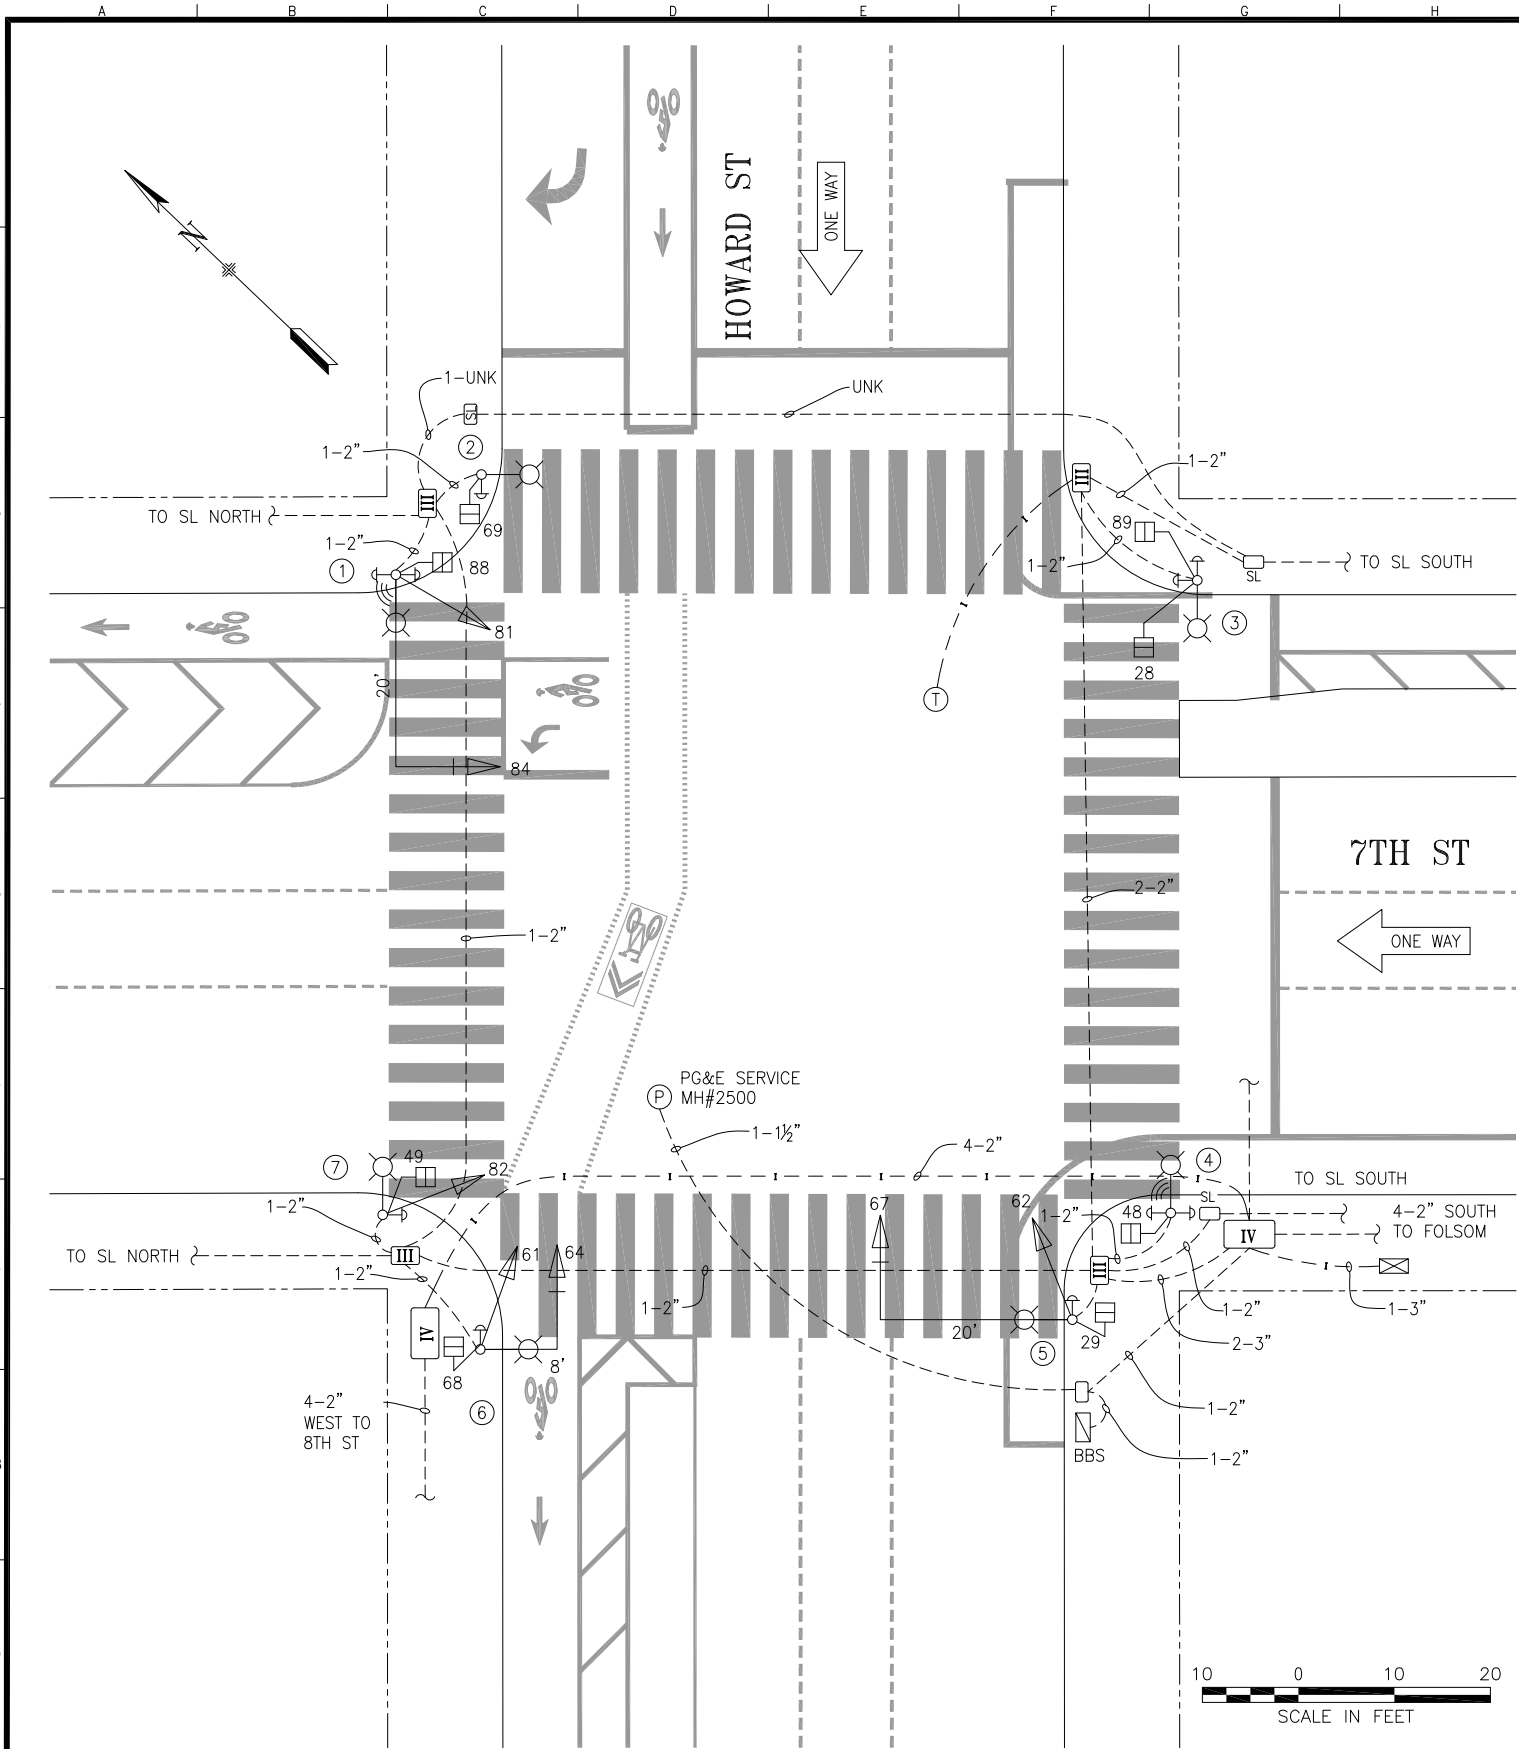

POLE AND EQUIPMENT SCHEDULE										
POLE No.	TYPE OF POLE	VEHICLE SIGNAL					PEDESTRIAN SIGNAL			REMARKS
		No.	TYPE	MOUNTING	VISORS	LOUVERS/BP	No.	TYPE	MOUNTING	
①	17B-1-70 W/ 20' MAST ARM AND 6' LUMINAIRE ARM	84 81	3S12" 3S12"	MAS SV-1-T	T T	BP	88	1S-COUNT	SP-1	TSP ANTENNA APS-3W x 2
②	SL						69	1S-COUNT	SP-1	APS-3W
③	SL						28 89	1S-COUNT 1S-COUNT	SP-1 SP-1	APS-3W x 2
④	SL						48	1S-COUNT	SP-1	TSP ANTENNA APS-3W x 2
⑤	17B-1-70 W/ 20' MAST ARM AND 6' LUMINAIRE ARM	62 67	3S12" 3S12"	SV-1 MAS	T T	BP	29	1S-COUNT	SP-1	APS-3W
⑥	17B-1-70 W/ 8' MAST ARM AND 6' LUMINAIRE ARM	64 61	3S12" 3S12"	MAS SV-1	T T	BP	68	1S-COUNT	SP-1	APS-3W
⑦	SL	82	3S12"	SV-1-T	T		49	1S-COUNT	SP-1	APS-3W

Δ	09/29/21	INSTALL APS UNITS (SRC 2021-053) PER FIELD: ADD TSP EQP., UPDATE POLES AND MOUNTINGS	ELuu	GdeLeon	
Δ	10/29/16	UPGRADED ALL SIGNALS 358" TO 3S12" (SRC 2016-180)	ALy	MSallaberry	
Δ	10/12/15	RELOCATED TYPE IV BOX, CABINET, BBS @ SW CORNER.			
Δ	05/18/04	CONVERTED FROM 0435J, 0780J AS-BUILTS	ALy	MSallaberry	
NO.	DATE	DESCRIPTION	BY	APPROVED	
TABLE OF REVISIONS CHECKOUT DRAWING THROUGH THE SID CUSTODIAN FOR THE LATEST REVISION					



SFMTA

DRAWN BY:	DATE:
AH	11/07/16
CHECKED BY:	DATE:
WT	11/14/16

SCALE
AS SHOWN
SHEET OF SHEETS
1 OF 1

TRAFFIC SIGNAL INVENTORY DIAGRAM
7TH STREET AND HOWARD STREET

CNN NO:
24265000
REV NO:
3