




| POLE AND EQUIPMENT SCHEDULE |                                                |                |                |                |                  |        |             |                   |                      |              |                                                |
|-----------------------------|------------------------------------------------|----------------|----------------|----------------|------------------|--------|-------------|-------------------|----------------------|--------------|------------------------------------------------|
| POLE No.                    | TYPE OF POLE                                   | LUMINAIRE TYPE | VEHICLE SIGNAL |                |                  |        |             | PEDESTRIAN SIGNAL |                      |              | REMARKS                                        |
|                             |                                                |                | No.            | TYPE           | MOUNTING         | VISORS | LOUVERS/ BP | No.               | TYPE                 | MOUNTING     |                                                |
| ①                           | 17-1-70 W/ 20' MAST ARM & 6' LUMINAIRE ARM     | 120V/ 200W     | 81<br>84       | 3S12"<br>3S12" | SV-1-T<br>MAS    | T<br>T | BP          | 69<br>88          | 1S-COUNT<br>1S-COUNT | SP-1<br>SP-1 | APS-3W X 2                                     |
| ②                           | MUNI W/ 6' LUMINAIRE ARM                       |                | 22             | 3S12"          | SV-1             | T      |             |                   |                      |              | APS-3W                                         |
| ③                           | 16-1-70 W/ 8' MA ON BASEMENT COLUMN FOUNDATION |                | 24             | 3S12"          | MAC-SF           | T      | BP          |                   |                      |              | NETWORK RADIO                                  |
| ④                           | MUNI FEEDER W/ 6' LUMINAIRE ARM                |                | 21             | 3S12"          | SV-1-T           | T      |             | 28<br>89          | 1S-COUNT<br>1S-COUNT | SP-2-T       | APS-3W X 2<br>EXTERNAL CONDUIT                 |
| ⑤                           | STREETLIGHT                                    |                |                |                |                  |        |             | 29                | 1S-COUNT             | SP-1         | APS-3W<br>ANTENNA                              |
| ⑥                           | 1-A (10') ON BASEMENT FOUNDATION               |                | 62             | 3S12"          | TV-1-T           | T      |             | 49                | 1S-COUNT             | SP-1         | APS-3W                                         |
| ⑦                           | 17-1-70 W/ 8' MAST ARM & 6' LUMINAIRE ARM      |                | 61<br>64       | 3S12"<br>3S12" | SV-1-T<br>MAC-SF | T<br>T | BP          | 48<br>68          | 1S-COUNT<br>1S-COUNT | SP-1<br>SP-1 | APS-3W X 2<br>PREEMPT & NETWORK<br>CCTV CAMERA |
| ⑧                           | 1-A (10')                                      | 240V/ 200W     | 82             | 3S12"          | TV-1-T           | T      |             |                   |                      |              | APS-3W                                         |

|                                                                                          |          |                                                      |       |              |
|------------------------------------------------------------------------------------------|----------|------------------------------------------------------|-------|--------------|
| Δ                                                                                        | 07/5/22  | SRC 2021-201: ADD APS                                | E.LUU | G.DELEON     |
| Δ                                                                                        | 11/10/20 | SRC 2020-255: UPDATED MOUNTING FOR SIGNALS 24 AND 64 | H.YU  | M.VELASCO    |
| Δ                                                                                        | 10/29/16 | UPGRADED ALL SIGNALS 358" TO 3512" (SRC 2016-180).   | A.UY  | M.SALLABERRY |
| Δ                                                                                        | 10/29/16 | UPDATED PER FIELD.                                   | A.UY  | M.SALLABERRY |
| Δ                                                                                        | 08/06/02 | CONVERTED FROM 1663N AS-BUILTS.                      | A.UY  | M.SALLABERRY |
| NO.                                                                                      | DATE     | DESCRIPTION                                          | BY    | APPROVED     |
| TABLE OF REVISIONS<br>CHECKOUT DRAWING THROUGH THE SID CUSTODIAN FOR THE LATEST REVISION |          |                                                      |       |              |

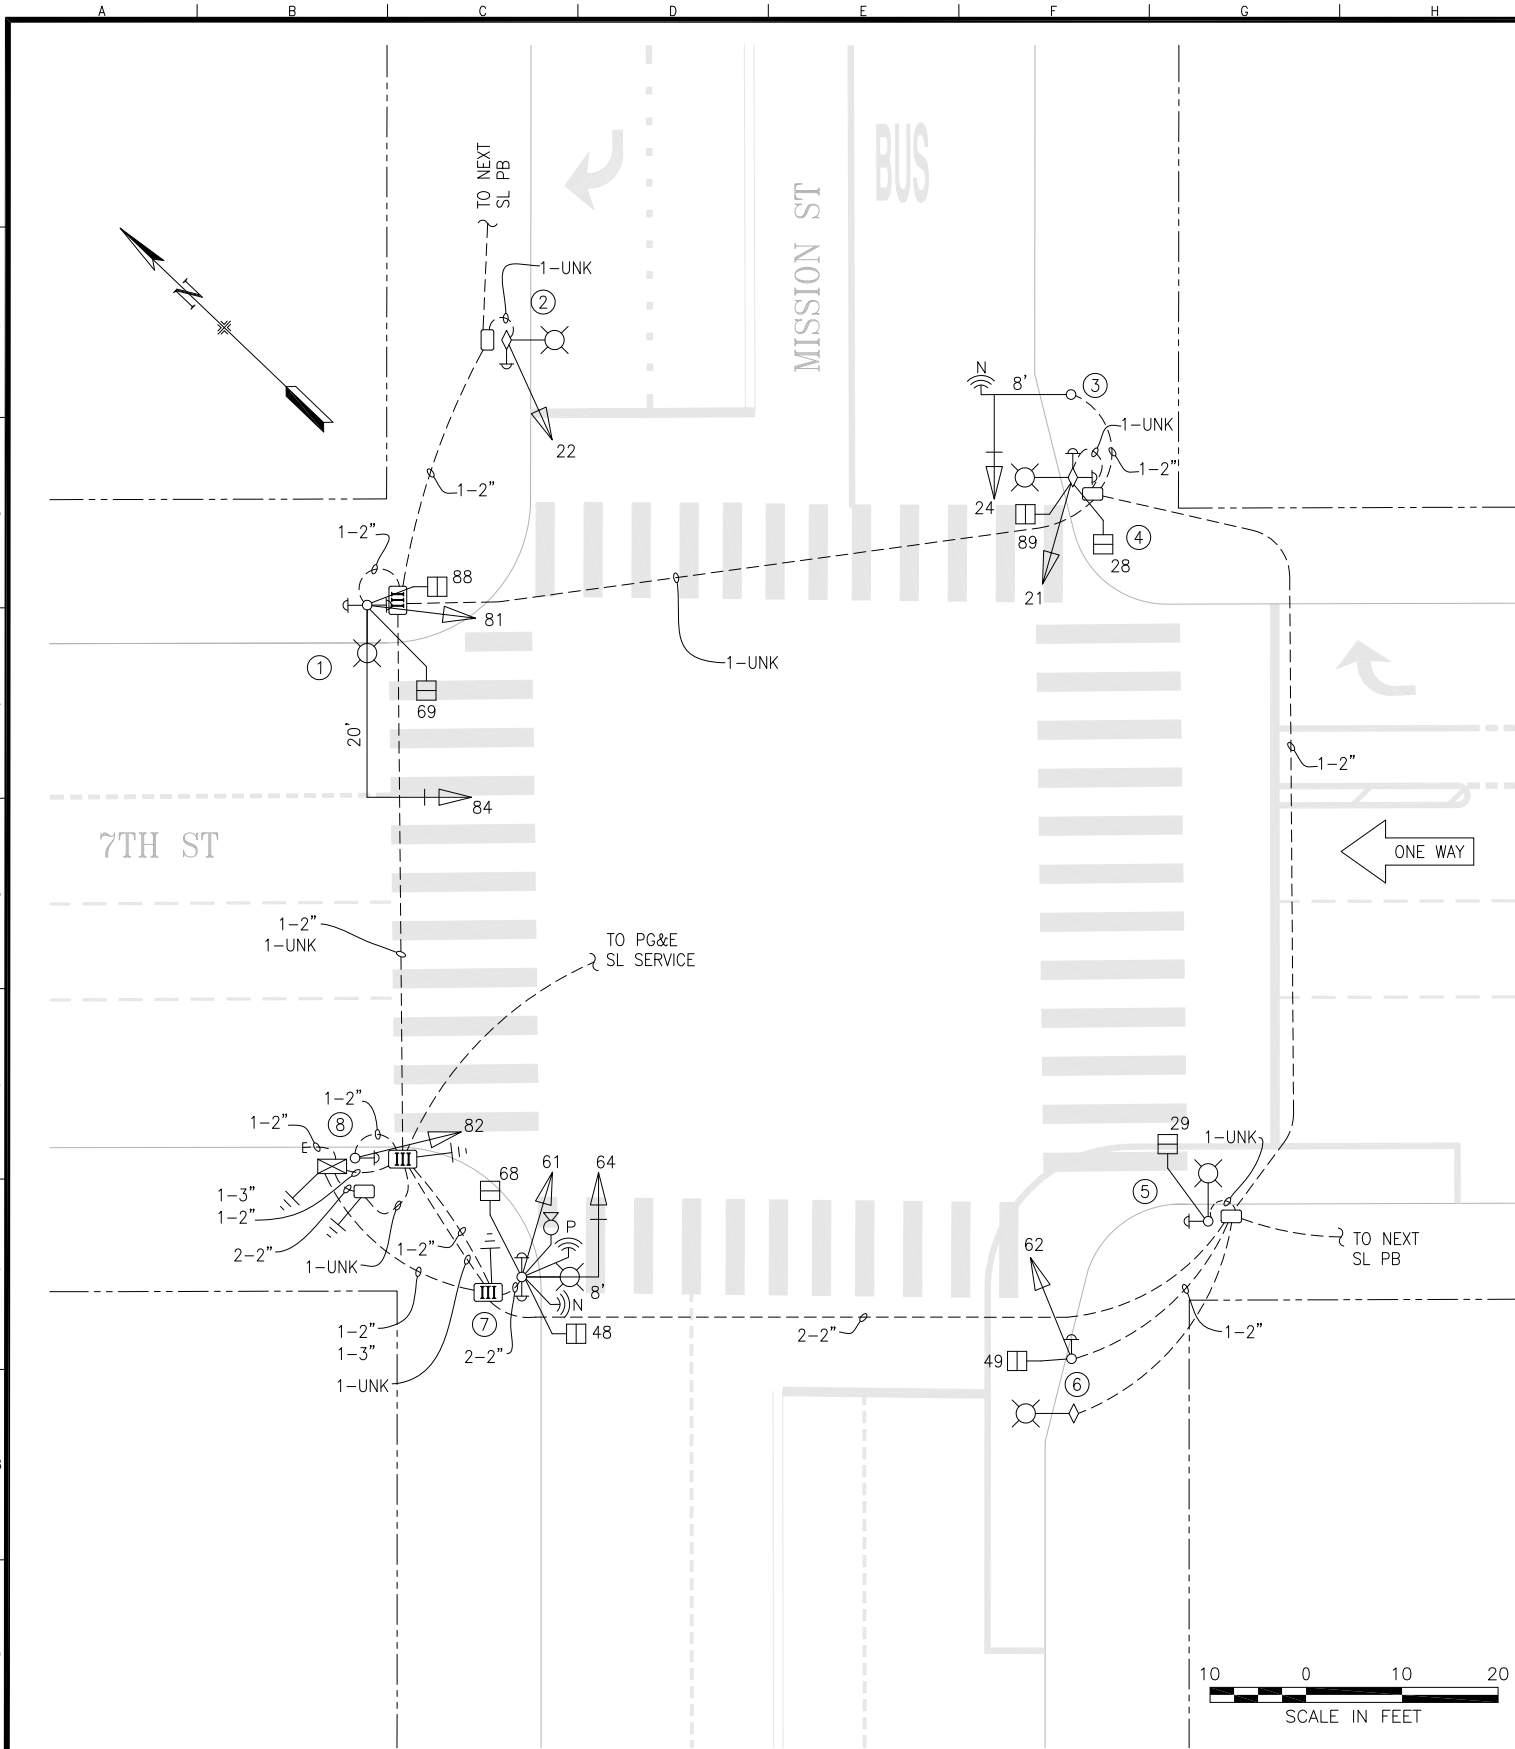

SFMTA

|             |          |
|-------------|----------|
| DRAWN BY:   | DATE:    |
| AH          | 11/07/16 |
| CHECKED BY: | DATE:    |
| WT          | 11/14/16 |

|                 |
|-----------------|
| SCALE           |
| AS SHOWN        |
| SHEET OF SHEETS |
| 1 OF 1          |

|                                  |
|----------------------------------|
| TRAFFIC SIGNAL INVENTORY DIAGRAM |
| 7TH STREET AND MISSION STREET    |

|          |
|----------|
| CNN NO:  |
| 24315000 |
| REV NO:  |
| 4        |