


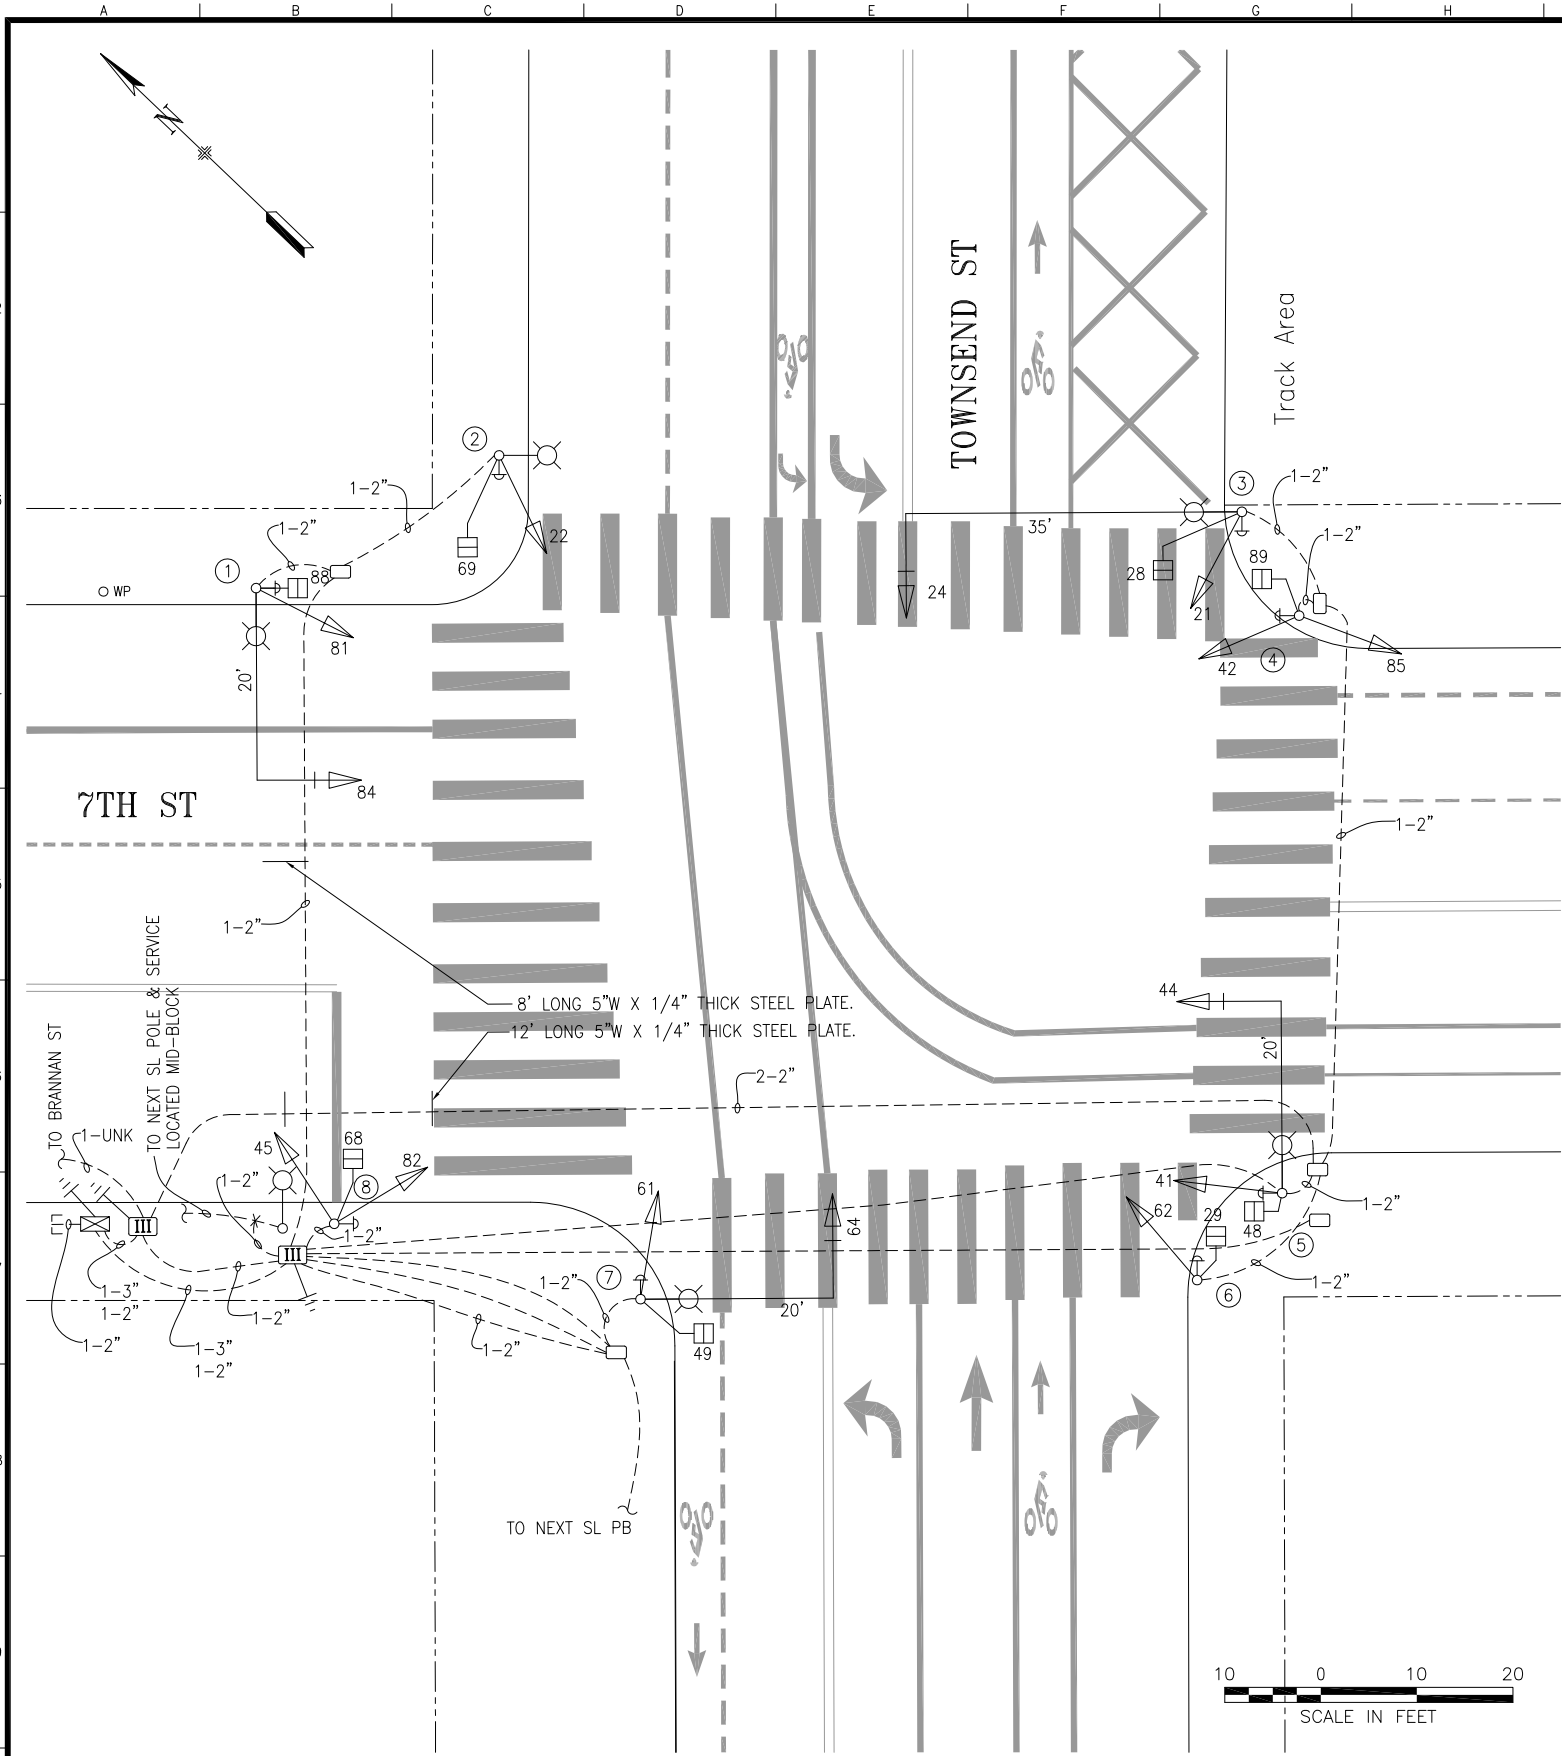

POLE AND EQUIPMENT SCHEDULE										
POLE No.	TYPE OF POLE	LUMINAIRE (HPS)	VEHICLE SIGNAL				PEDESTRIAN SIGNAL			REMARKS
		VOLTAGE/ WATTS	No.	TYPE	MOUNTING	VISORS	No.	TYPE	MOUNTING	
①	16-3-70 WITH 20' MAST ARM AND 6' LUMINAIRE ARM	120/200	84 81	3S12" 3S12"	MAS (END) SV-1-T	T T	88	1S-COUNT	SP-1	BP APS
②	CITY STANDARD STREET LIGHT		22	3S12"	SV-1-T	T	69	1S-COUNT	SP-1	APS
③	SPECIAL POLE WITH 35' MAST ARM AND 6' LUMINAIRE ARM UNION METAL 50700-Y1676-10G EXCEPT 24' SMA MTG HT	120/200	24 21	3S12" 3S12"	CUSTOM SV-2-TA	T T	28	1S-COUNT	SP-1	BP APS
④	1-A (10')		42 85	3S12" 3S12"	TV-2-T-SFA	T T	89	1S-COUNT	SP-1	APS APS
⑤	16-1-70 WITH 20' MAST ARM AND 6' LUMINAIRE ARM	120/200	44 41	3S12" 3S12"	MAS (END) SV-1-T	T T	48	1S-COUNT	SP-1	BP APS
⑥	1-A (10')		62	3S12"	TV-1-T	T	29	1S-COUNT	SP-1	APS
⑦	17-3-70 WITH 20' MAST ARM AND 6' LUMINAIRE ARM	120/200	64 61	3S12" 3S12"	MAS (END) SV-1-T	T T	49	1S-COUNT	SP-1	BP APS
⑧	1-A (10')		45 82	3S12" 3S12"	TV-2-T	T	68	1S-COUNT	SP-1	APS

NO.	DATE	DESCRIPTION	BY	APP.
TABLE OF REVISIONS				
CHECK WITH TRACING TO SEE IF YOU HAVE LATEST REVISION				
Δ	4/30/18	CHANGE POLE 4 MOUNT FROM TV-2-T TO TV-2-T-SFA (SRC 2017-260)	DY	GD
Δ	10/29/16	UPGRADED ALL SIGNALS 358" TO 3512" (SRC 2016-180), ADDED PPB, PER FIELD.	AU	MS
Δ	08/13/14	REMOVED RAILROAD SIGNALS, BLANK-OUTS (SRC 2013-253).	ET	MV
Δ	11/07/02	CONVERTED FROM 1989N AS-BUILTS	AU	MS

REFERENCE INFORMATION & FILE NO. OF SURVEYS
--



SAN FRANCISCO MUNICIPAL TRANSPORTATION AGENCY
CITY AND COUNTY OF SAN FRANCISCO

DRAWN:	DATE:
AH	11/07/16
CHECKED:	DATE:
WT	11/14/16

SCALE:
AS SHOWN
SHEET OF SHEETS
1 OF 1

TRAFFIC SIGNAL INVENTORY DIAGRAM
7TH STREET AND TOWNSEND STREET

CNN NO.
23854000
REV NO.
3