



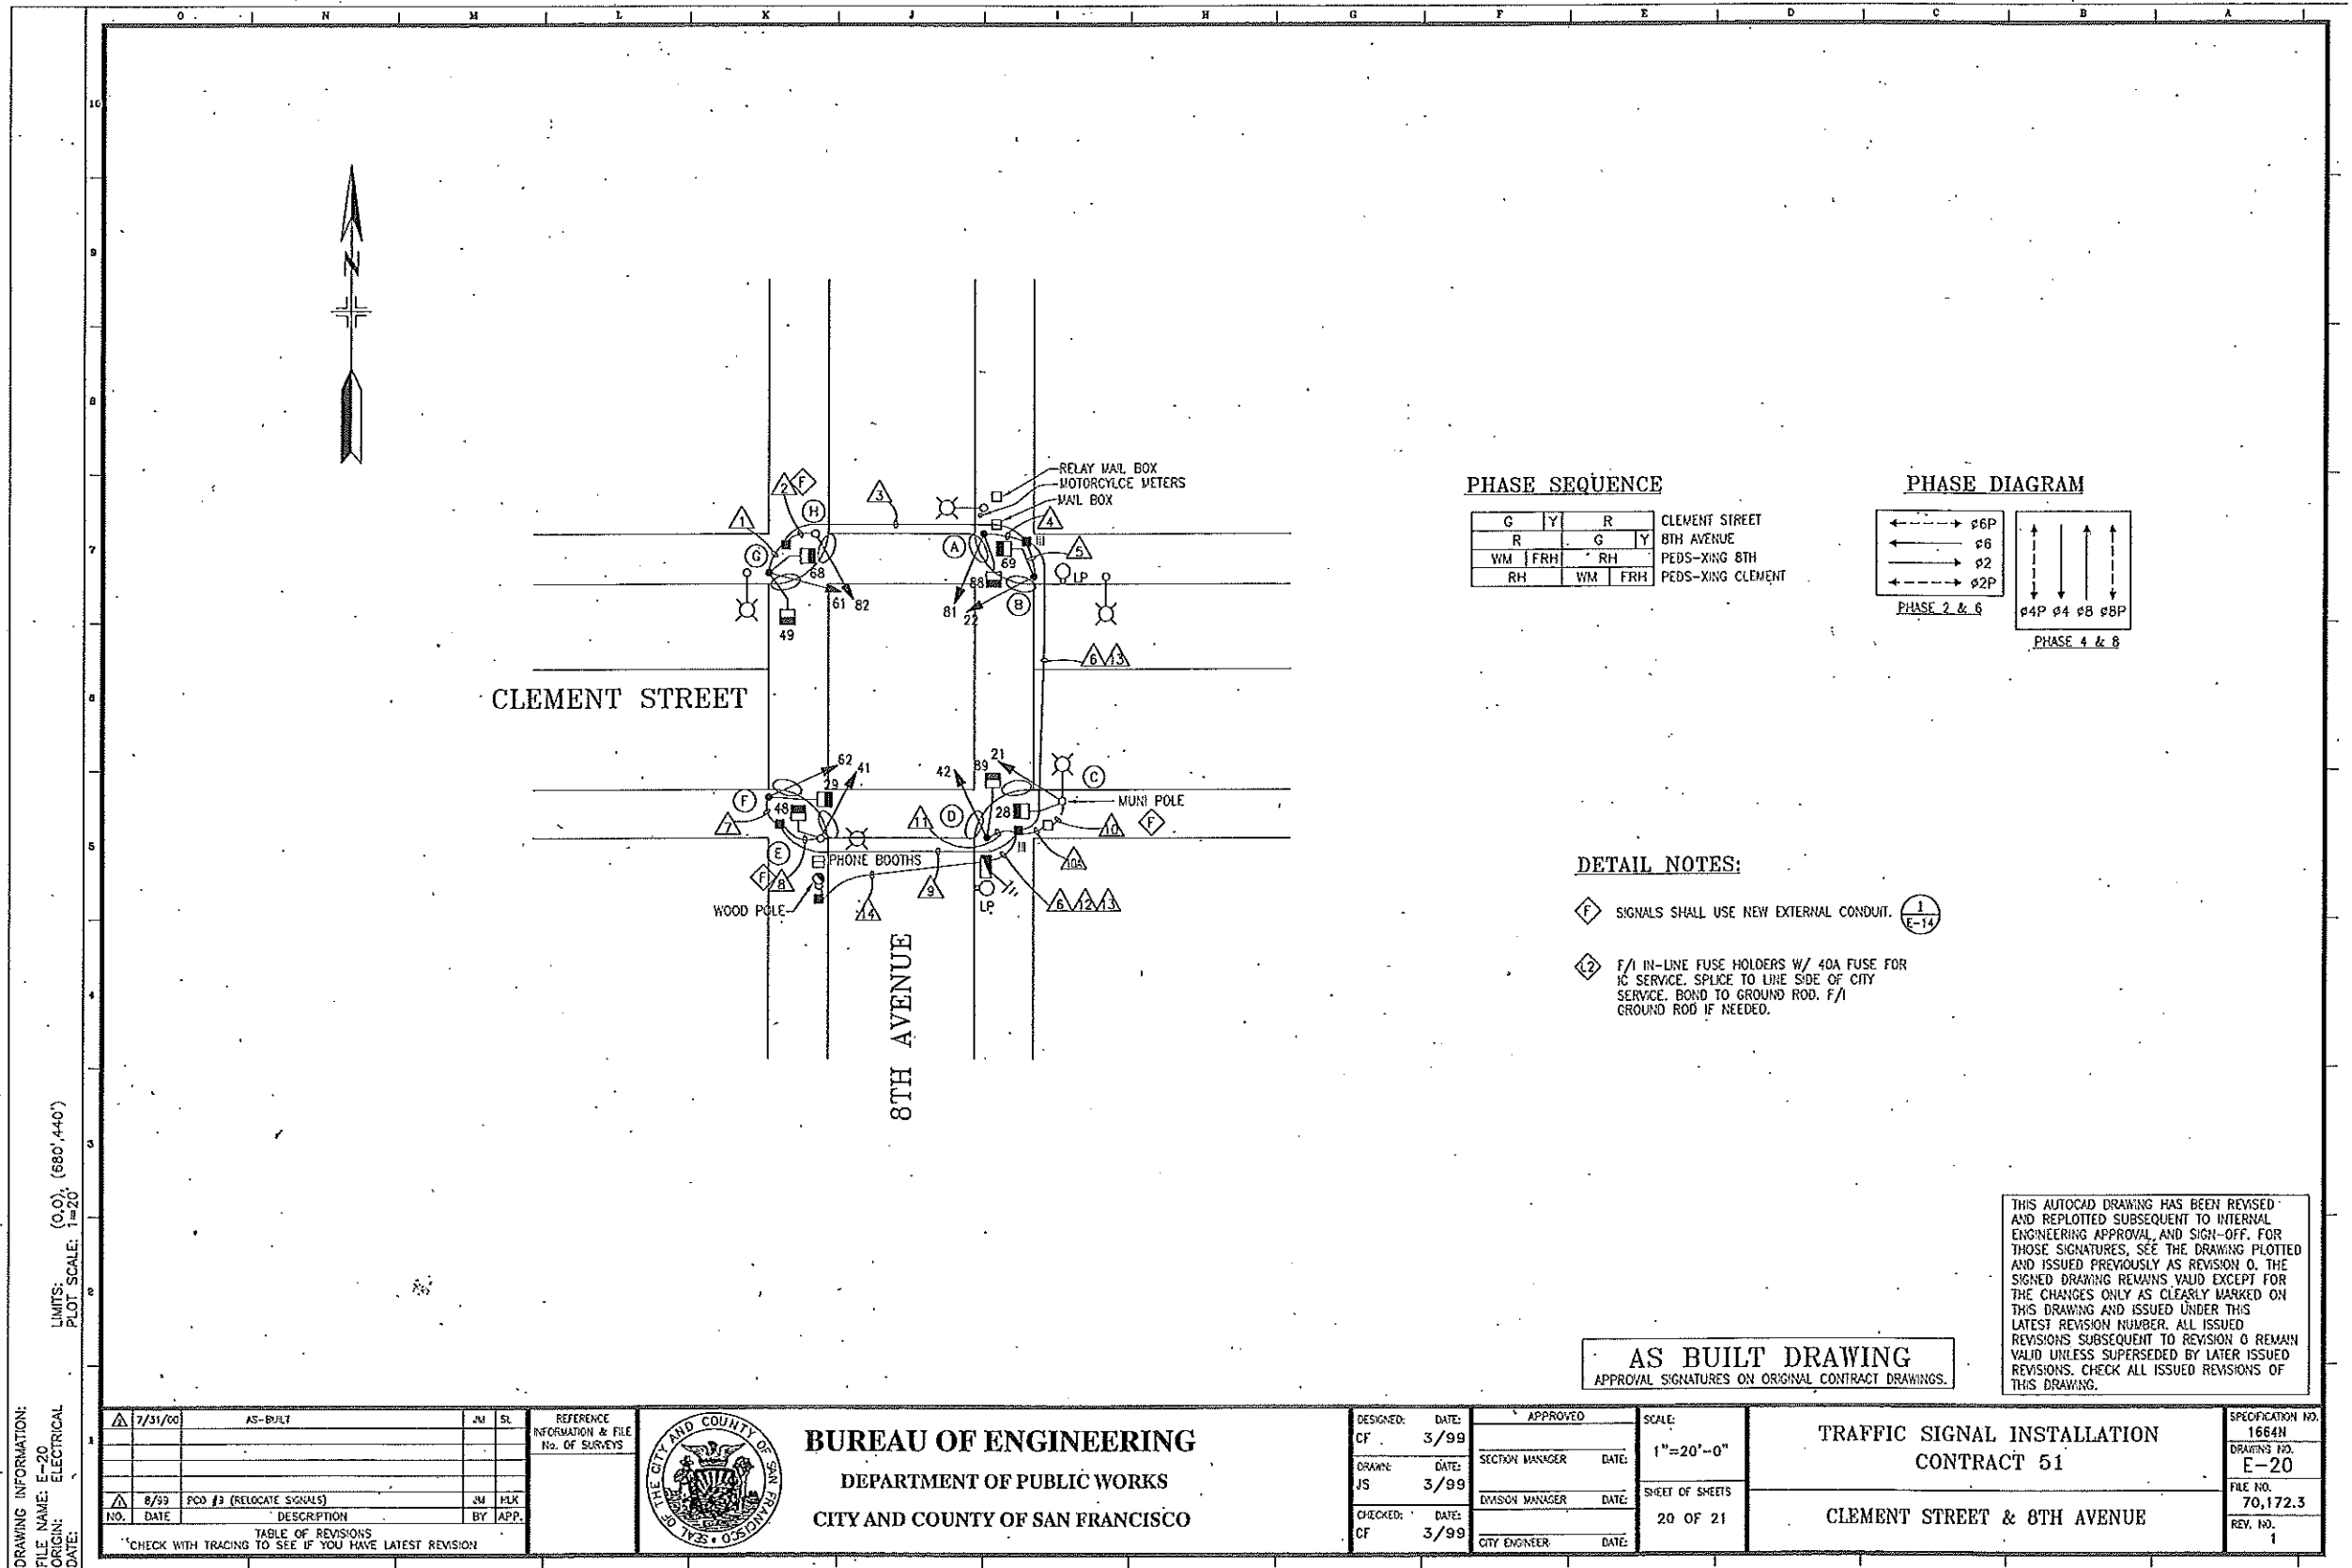

PHASE SEQUENCE

G	Y	R	CLEMMENT STREET
R	G	Y	8TH AVENUE
WM	FRH	RH	PEDS-XING 8TH
RH	WM	FRH	PEDS-XING CLEMMENT

PHASE DIAGRAM

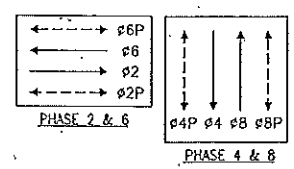

DETAIL NOTES:

- ⬡ SIGNALS SHALL USE NEW EXTERNAL CONDUIT. 1 E-14
- ⬢ F/I IN-LINE FUSE HOLDERS W/ 40A FUSE FOR IC SERVICE. SPLICE TO LINE SIDE OF CITY SERVICE. BOND TO GROUND ROD. F/I GROUND ROD IF NEEDED.

AS BUILT DRAWING
APPROVAL SIGNATURES ON ORIGINAL CONTRACT DRAWINGS.

THIS AUTOCAD DRAWING HAS BEEN REVISED AND REPLOTTED SUBSEQUENT TO INTERNAL ENGINEERING APPROVAL AND SIGN-OFF. FOR THOSE SIGNATURES, SEE THE DRAWING PLOTTED AND ISSUED PREVIOUSLY AS REVISION 0. THE SIGNED DRAWING REMAINS VALID EXCEPT FOR THE CHANGES ONLY AS CLEARLY MARKED ON THIS DRAWING AND ISSUED UNDER THIS LATEST REVISION NUMBER. ALL ISSUED REVISIONS SUBSEQUENT TO REVISION 0 REMAIN VALID UNLESS SUPERSEDED BY LATER ISSUED REVISIONS. CHECK ALL ISSUED REVISIONS OF THIS DRAWING.

DRAWING INFORMATION: FILE NAME: E-20 ORIGIN: ELECTRICAL DATE:		LIMITS: (0,0) (680',440') PLOT SCALE: 1"=20'		REFERENCE INFORMATION & FILE No. OF SURVEYS				BUREAU OF ENGINEERING DEPARTMENT OF PUBLIC WORKS CITY AND COUNTY OF SAN FRANCISCO		DESIGNED: DATE: CF 3/99	APPROVED		SCALE: 1"=20'-0"	TRAFFIC SIGNAL INSTALLATION CONTRACT 51		SPECIFICATION NO. 1664N	
TABLE OF REVISIONS "CHECK WITH TRACING TO SEE IF YOU HAVE LATEST REVISION"										DRAWN: DATE: JS 3/99	SECTION MANAGER DATE:		SHEET OF SHEETS 20 OF 21		CLEMENT STREET & 8TH AVENUE		DRAWING NO. E-20
										CHECKED: DATE: CF 3/99	DIVISION MANAGER DATE:						FILE NO. 70,172.3
											CITY ENGINEER DATE:						REV. NO. 1

