


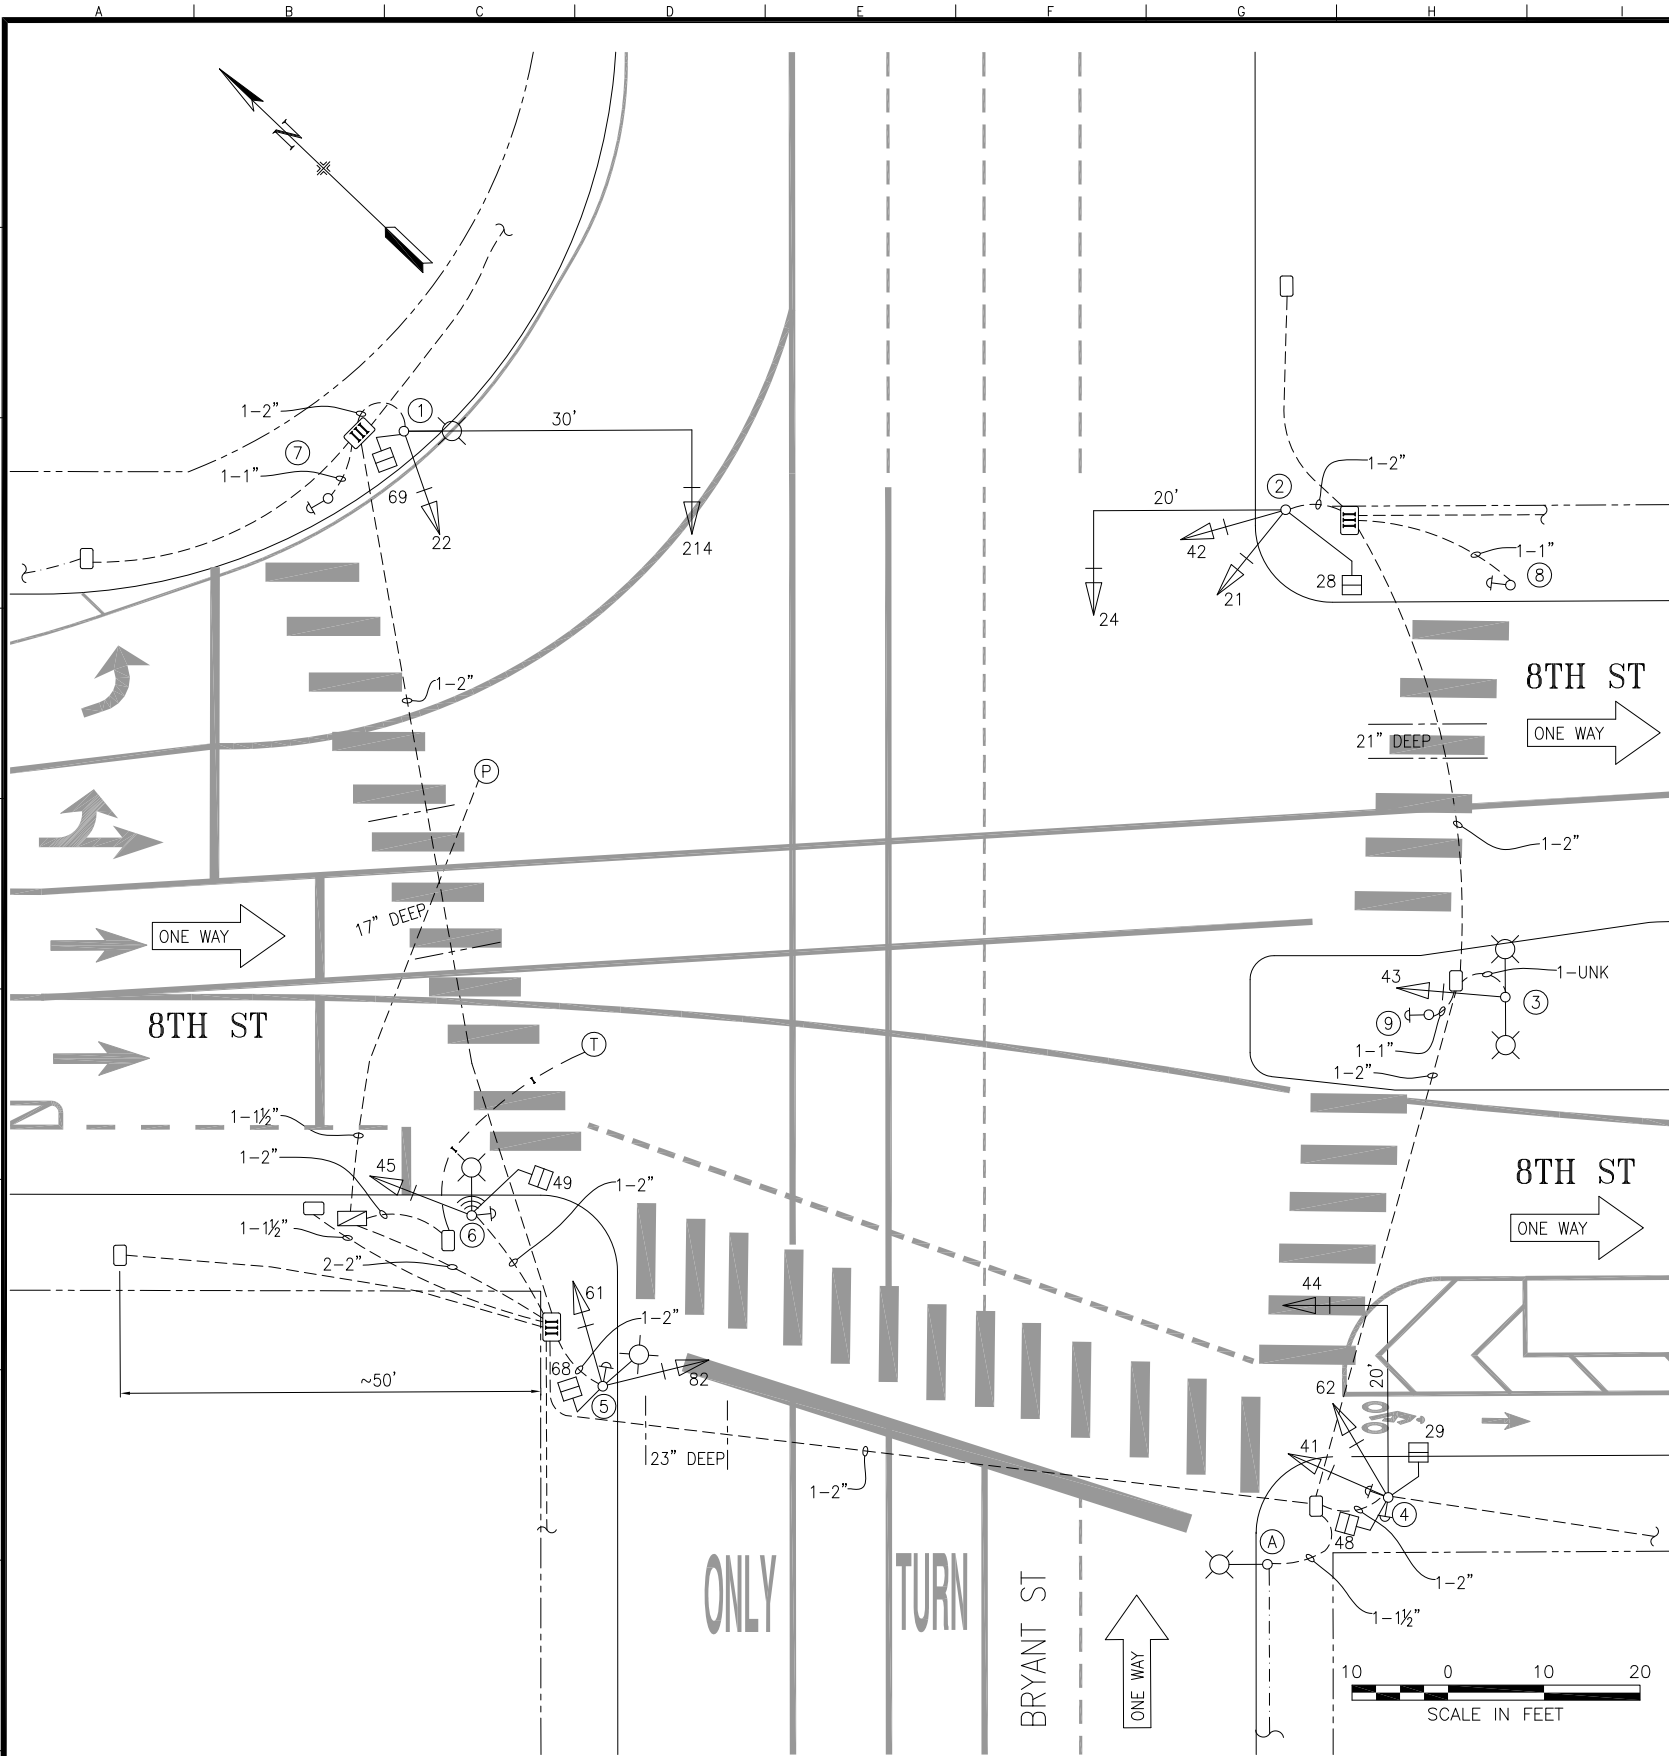

POLE AND EQUIPMENT SCHEDULE										
POLE No.	TYPE OF POLE	VEHICLE SIGNAL					PEDESTRIAN SIGNAL			REMARKS
		No.	TYPE	MOUNTING	VISORS	LOUVERS/BP	No.	TYPE	MOUNTING	
①	19-1-70 WITH 30' SIGNAL MAST ARM	214 22	3S12" 3S12"	MAS SV-1-T	FC T	BP BP	69	1S-COUNT	SP-1	
②	16-1-70 WITH 20' SIGNAL MAST ARM	24 42 21	3S12" 3S12" 3S12"	MAS SV-2-TA	FC T T	BP BP BP	28	1S-COUNT	SP-1	
③	SL	43	3S12"	SV-1-T	T	BP				
④	16-1-70 WITH 20' SIGNAL MAST ARM	44 62 41	3S12" 3S12" 3S12"	MAS SV-2-TA	FC T	BP BP BP	29 48	1S-COUNT 1S-COUNT	SP-1 SP-1	APS-3W APS-3W
⑤	SL	61 82	3S12" 3S12"	SV-2-TA	T T	BP BP	68	1S-COUNT	SP-1	APS-3W
⑥	SL	45	3S12"	SV-1-T	T	BP	49	1S-COUNT	SP-1	APS-3W TSP EQUIPMENT
⑦	PPB POST									APS-3W
⑧	PPB POST									APS-3W
⑨	PPB POST									APS-3W
Ⓐ	SL									

NOTES:

CONTROLLER FOUNDATION TYPE: STANDARD

4/5/22	NEW APS & 3 PPB POSTS PER 2021-342 & CALTRANS PROJECT.	DYeung	GdeLeon	
10/29/16	UPGRADED ALL SIGNALS 3S8" TO 3S12"	AUy	MSallaberry	
06/14/11	ADDED PED SIGNALS FOR ALL OPEN CROSSWALKS PER SRC 2010-078	ET	HQ	
08/2001	CAD DRAWING UPDATED	TL	RO	
09/1997	BRYANT ST SIGNAL MODIFICATION CONTRACT NO.7430E	JY	TS	
NO.	DATE	DESCRIPTION	BY	APPROVED
TABLE OF REVISIONS				
CHECKOUT DRAWING THROUGH THE SID CUSTODIAN FOR THE LATEST REVISION				



SFMTA

DRAWN BY:	DATE:
AH	11/07/16
CHECKED BY:	DATE:
WT	11/14/16

SCALE
AS SHOWN
SHEET OF SHEETS
1 OF 1

TRAFFIC SIGNAL INVENTORY DIAGRAM
8TH STREET AND BRYANT STREET

CNN NO:
24199000
REV NO:
5