


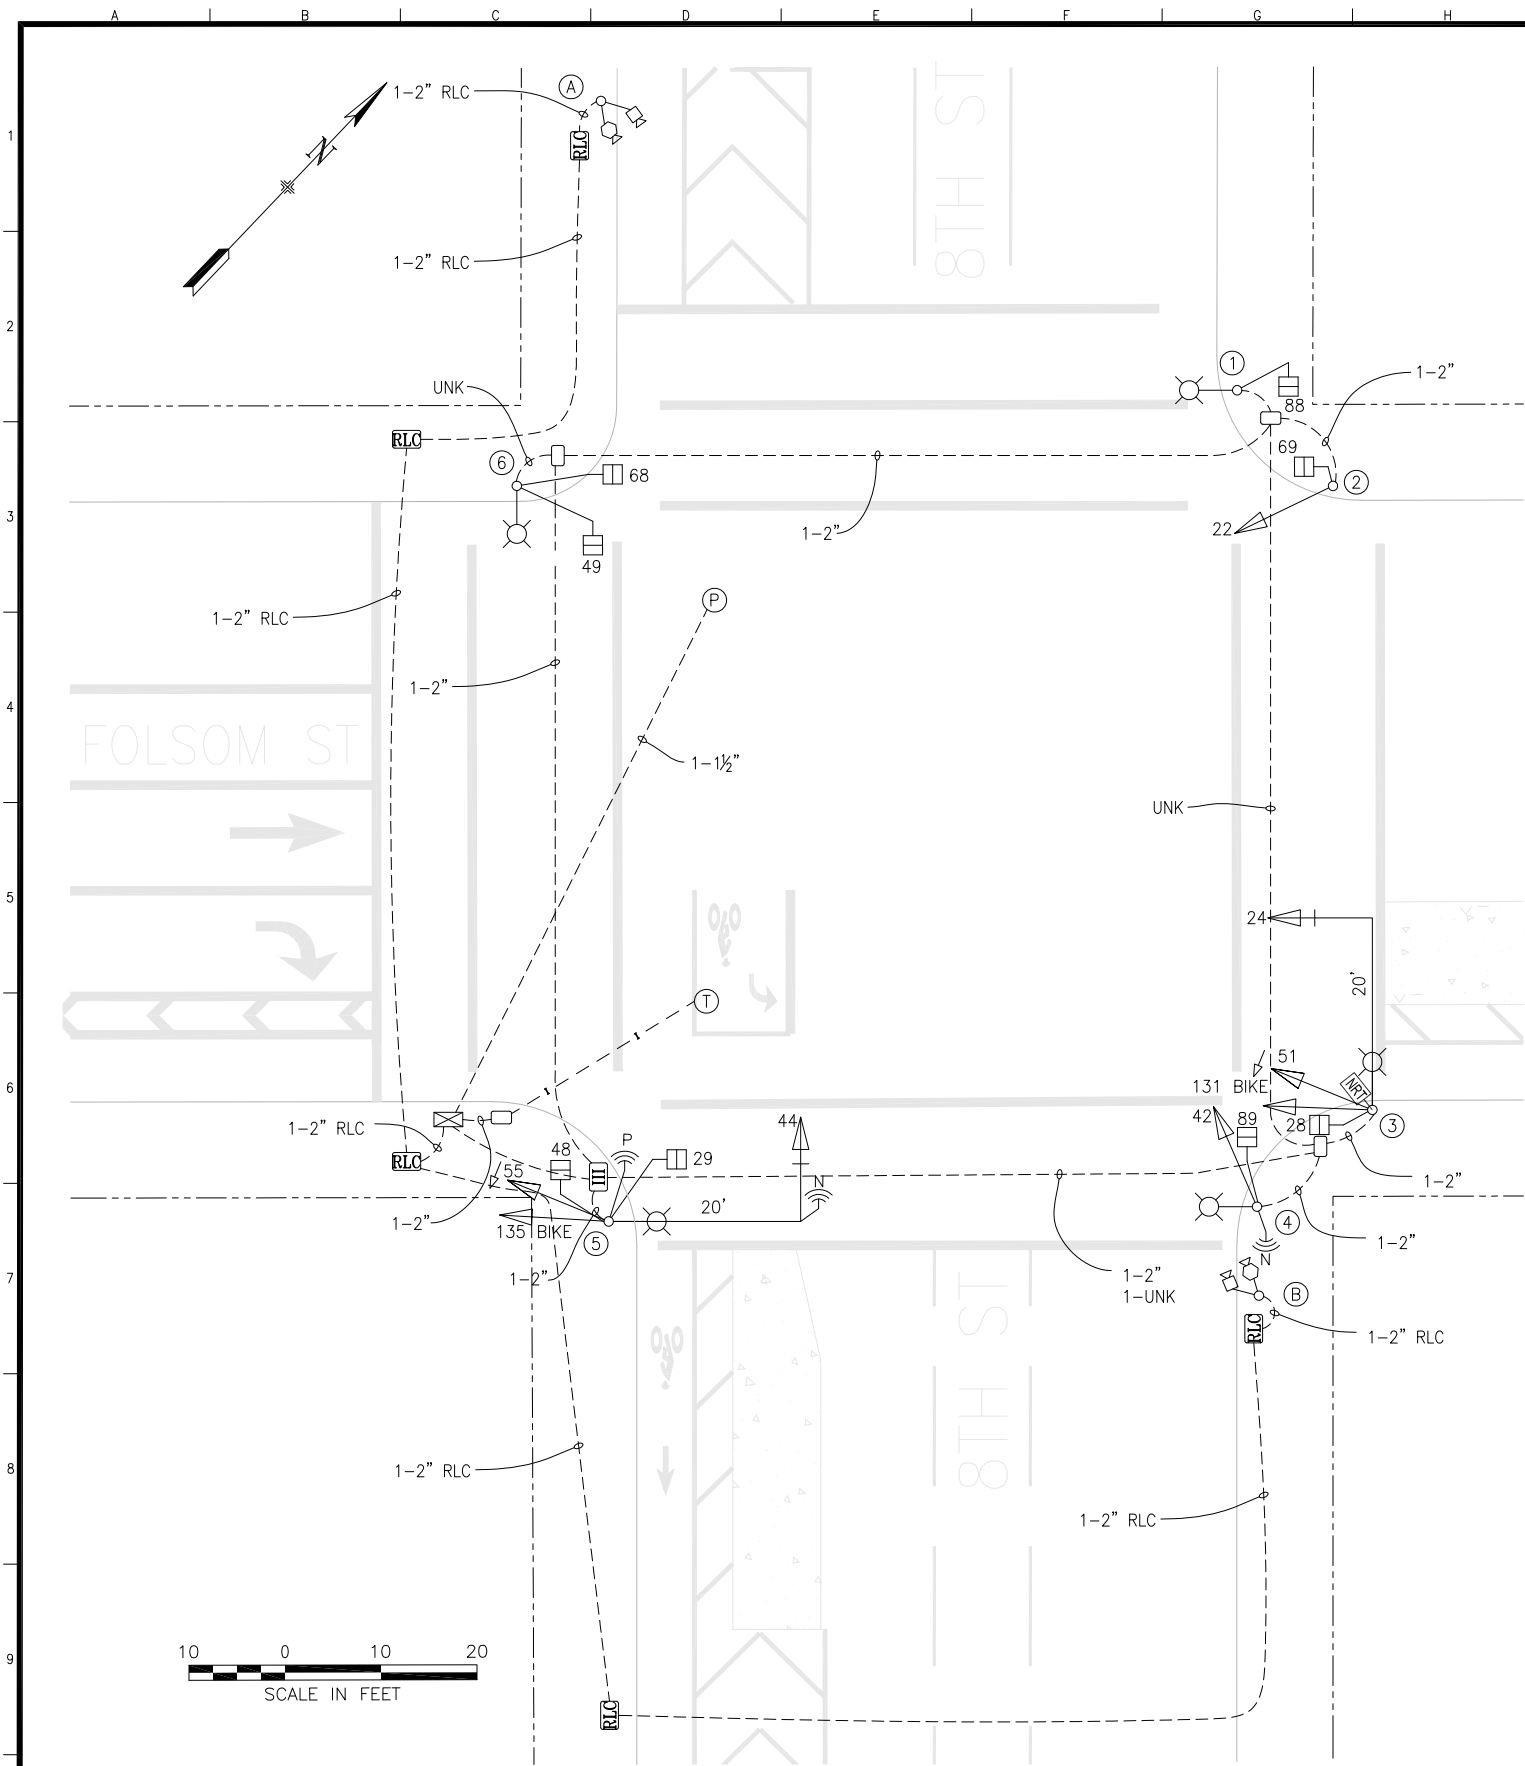

POLE AND EQUIPMENT SCHEDULE										
POLE No.	TYPE OF POLE	VEHICLE SIGNAL					PEDESTRIAN SIGNAL			REMARKS
		No.	TYPE	MOUNTING	VISORS	LOUVERS	No.	TYPE	MOUNTING	
①	SL						88	1S-COUNT	SP-1	
②	1-A (10')	22	3S12"	TV-1-T	T		69	1S-COUNT	SP-1	
③	17B-1-70 W/ 20' MAST ARM AND 6' LUMINAIRE ARM	24 51 131 NRT	3S12" 3S12"RA 3S12"BIKE IS 24"X24"	MAS SV-2-TC SV-1	T T T		28	1S-COUNT	SP-1	BP MOUNT 51 & 131 ON W SIDE OF POLE MOUNT NRT @17'
④	SL	42	3S12"	SV-1-T	T		89	1S-COUNT	SP-1	NETWORK RADIO
⑤	17B-1-70 W/ 20' MAST ARM AND 6' LUMINAIRE ARM	44 55 135	3S12" 3S12"RA 3S12"BIKE	MAS SV-2-T-SF	T T T		29 48	1S-COUNT 1S-COUNT	SP-1-SF(12") SP-1 (22")	BP NETWORK RADIO PREEMPT RADIO
⑥	SL						49 68	1S-COUNT 1S-COUNT	SP-1-SF(12") SP-1 (22")	
Ⓐ	REAR RLC POLE (20')									REAR CAMERA STROBE ATS CABINET
Ⓑ	FRONT RLC POLE (15')									FRONT CAMERA STROBE x2 3D RADAR SSCI CTRL BOX

△ SRC 2017-380
△ SRC 2018-086 (NRT)

NO.	DATE	DESCRIPTION	BY	APPROVED
1	07/15/19	ACTIVATE RLC SYSTEM; CONVERTED FROM 2855J AS-BUILTS	JHornbostel	GdeLeon
2	03/23/18	ADD NRT BLANKOUT, & BIKE AND RIGHT TURN HEADS FOR EB FOLSOM	JHChimento	MGrowney
3	10/29/16	UPGRADED ALL SIGNALS 3S8" TO 3S12"	AUy	MSallaberry
4	05/12/04	CONVERTED FROM 0435J AS-BUILTS	AUy	MSallaberry

TABLE OF REVISIONS
CHECKOUT DRAWING THROUGH THE SID CUSTODIAN FOR THE LATEST REVISION



SFMTA

DRAWN BY:	DATE:
A. HO	11/07/16
CHECKED BY:	DATE:
W. TABAJONDA	11/14/16

SCALE
AS SHOWN
SHEET OF SHEETS
01 OF 01

TRAFFIC SIGNAL INVENTORY DIAGRAM
8TH ST AND FOLSOM ST

CNN NO:
24272000
REV NO:
3