


8th ST., GROVE, HYDE, MARKET

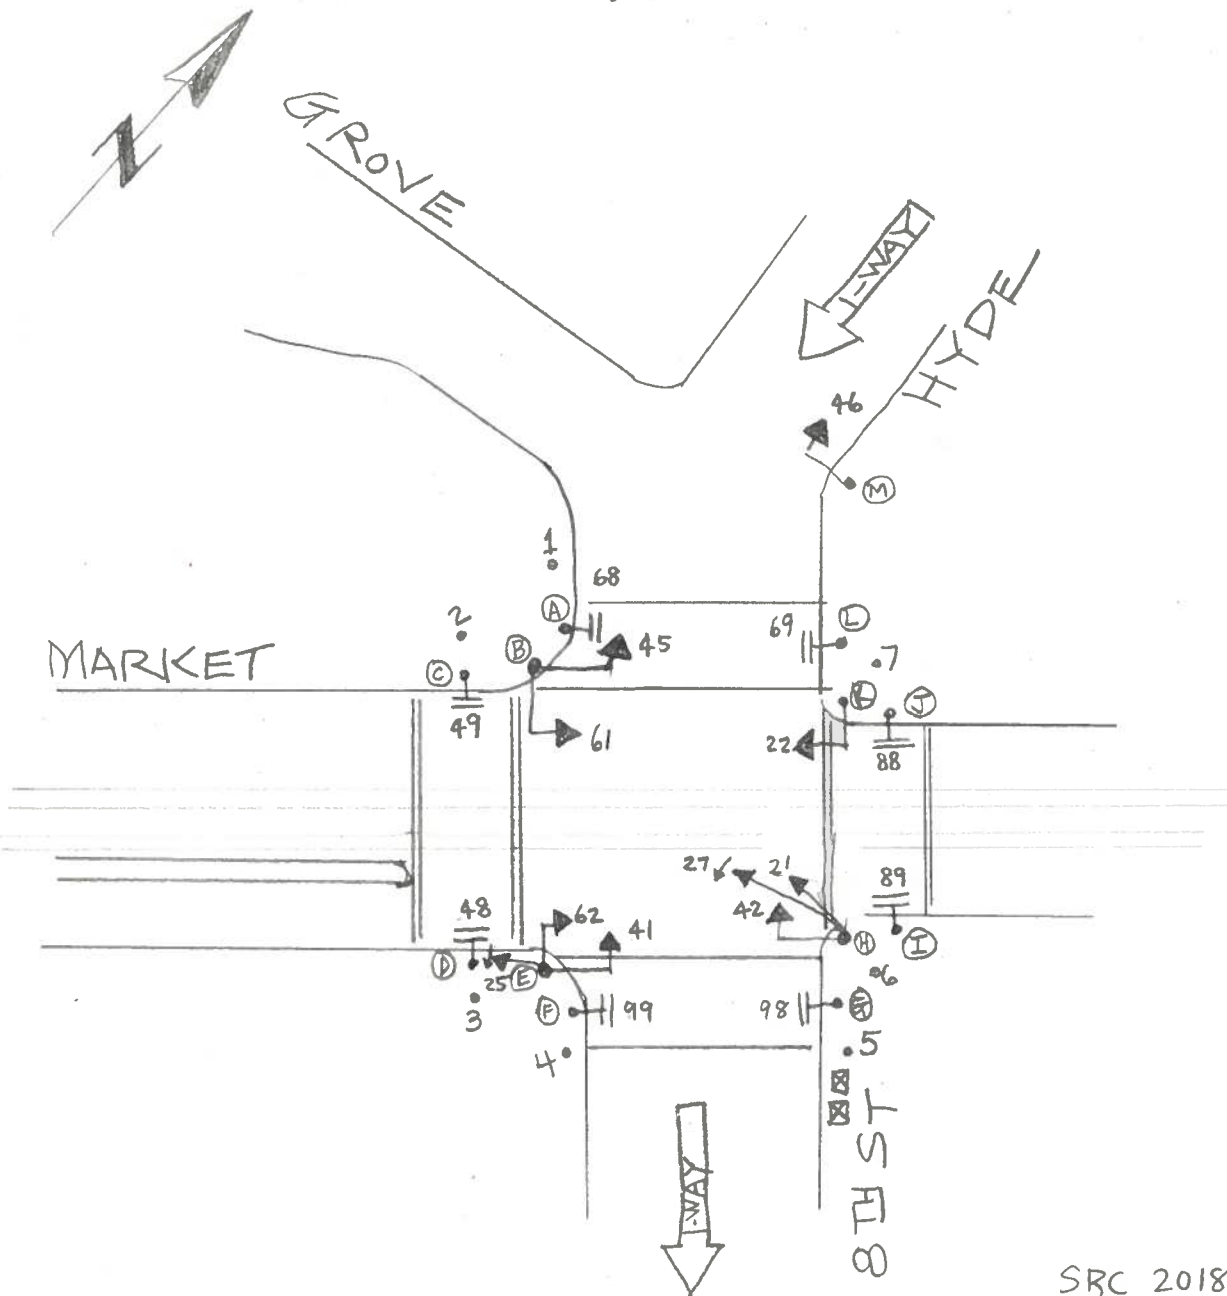

SRC 2018-058
2/25/18

Changed Phase Numbers (2016):

$\Phi 0 \rightarrow \Phi 6$

$\Phi 1 \rightarrow \Phi 2$

$\Phi 2 \rightarrow \Phi 4$

$\Phi 3P \rightarrow \Phi 8P$

Changed Phase Numbers (2018):

$\Phi 2P \rightarrow \Phi 9P$

8th ST, GROVE, HYDE & MARKET

(Completed 3-3-16)

SRC 2018-058

NEW PHASE NUMBERS - ET 2015-418

DATE: 2-25-18

POLE	FUNC	MATL	SIGNAL NO.	MAKE	NO. OF SECT.	SIZE	VISOR	B.P. or LOUVERS	MOUN'T	PED SIGNAL NO.	LEGEND	MESSAGE		MAKE	MOUN'
												ELEMENT	COLOR		
A	S	S	45	—	3	8"	FC8"	BP	*	49	COUNTDOWN	IS-COUNT	W/OR	ICC	T
B	S	S	61	—	3	8"	FC8"	BP	*	48	COUNTDOWN	IS-COUNT	W/OR	ICC	T
C	S	S	62	—	3	8"	FC8"	BP	*	29	COUNTDOWN	IS-COUNT	W/OR	ICC	T
D	S	S	41	—	3	8"	FC8"	BP	*	28	COUNTDOWN	IS-COUNT	W/OR	ICC	T
E	S	S	42	—	3	8"	FC8"	BP	*	89	COUNTDOWN	IS-COUNT	W/OR	ICC	T
F	S	S	21	—	3	12"	T	BP	S	88	COUNTDOWN	IS-COUNT	W/OR	ICC	T
G	S	S	22	—	3	8"	FC8"	BP	*	69	COUNTDOWN	IS-COUNT	W/OR	ICC	T
H	S	S	46	—	3	8"	FC8"	BP	*	68	COUNTDOWN	IS-COUNT	W/OR	ICC	T
I	S	S	27	—	4	12" RYGG	FC12"	N/A	S						
J	S	S	25	—	4	12" RYGG	FC12"	NA	S						
K	S	S													
L	S	S													
M	S	S													

POLE	FUNC	MATL	SIGNAL NO.	MAKE	NO. OF SECT.	SIZE	VISOR	B.P. or LOUVERS	MOUN'T	PED SIGNAL NO.	LEGEND	MESSAGE		MAKE	MOUN'
												ELEMENT	COLOR		
1	M	S													
2	L	O													
3	L	O													
4	M	S													
5	M	S													
6	L	O													
7	L	O													

CONTROLLER CABINET SIZE: ORDINARY BASE CABINET: 1-yes

COMMENTS: * MARKET STREET MASTARM SIGNALS

SRC 2018-058: Upgrade signal 21 on pole (H) to 3S12" side-mounted signal w/ backplate.