




POLE AND EQUIPMENT SCHEDULE											
POLE No.	TYPE OF POLE	LUMINAIRE (HPS)	VEHICLE SIGNAL					PEDESTRIAN SIGNAL			REMARKS
		VOLTAGE/ WATTS	No.	TYPE	MOUNTING	VISORS	LOUVERS	No.	TYPE	MOUNTING	
①	CITY STANDARD SL WITH 10' LUMINAIRE ARM	120/200	95 42	3S12" 3S12"	SV-1-T @13' SV-1-T	T T		818 89	1S-COUNT 1S-COUNT	SP-1 SP-1	BP BP
②	CITY STANDARD SL WITH 6' LUMINAIRE ARM	120/200						69 88	1S-COUNT 1S-COUNT	SP-1 SP-1	APS-3W APS-3W
③	CITY STANDARD SL WITH 6' LUMINAIRE ARM	120/200	75 145	3S12"RA 3S8"BIKE	SV-1-T SV-1	T T		49 68	1S-COUNT 1S-COUNT	SP-1 SP-1	APS-3W MOUNT 75 @ 13' MOUNT 145 @ 8'
④	17B-1-70 W/ 20' MAST ARM AND 6' LUMINAIRE ARM.	120/200	61 91 64	3S12" 3S12" 3S12"	SV-2-TA MAS	WITH RIGHT ANGLE VISOR WITH LEFT ANGLE VISOR WITH RIGHT ANGLE VISOR	VERT				BP BP BP APS-3W
⑤	1-A (10')		62 92	3S12" 3S12"	TV-2-T-SFB	WITH RIGHT ANGLE VISOR WITH LEFT ANGLE VISOR		48	1S-COUNT	SP-1	APS-3W APS-3W
⑥	17B-1-70 W/ 20' MAST ARM AND 6' LUMINAIRE ARM.	120/200	44 NRT 71 141	3S12"GVA IS 24"x24" 3S12" RA 3S12" BIKE	MAS SV-1 SV-2-TA	T T T		29	1S-COUNT	SP-1	BP BP APS-3W APS-3W
⑦	CITY STANDARD SL WITH 6' LUMINAIRE ARM	120/200	43	3S12"	SV-1-T	T		819	1S-COUNT	SP-1	BP APS-3W
⑧	1-A (10')		96	3S12"	TV-1-T	T		28	1S-COUNT	SP-1	BP APS-3W
⑨	PPB POST										APS-3W
⑩	PPB POST										APS-3W

NO.	DATE	DESCRIPTION	BY	APPROVED
4/5/22		NEW APS & 2 PPB POSTS PER 2021-342 & CALTRANS PROJECT. PER FIELD: REGULAR SP-1 FOR 68.	DYeung	GdeLeon
06/18/19		PER SRC 2019-078, ADDED SIGNALS 71, 75, 141, 145, NRT SIGN	AUy	MSallaberry
10/29/16		UPGRADED ALL SIGNALS 3S8" TO 3S12"	AUy	MSallaberry
09/27/99		CONVERTED FROM 1167N AS-BUILTS	AUy	MSallaberry
NO.	DATE	DESCRIPTION	BY	APPROVED
TABLE OF REVISIONS CHECKOUT DRAWING THROUGH THE SID CUSTODIAN FOR THE LATEST REVISION				

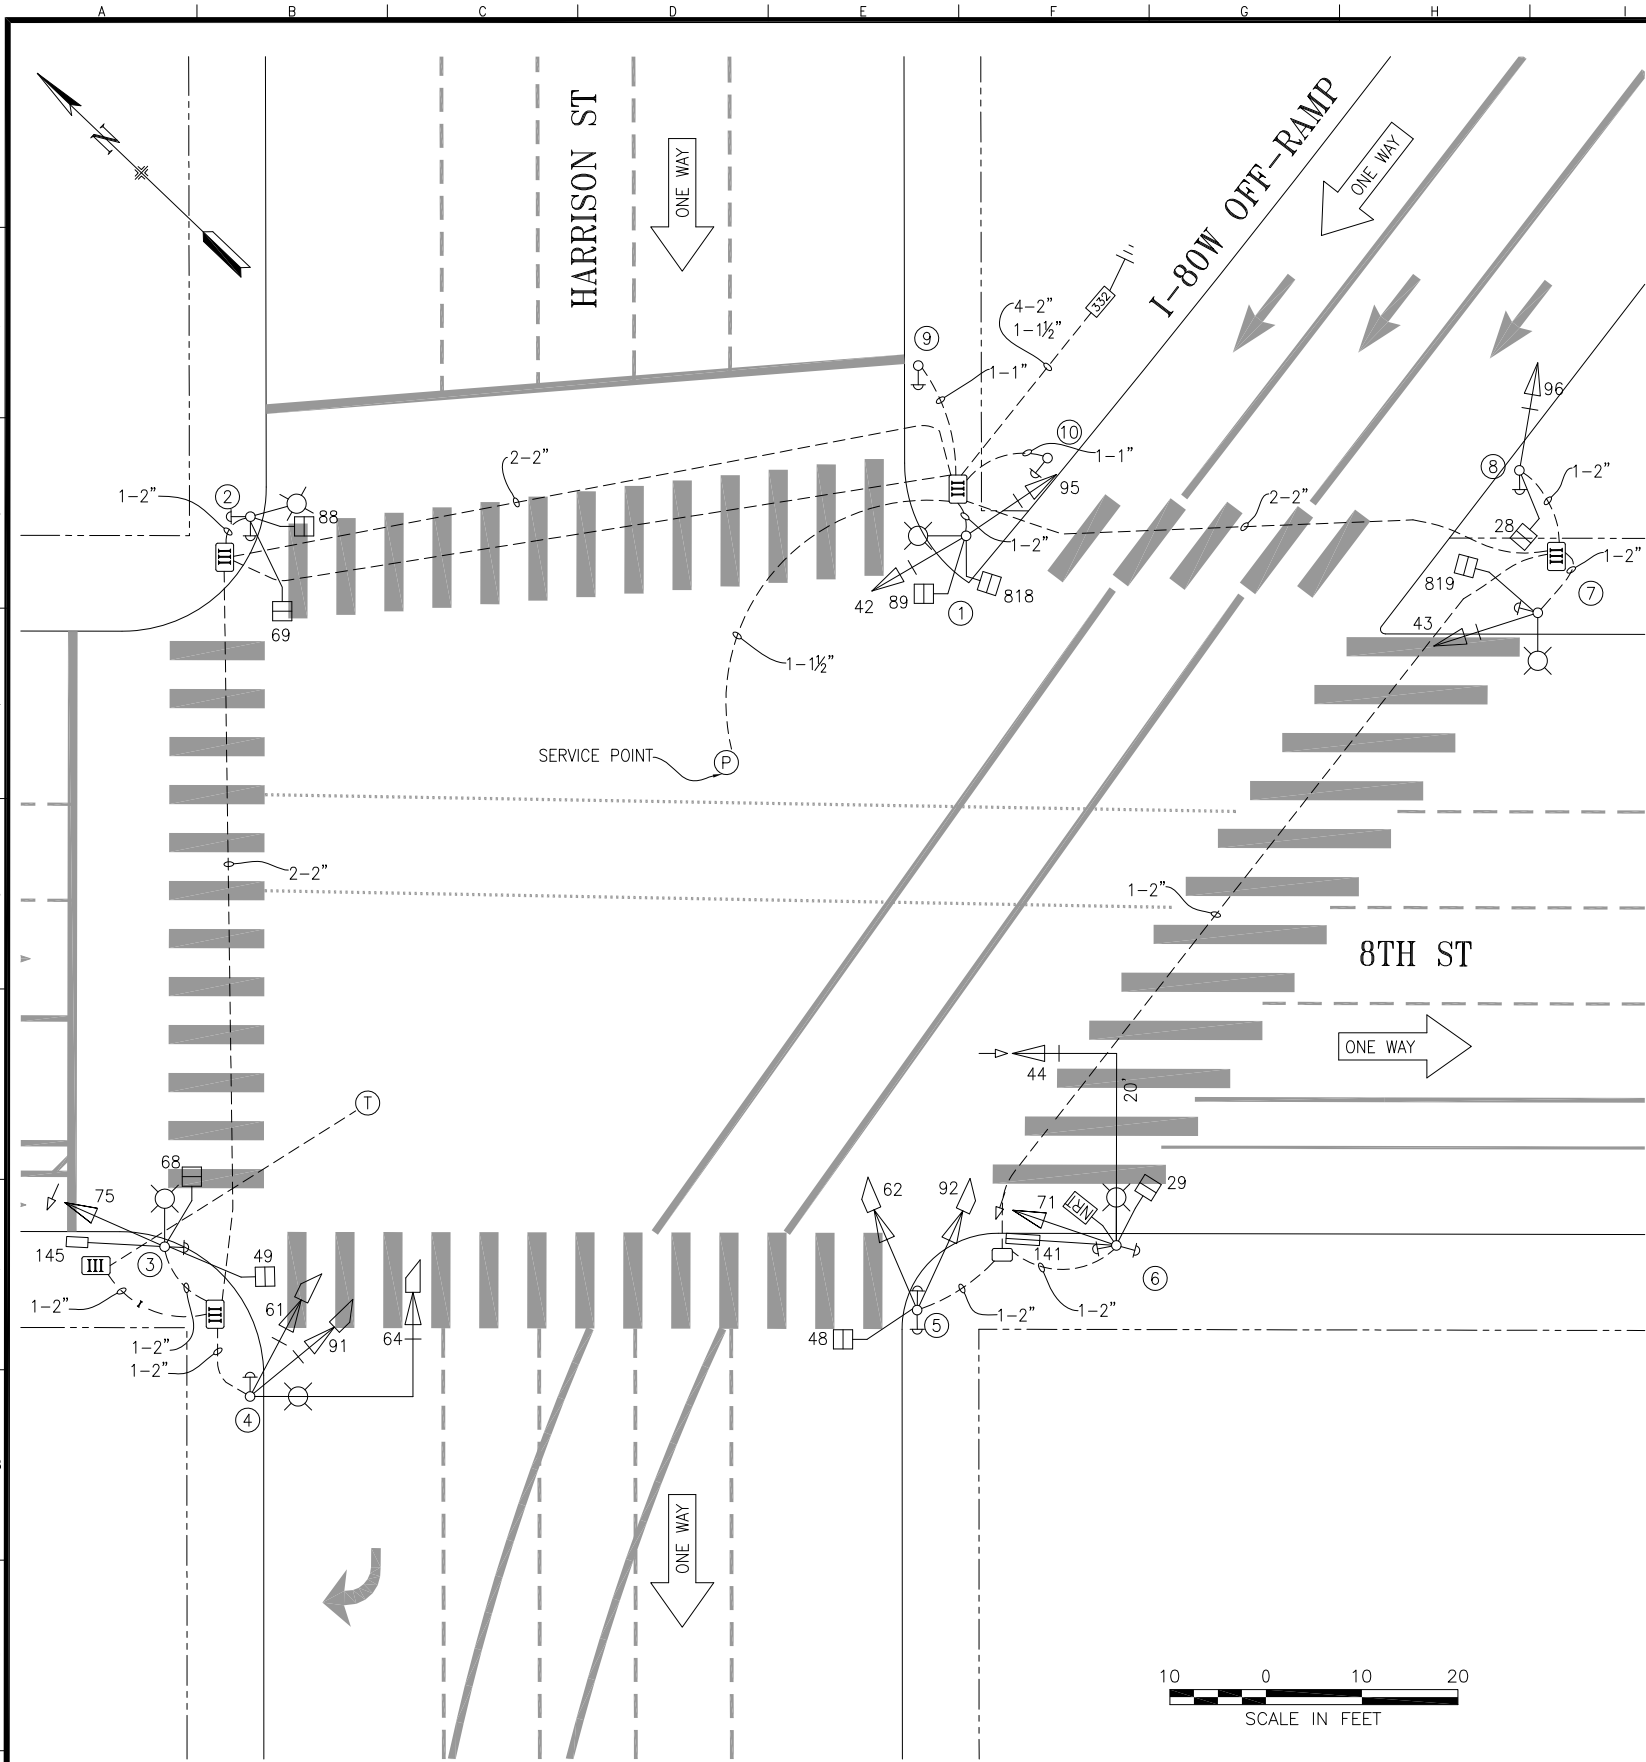

SFMTA

DRAWN BY:	DATE:
AH	11/07/16
CHECKED BY:	DATE:
WT	11/14/16

SCALE
AS SHOWN
SHEET OF SHEETS
1 OF 1

TRAFFIC SIGNAL INVENTORY DIAGRAM
8TH STREET AND HARRISON STREET

CNN NO:
24201000
REV NO:
3