


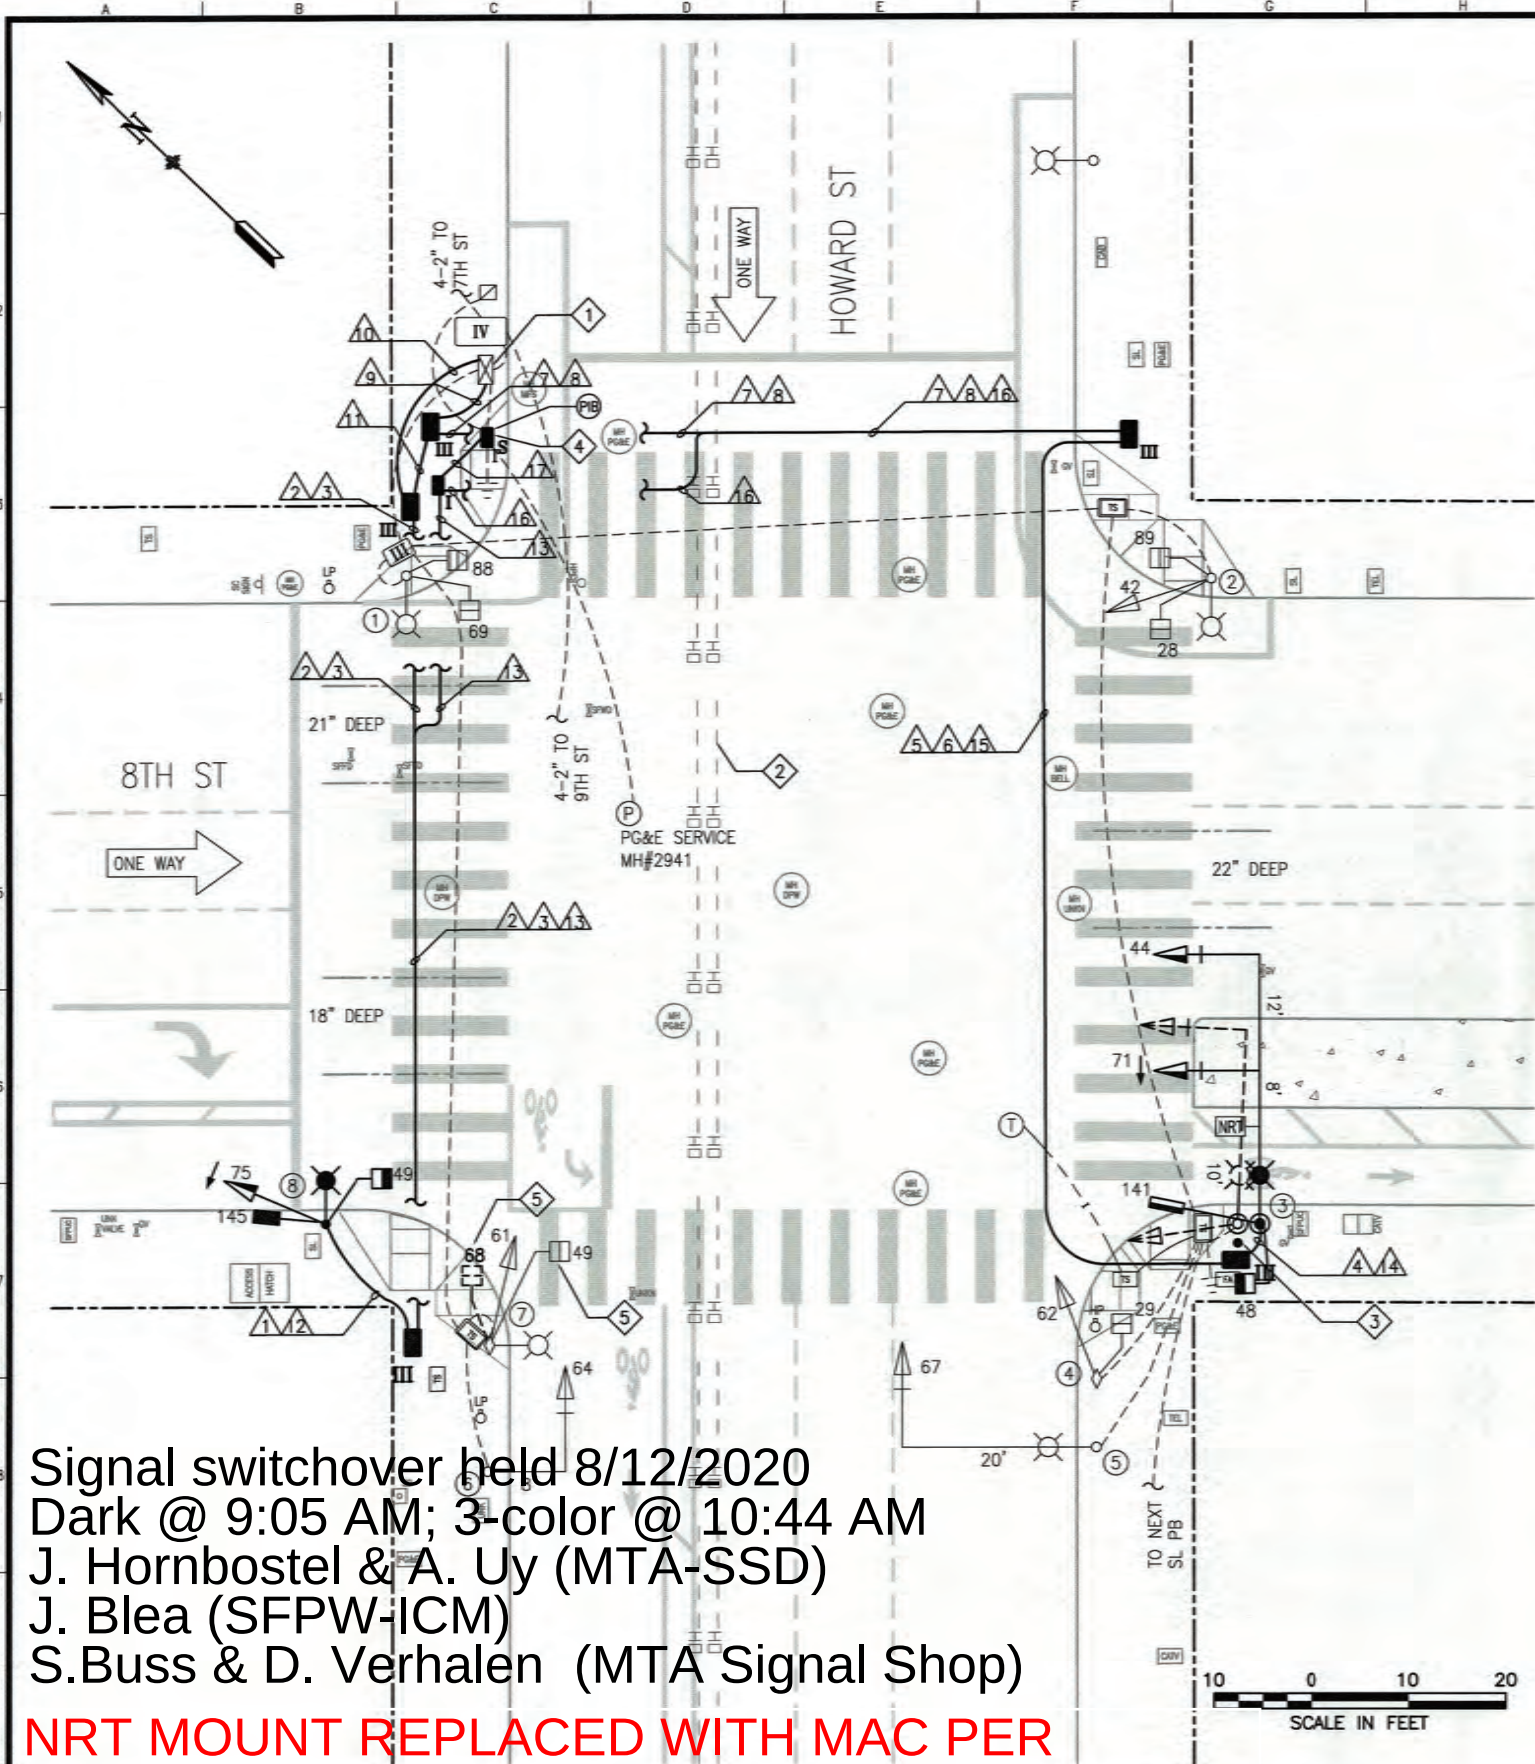


POLE AND EQUIPMENT SCHEDULE										
POLE No.	TYPE OF POLE	LUMINAIRE VOLTAGE/WATTAGE	VEHICLE SIGNAL					PEDESTRIAN SIGNAL		
			No.	TYPE	MOUNTING	VISORS	LOUVERS	No.	TYPE	MOUNTING
①	CITY STANDARD STREETLIGHT	108W						69 88	1S-COUNT 1S-COUNT	SP-1-SF (12") SP-1 (22")
②	CITY STANDARD STREETLIGHT	108W	42	3S12"	SV-1-T	T		28 89	1S-COUNT 1S-COUNT	SP-1-SF (12") SP-1 (22")
③	19-4-100 W/ 30' MAST ARM AND 6' LUMINAIRE ARM	⬡ 108	44 71 NRT 141	3S12" GVA 3S12" RA IS 24"X24" 3S12" BIKE	MAS MAS -MAT- SV-1-T	T T MAC T		48	1S-COUNT	SP-1
④	MUNI		62	3S12"	SV-1-T	T		29	1S-COUNT	SP-1-T
⑤	17B-1-70 W/ 20' MAST ARM AND 6' LUMINAIRE ARM	108W	67	3S12"	MAS	T				
⑥	16-1-70 W/ 8' MAST ARM		64	3S12"	MAS	T				
⑦	MUNI	108W	61	3S12"	SV-1-T	T		68	1S-COUNT	SP-1-T
⑧	CITY STANDARD STREETLIGHT	⬡ 108	75 145	3S12" RA 3S8" BIKE	SV-1-T SV-1	T T		49	1S-COUNT	SP-1

SHEET NOTES:

- ① CAREFULLY CHIP INTO CONTROLLER CABINET FOUNDATION TO BRING IN NEW CONDUITS #9 AND #10
- ② EXERCISE CAUTION TO AVOID CONFLICT WITH OVERHEAD MUNI WIRES AT THIS INTERSECTION
- ③ R/C FIRE ALARM POLE AND CONDUIT FROM POLE TO FIRE ALARM PULL BOX. PULL BOX TO REMAIN
- ④ SPLICE NEW STREET LIGHT WIRES INTO EXISTING TRAFFIC SIGNAL SERVICE AND PROVIDE 15A INLINE FUSE & FUSE HOLDER FOR STREET LIGHTING DISCONNECT DUE TO UNKNOWN EXISTING SERVICE LOAD
- ⑤ R/C EXISTING PED SIGNAL #68 AND CAP FRAMEWORK. RE-AIM AND REWIRE EXISTING PED SIGNAL #49 IN TERMINAL BOX TO BECOME NEW PED SIGNAL #68
- ⑥ FOUNDATION PER STRUCTURAL DRAWINGS

PHASE DIAGRAM

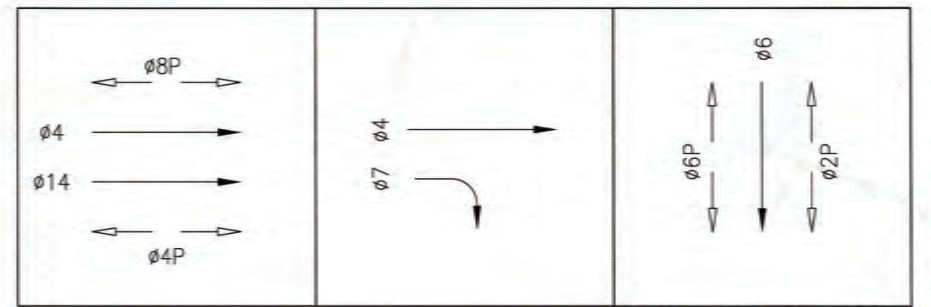

Signal switchover held 8/12/2020
 Dark @ 9:05 AM; 3-color @ 10:44 AM
 J. Hornbostel & A. Uy (MTA-SSD)
 J. Blea (SFPW-ICM)
 S.Buss & D. Verhalen (MTA Signal Shop)

NRT MOUNT REPLACED WITH MAC PER 2021-275, J.HORNBOSTEL, 10/19/2021

NO. DATE DESCRIPTION BY APP. TABLE OF REVISIONS		REFERENCE INFORMATION & FILE NO. OF SURVEYS		BUREAU OF ENGINEERING CITY & COUNTY OF SAN FRANCISCO SAN FRANCISCO PUBLIC WORKS 30 VAN NESS AVENUE, 5TH FLOOR SAN FRANCISCO, CA 94102 - 6028	Section Mgr: PHILIP THWIN Deputy Bureau Mgr: IQBALBHAI DHAPA Bureau Mgr: PATRICK RIVERA	Date: 7/29/19 7/25/19 7/26/19	DESIGNED: DATE: AU/GL 07/2019 DRAWN: DATE: AU/GL 07/2019 CHECKED: DATE: GH/SL 07/2019		SCALE: 1" = 10' SHEET OF SHEETS	CONTRACT 34 - TRAFFIC SIGNAL MODIFICATIONS TRAFFIC SIGNAL UPGRADE PCO#7 8TH STREET AND HOWARD STREET	CONTRACT NO. 2805J DRAWING NO. E-16.0 FILE NO. 109,576 REV. NO.
--	--	---	--	--	---	-------------------------------------	---	--	------------------------------------	--	--

CONDUIT AND WIRING SCHEDULE (FURNISH AND INSTALL CONDUIT AND WIRES)

[illegible]

					REFERENCE INFORMATION & FILE NO. OF SURVEYS						BUREAU OF ENGINEERING CITY & COUNTY OF SAN FRANCISCO SAN FRANCISCO PUBLIC WORKS 30 VAN NESS AVENUE, 5TH FLOOR SAN FRANCISCO, CA 94102 - 6028		Date: 7/24/19 Section Mgr: PHILIP THWIN Deputy Bureau Mgr: IQBAL BHAI DHAPA Bureau Mgr: PATRICK RIVERA		DESIGNED: DATE: 07/2019 DRAWN: DATE: 07/2019 CHECKED: DATE: 07/2019 GH/SL				SCALE: NONE SHEET OF SHEETS		CONTRACT 34 - TRAFFIC SIGNAL MODIFICATIONS CONDUIT AND WIRING SCHEDULE PCO#7 8TH STREET AND HOWARD STREET		CONTRACT NO. 2805J DRAWING NO. E-16.1 FILE NO. 109,577 REV. NO.	
NO. DATE DESCRIPTION BY APP. TABLE OF REVISIONS																								