


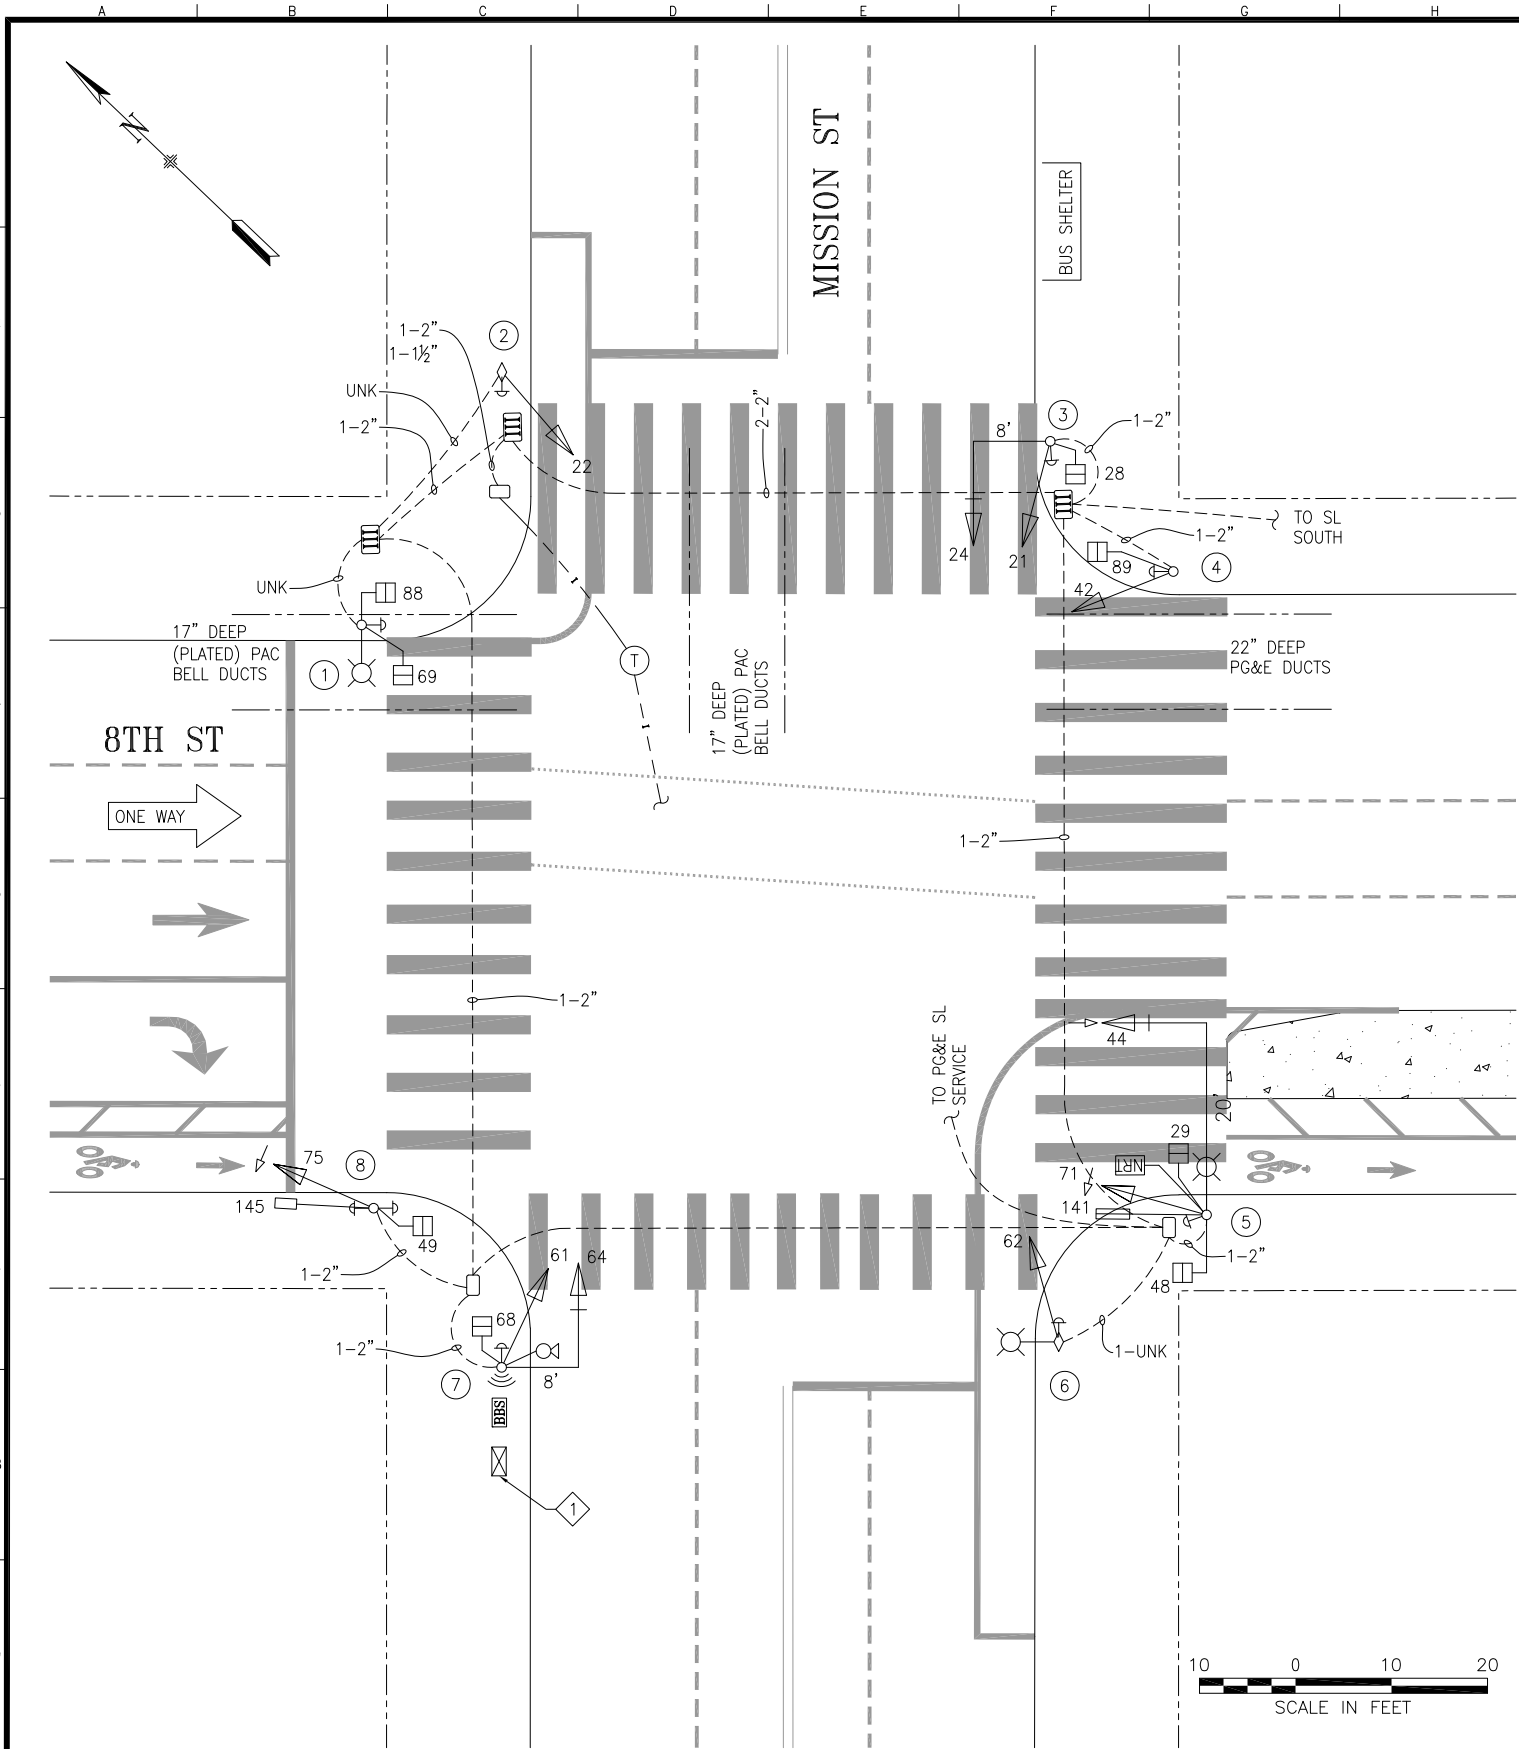

POLE AND EQUIPMENT SCHEDULE										
POLE No.	TYPE OF POLE	LUMINAIRE (HPS)	VEHICLE SIGNAL				PEDESTRIAN SIGNAL			REMARKS
		VOLTAGE/ WATTS	No.	TYPE	MOUNTING	VISORS	No.	TYPE	MOUNTING	
①	STEEL SL						69 88	1S-COUNT 1S-COUNT	SP-2-T-SF	APS-3W
②	MUNI		22	3S12"	SV-1-T	T				APS-3W
③	16-1-70 WITH 8' MAST ARM		24 21	3S12" 3S12"	MAC-SF SV-1-T	T T	28	1S-COUNT	SP-1	BACKPLATE APS-3W
④	1-A (10')		42	3S12"	TV-1-T	T	89	1S-COUNT	SP-1	APS-3W
⑤	17-1-70 WITH 20' MAST ARM AND 6' LUMINAIRE ARM	120/200	44 NRT 71 141	3S12" GVA IS 24"x24" 3S12" RA 3S12" BIKE	MAS (END) SV-1 SV-2-T (CUSTOM)	T T T	48 29	1S-COUNT 1S-COUNT	SP-1(22") SP-1-SF(12")	BACKPLATE APS-3W
⑥	MUNI		62	3S12"	SV-1-T	T				EXTERNAL CONDUIT APS-3W
⑦	16-1-70 WITH 8' MAST ARM		64 61	3S12" 3S12"	MAC-SF SV-1-T	T T	68	1S-COUNT	SP-1	BACKPLATE TSP SFgo CCTV APS-3W
⑧	1-A (13')		75 145	3S12" RA 3S8" BIKE	TV-1-T SV-1	T T	49	1S-COUNT	SP-1	APS-3W x 2 MOUNT 145 @ 8'

SHEET NOTES:

① CABINET RELOCATED FROM NORTHEAST TO SOUTHWEST CORNER 2012. CONDUIT EXTENTS UNKNOWN.

Δ	10/04/21	INSTALL APS (SRC 2021-053) PER FIELD: UPDATE POLES AND MOUNTINGS	ELuu	GdeLeon
Δ	11/16/20	SRC 2020-255: UPDATED MOUNTING FOR SIGNALS 24 AND 64	Hly	Welasco
Δ	06/18/19	PER SRC 2019-078, ADDED SIGNALS 71, 75, 141, 145, & NRT SIGN & REPLACED POLE #8	AlJy	MSallaberry
Δ	10/29/16	UPGRADED ALL SIGNALS 3S8" TO 3S12"	AlJy	MSallaberry
Δ	08/06/03	CONVERTED FROM 1663N AS-BUILTS	AlJy	MSallaberry
NO.	DATE	DESCRIPTION	BY	APPROVED
TABLE OF REVISIONS CHECKOUT DRAWING THROUGH THE SID CUSTODIAN FOR THE LATEST REVISION				



SFMTA

DRAWN BY:	DATE:
AH	11/07/16
CHECKED BY:	DATE:
WT	11/14/16

SCALE
AS SHOWN
SHEET OF SHEETS
1 OF 1

TRAFFIC SIGNAL INVENTORY DIAGRAM
8TH STREET AND MISSION STREET

CNN NO:
24311000
REV NO:
4