


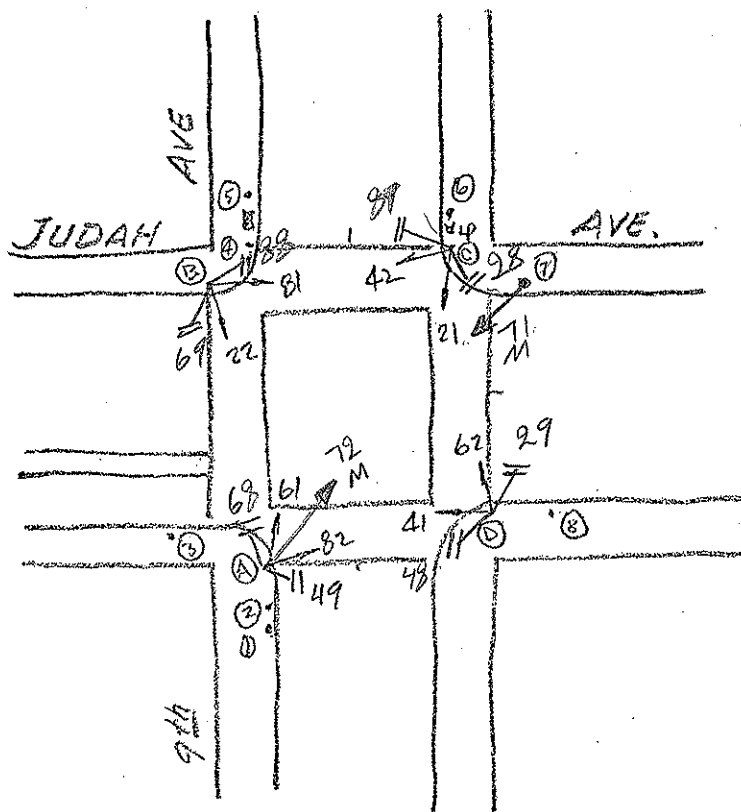

5123108

3-1-79

POLE	FUNC.	MATERIAL	SIGNAL NO.	MAKE	NO. OF SECT.	SIZE	VISOR	B.P. OR LOUVERS	MOUNT	PED SIGNAL NO.	LEGEND	MESSAGE		MAKE	MOUNT
												ELEMENT	COLOR		
A	S	C	82	EA	3	8"	FL 8"	No	T	28	I	15-C	WIR		S
B	M	S	61	EA	3	8"	FL 8"	No	T	29	I	15-C	WIR		S
C	S	C	22	GA	3	8"	FL 8"	No	S	48	I	15-C	WIR		S
D	S	C	81	GA	3	8"	FL 8"	B.P.	S	49	I	15-C	WIR		S
			42	EA	3	8"	FL 8"	No	T	68	I	15-C	WIR		S
1	U	W	21	EA	3	8"	FL 8"	No	T	69	I	15-C	WIR		S
2	M	S	62	GA	3	8"	FL 8"	No	T	88	I	15-C	WIR		S
3	M	S	41	GA	3	8"	FL 8"	No	T	89	I	15-C	WIR		S
4	U	W	71	TCT	2	12"	FC 12"	NO	T						
5	M	C	72	TCT	2	12"	FC 12"	NO	T						
6	M	S													
7	M	S													
8	M	S													

CONTROLLER CABINET SIZE : ORDINARY BASE CABINET: NO

COMMENTS :