


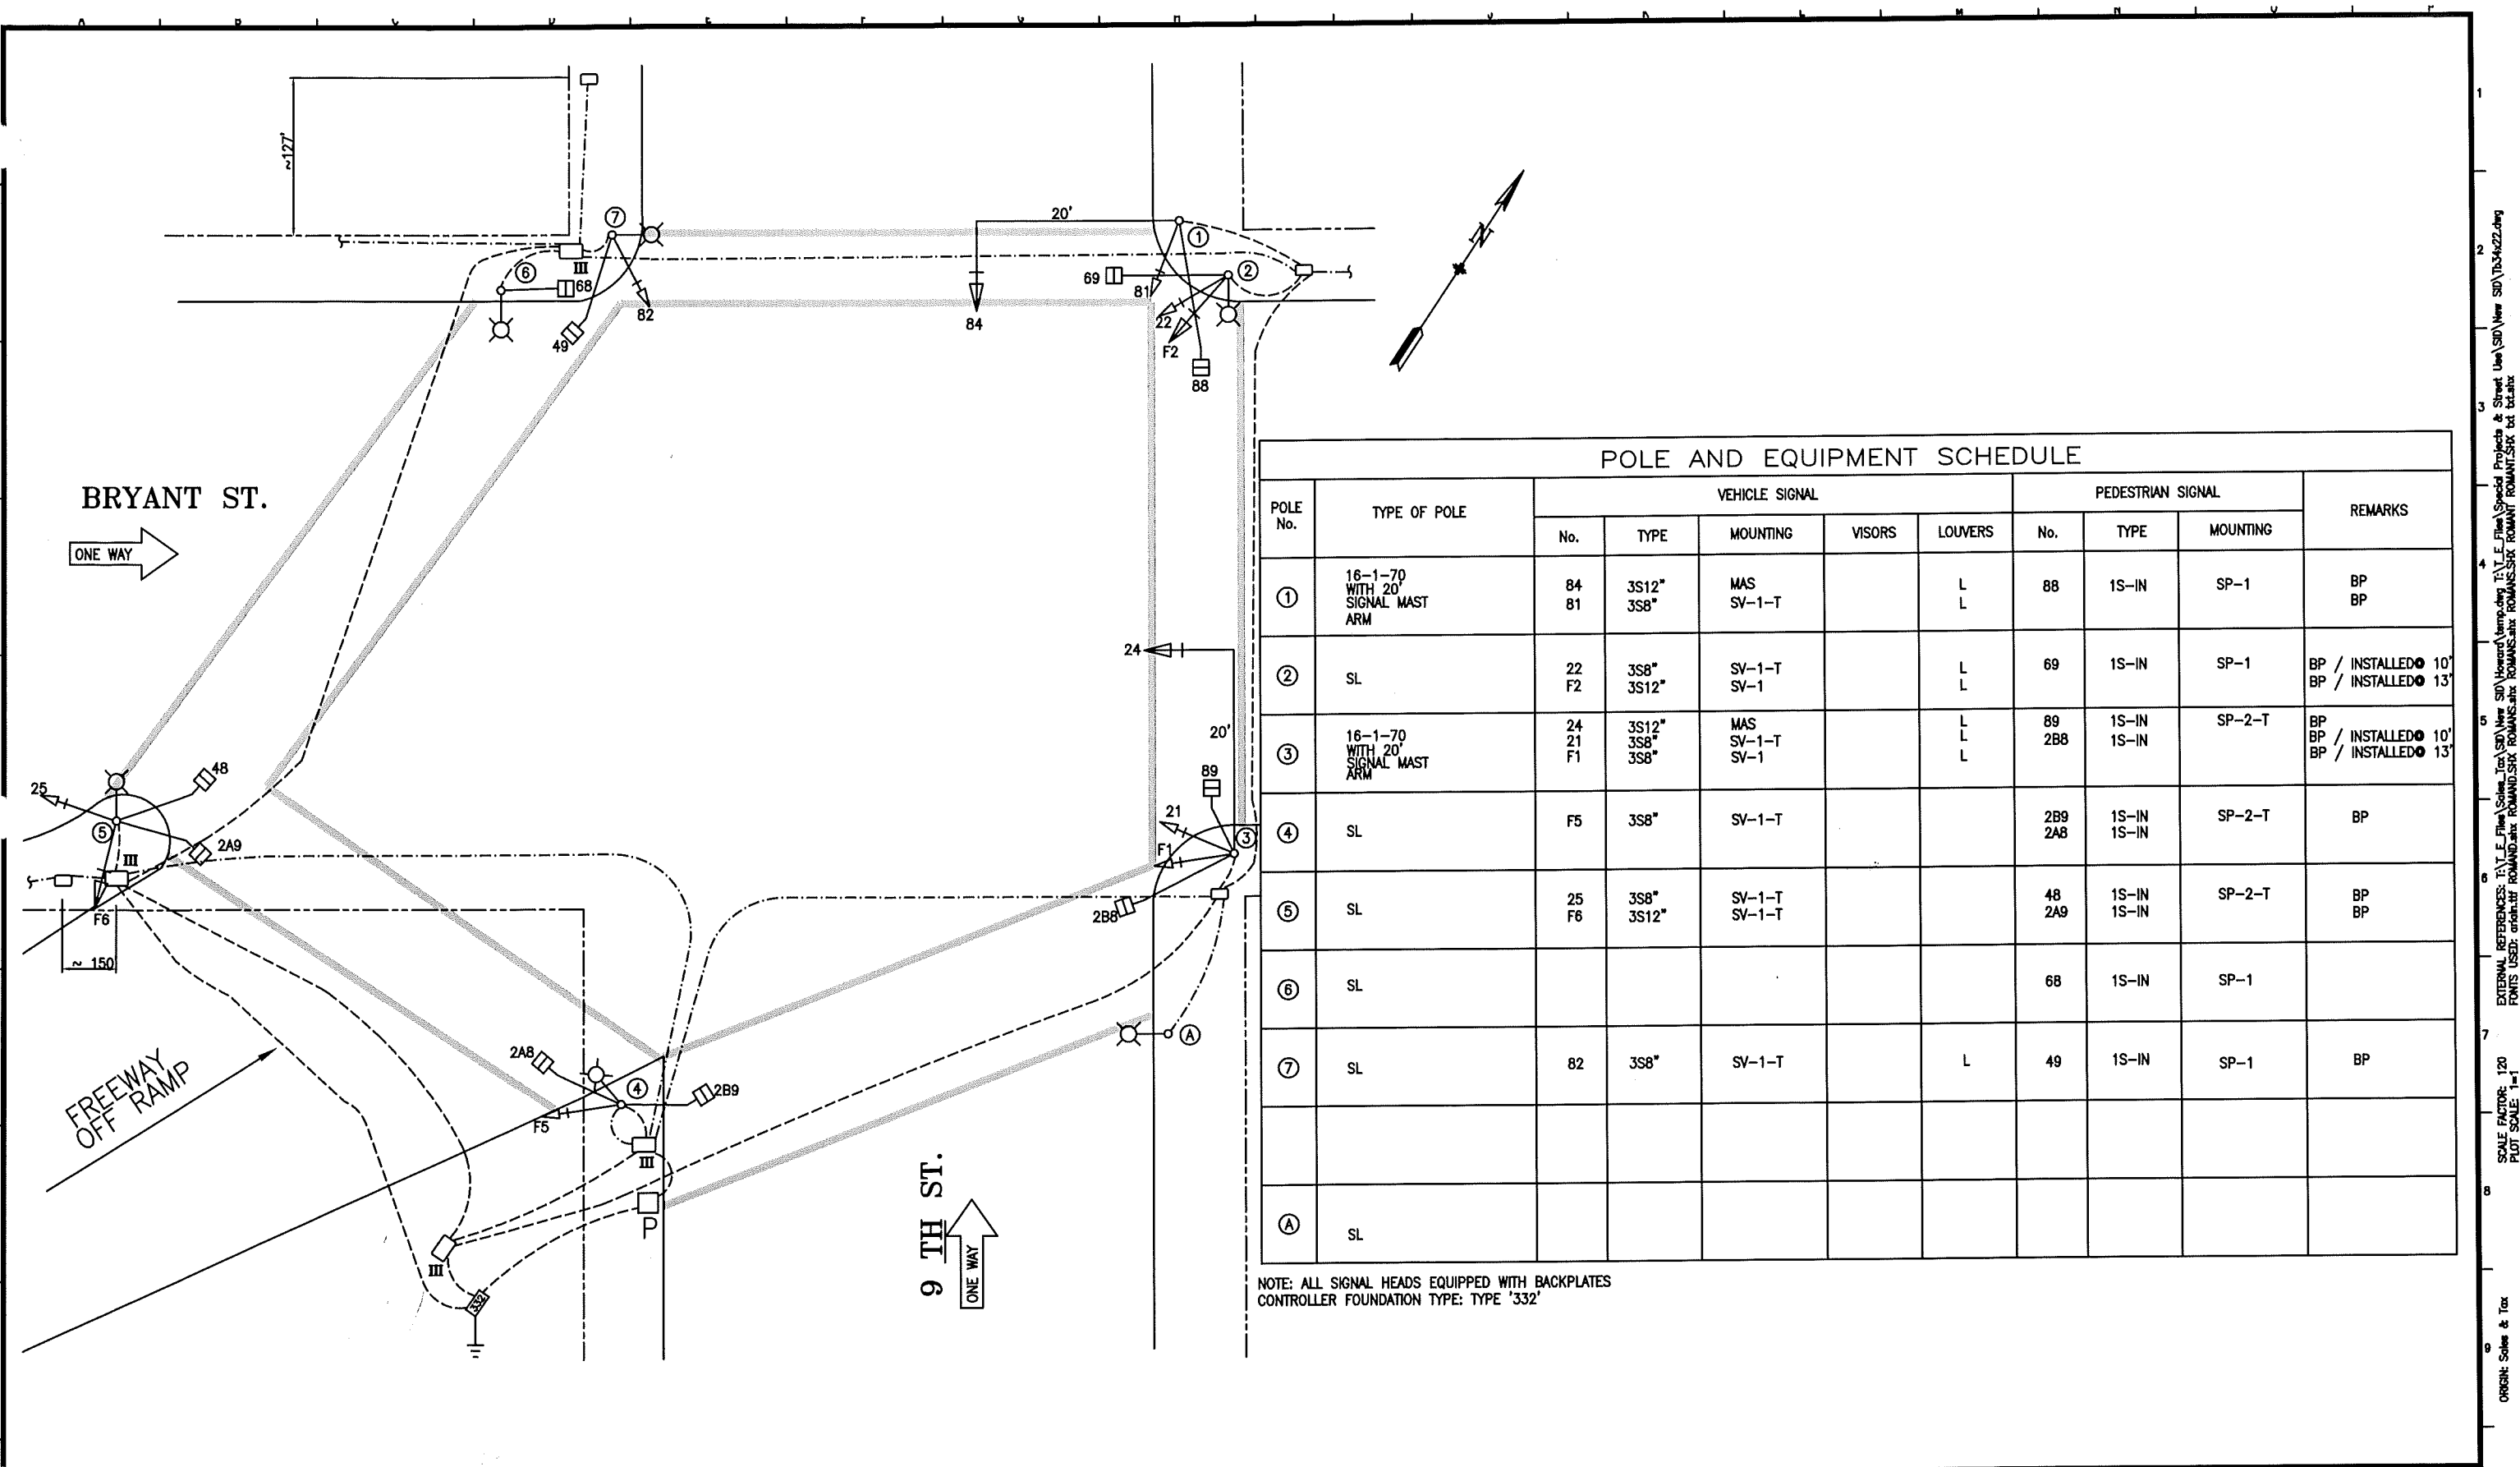

2 8/01 CAD DRAWING UPDATED		TL	RO
1 9/97 BRYANT STREET SIGNAL MODIFICATION CONTRACT NO. 7430E		JY	TS
NO. DATE DESCRIPTION		BY	APP.
TABLE OF REVISIONS		COMPLETION DATE / ELECTRICIAN INITIAL	
CHECK WITH TRACING TO SEE IF YOU HAVE LATEST REVISION			



DEPARTMENT OF PARKING AND TRAFFIC
DIVISION OF TRAFFIC ENGINEERING
CITY AND COUNTY OF SAN FRANCISCO

DRAWN: TL	DATE: 08/15/01	SCALE: 1" = 20'
CHECKED: Ro	DATE: 9/10/01	SHEET OF SHEETS: 1 OF 1

TRAFFIC SIGNAL INVENTORY DIAGRAM		CNN NO. 24198000
9TH ST & BRYANT ST		REV. NO. 2

FILE NAME: 09ST-Bryant.dwg
DATE: Aug 15 2001 13:45