


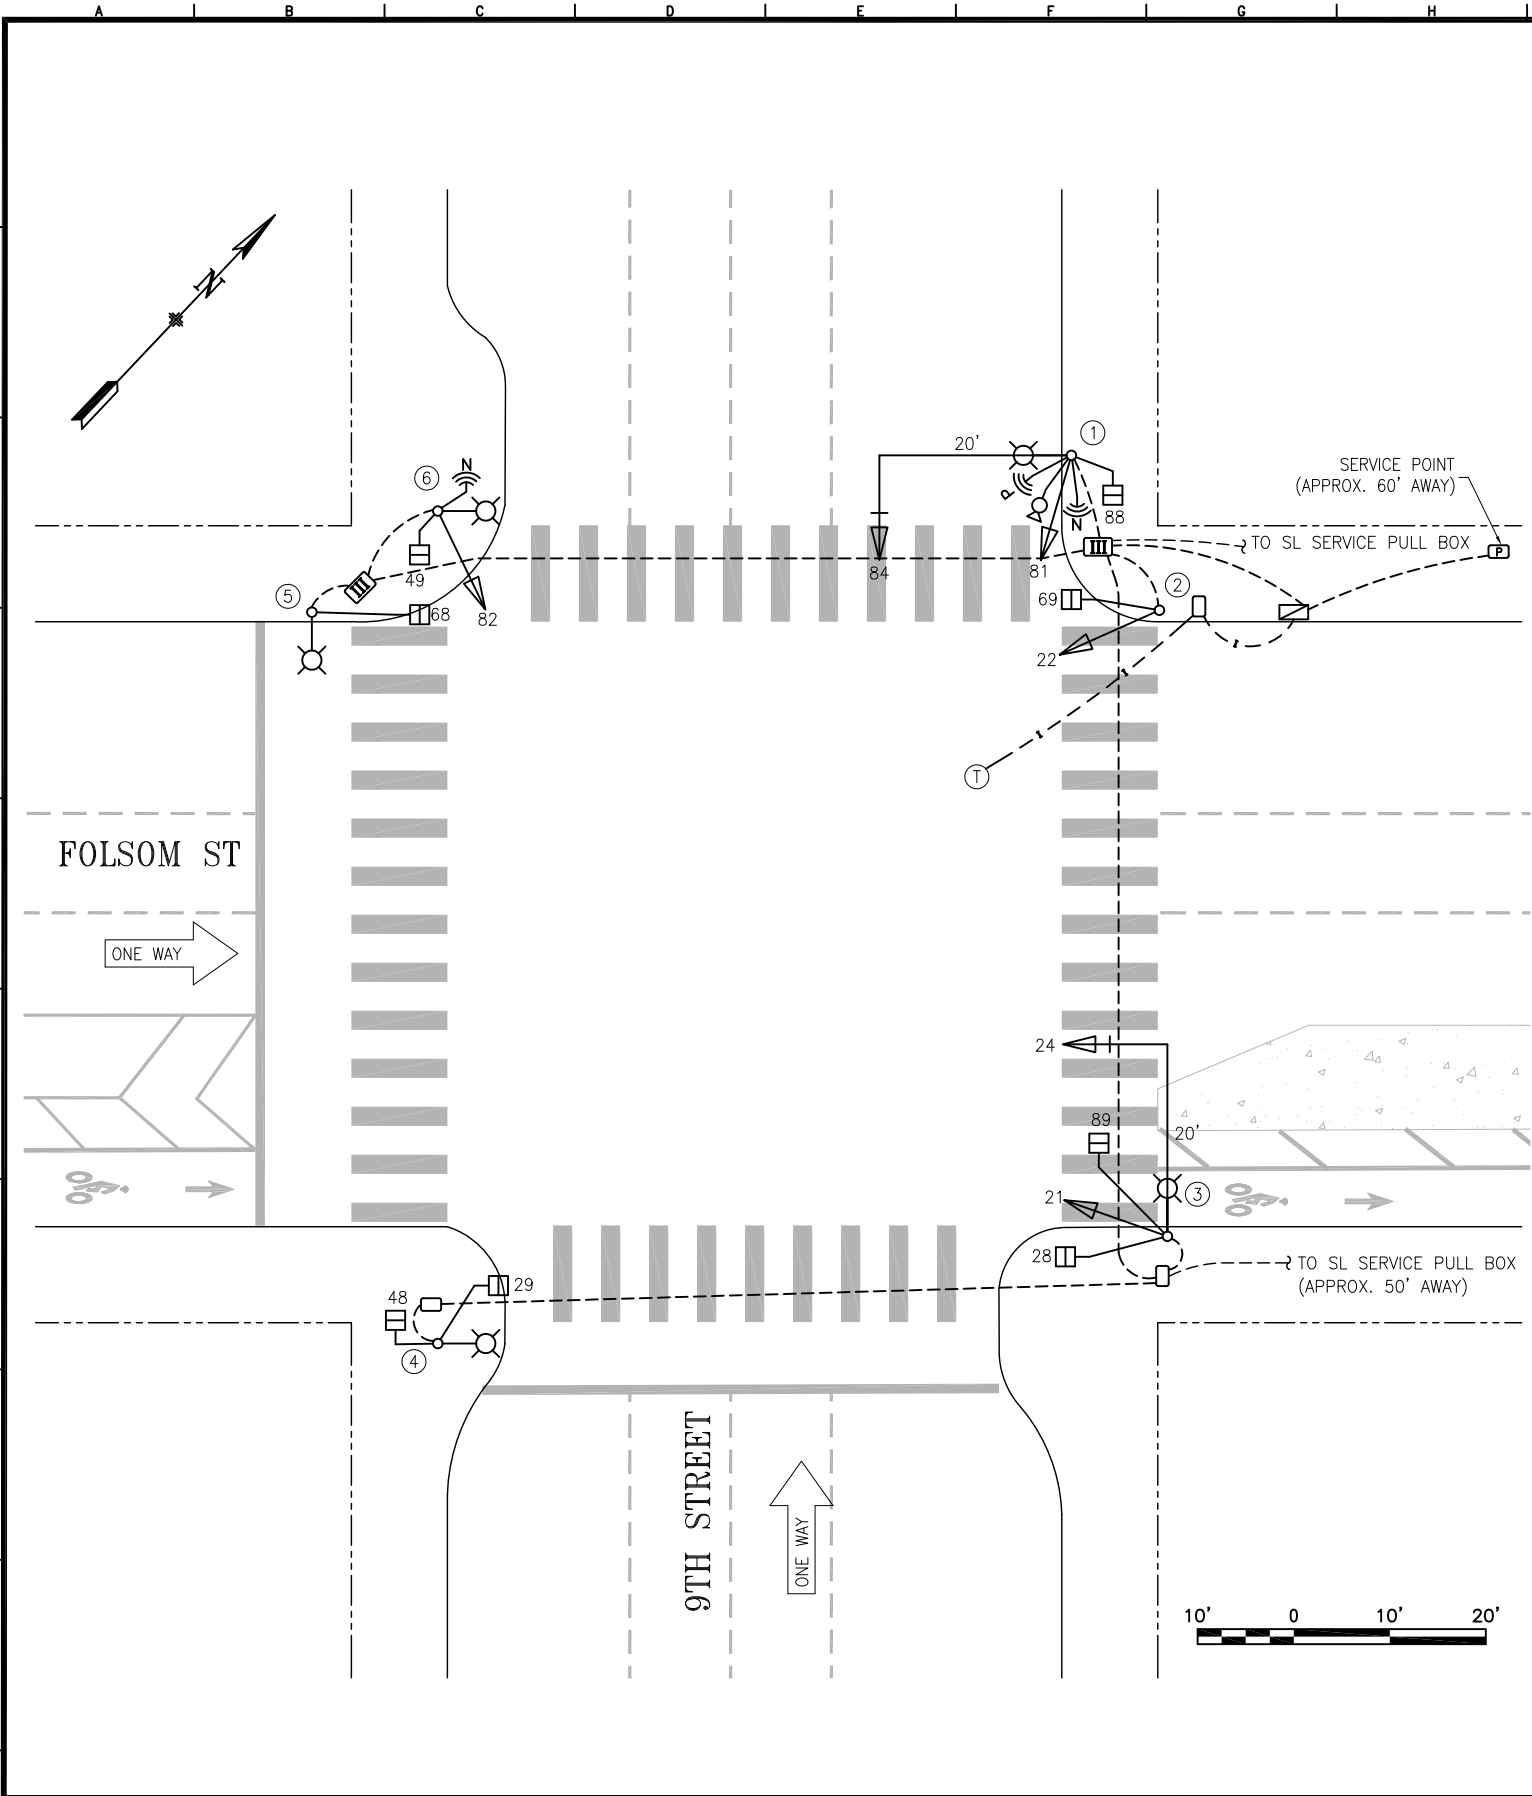

POLE AND EQUIPMENT SCHEDULE										
POLE No.	TYPE OF POLE	VEHICLE SIGNAL					PEDESTRIAN SIGNAL			REMARKS
		No.	TYPE	MOUNTING	VISORS	LOUVERS/BP	No.	TYPE	MOUNTING	
①	17B-1-70 WITH 20' MAST ARM AND 6' LUMINAIRE ARM	84 81	3S12" 3S12"	MAS SV-1-T	T T	BP	88	1S-COUNT	SP-1	CCTV CAMERA, PREEMPT RADIO, NETWORK RADIO
②	1-A (10')	22	3S12"	TV-1-T	T		69	1S-COUNT	SP-1	
③	17B-1-70 WITH 20' MAST ARM AND 6' LUMINAIRE ARM	24 21	3S12" 3S12"	MAS SV-1-T	T T	BP	28 89	1S-COUNT 1S-COUNT	SP-1(22") SP-1-SF (12")	
④	SL						29 48	1S-COUNT 1S-COUNT	SP-1-SF (12") SP-1(22")	
⑤	SL						68	1S-COUNT	SP-1	
⑥	SL	82	3S12"	SV-1-T	T		49	1S-COUNT	SP-1	NETWORK RADIO

2	09/03/22	ADDED CCTV CAMERA (SRC 2022-154);	S. ALEXANDER	M. VELASCO	
		PER FIELD: ADDED PREEMPT RADIO AND NETWORK RADIOS			
1	04/30/17	UPDATED SIGNALS #21, #22, #81, AND #82 TO 12" HEADS (SRC 2016-333)	N. KOBAYASHI	G. DELEON	
0	05/12/04	CONVERTED FROM AS-BUILT FILE #83,102 (E-6.0) OF CONTRACT 0435J	S. ALEXANDER	M. VELASCO	
NO.	DATE	DESCRIPTION	BY	APPROVED	
TABLE OF REVISIONS					
CHECKOUT DRAWING THROUGH THE SID CUSTODIAN FOR THE LATEST REVISION					



SFMTA

DRAWN BY:
S. ALEXANDER

DATE:
01/23/2023

CHECKED BY:
M. VELASCO

DATE:
06/16/2023

SCALE
AS SHOWN

SHEET OF SHEETS
1 OF 1

TRAFFIC SIGNAL INVENTORY DIAGRAM

9TH STREET & FOLSOM STREET

CNN NO:
24246000

REV NO:
2