


DRAWING INFORMATION:
FILE NAME: 11E7H20
ORIGIN: ELECTRICAL
DATE:

LIMITS:
PLOT SCALE: 1"=10'

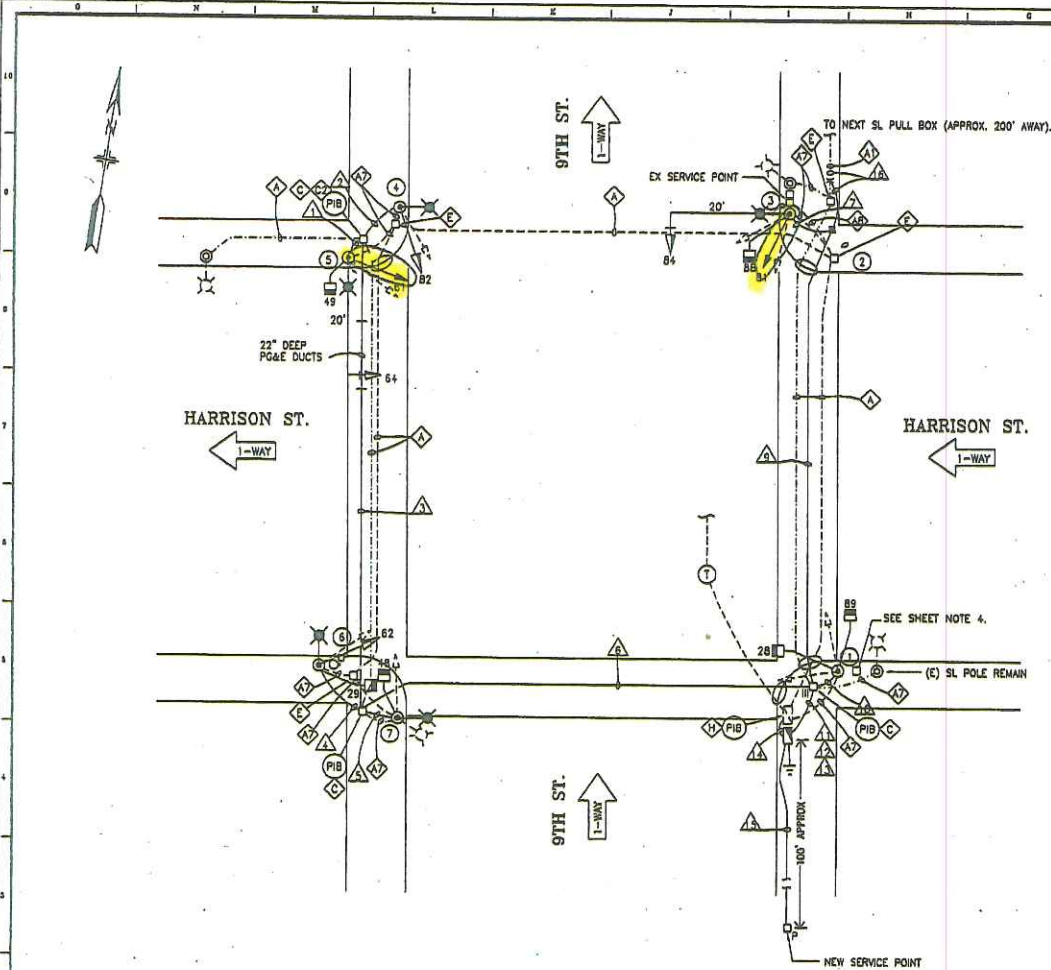


SHEET NOTES:

1. R/S ALL EX TRAFFIC SIGNALS AND MOUNTING HARDWARES, UNDO.
2. R/C ALL EX TRAFFIC SIGNAL WIRING, UNDO. RETAIN INTERCONNECT CABLE. ABANDON EX TRAFFIC SIGNAL CONDUITS, UNDO. REPAIR SIDEWALK.
3. EX TRAFFIC SIGNS AFFECTED BY THE REMOVAL OF POLES SHALL BE RELOCATED BY THE CITY.
4. DET SHALL RELOCATE FIRE/POLICE PULL BOX AT THE SOUTHEAST CORNER. CONTRACTOR SHALL COORDINATE WITH JACK DONOHUE OF DET (TEL # 415-558-2784) 10 DAYS BEFORE STARTING WORK AT THE CORNER.

DETAIL NOTES:

1. EX CONDUIT AND WIRING, R/C EX WIRING. CUT BOTH ENDS OF CONDUIT APPROX 2' FROM PULL BOX AND R/C CUT PORTION. ABANDON REMAINING CONDUIT IN PLACE.
2. EX CONDUIT AND WIRING, R/C EX WIRING, F/I NEW WIRING AS NOTED.
3. R/C EX WIRING AND CONDUIT. REPAIR SIDEWALK TO MATCH EX.
4. EX CONDUIT AND IC SERVICE WIRES, R/C EX WIRING AFTER CONNECTION OF NEW SERVICE POINT TO NEW IC. CUT CONDUIT APPROX 2' FROM PULL BOX AND R/C CUT PORTION. ABANDON REMAINING CONDUIT IN PLACE.
5. SPLICE NEW WIRES TO EX SL WIRING TO MAINTAIN SL CIRCUIT.
6. SPLICE NEW WIRES TO EX SL WIRING TO ACTIVATE NEW SL CIRCUIT.
7. R/C EX PULL BOX. REPAIR SIDEWALK TO MATCH EX.
8. EXTEND 12/C INTERCONNECT TO NEW IC LOCATION. SPLICE TO EX 12/C TO MAINTAIN INTERCONNECT SYSTEM.

PHASE DIAGRAM:

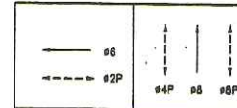

PHASES 2 & 8 PHASES 4 & 6

PHASE SEQUENCE:

G	Y	R	HARRISON ST
R	G	Y	9TH ST
WM	FRH	RH	PED XING 9TH ST SOUTH
RH	WM	FRH	PED XING 9TH HARRISON ST

BUREAU OF ENGINEERING
DEPARTMENT OF PUBLIC WORKS
CITY AND COUNTY OF SAN FRANCISCO

DESIGNED: DATE:
BC 12/14/16
DRAWN: DATE:
BC 12/16/16
CHECKED: DATE:
SWT 12/16/16

APPROVED: DATE:
SECTION MANAGER: DATE:
DIVISION MANAGER: DATE:
CITY ENGINEER: DATE:

SCALE:
1"=10'
SHEET OF SHEETS
20 OF 27

HARRISON STREET
TRAFFIC SIGNAL IMPROVEMENTS
9TH AND HARRISON
TRAFFIC SIGNAL WORK

SPECIFICATION NO.
11167N
DRAWING NO.
E-20
FILE NO.
95,447
REV. NO.
3

