


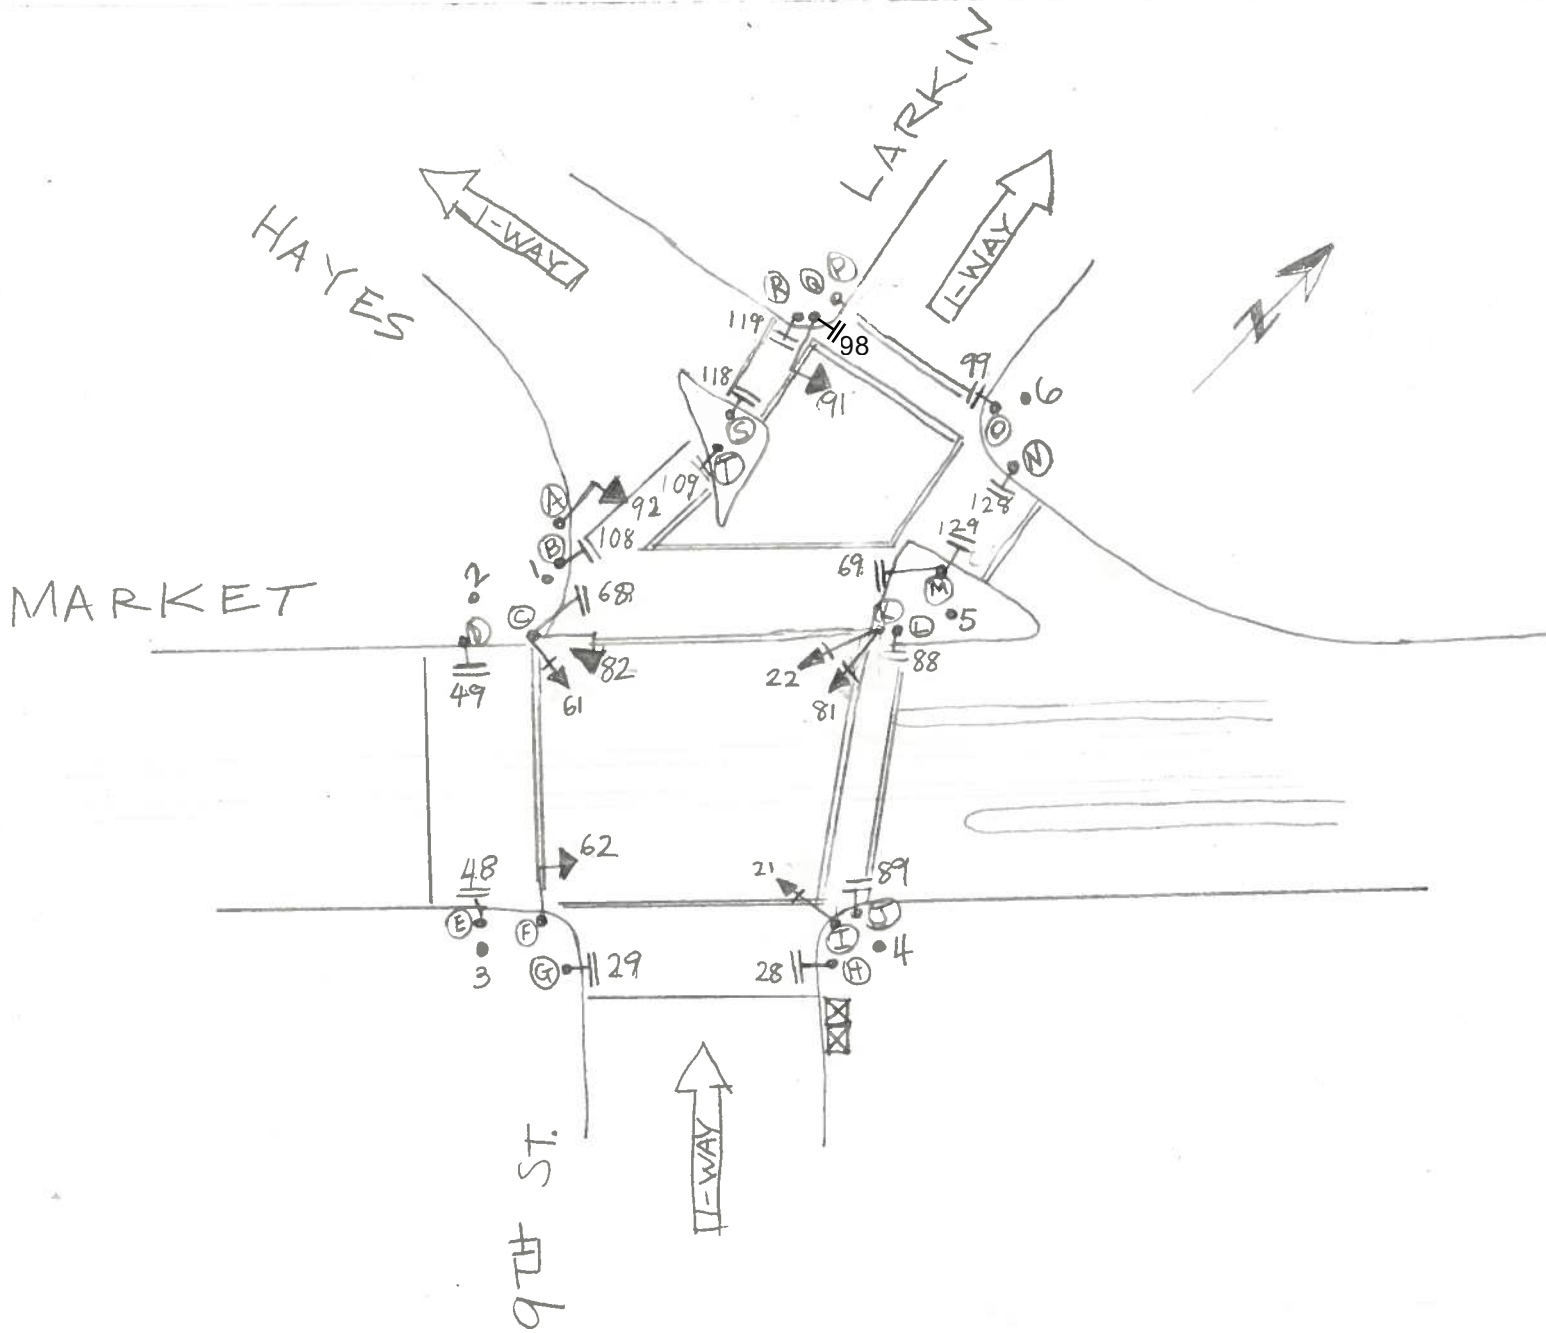

SRC 2021-293 - RELOCATE PEDESTRIAN SIGNAL 98 FROM POLE R TO POLE Q  
M. TAMIN 8/29/2022

9th ST., HAYES, LARKIN & MARKET

DATE 9-4-2018

| POLE | FUNC | MATL | SIGNAL NO. | MAKE | NO. OF SECT. | SIZE | VISOR | B.P. OR LOUVERS | MOUNT | PED SIGNAL NO. | LEGEND    | MESSAGE  |       | MAKE | MOUNT |
|------|------|------|------------|------|--------------|------|-------|-----------------|-------|----------------|-----------|----------|-------|------|-------|
|      |      |      |            |      |              |      |       |                 |       |                |           | ELEMENT  | COLOR |      |       |
| A    | S    | S    | 21         | —    | 3            | 12"  | T     | BP              | S     | 28             | COUNTDOWN | IS-COUNT | W/OR  | ICC  | T     |
| B    | S    | S    | 22         | —    | 3            | 12"  | T     | BP              | S     | 29             | COUNTDOWN | IS-COUNT | W/OR  | ICC  | S     |
| C    | S    | S    | 61         | —    | 3            | 12"  | T     | BP              | S     | 48             | COUNTDOWN | IS-COUNT | W/OR  | ICC  | T     |
| D    | S    | S    | 62         | —    | 3            | 8"   | FC8"  | BP              | *     | 49             | COUNTDOWN | IS-COUNT | W/OR  | ICC  | T     |
| E    | S    | S    | 81         | —    | 3            | 12"  | T     | BP              | S     | 68             | COUNTDOWN | IS-COUNT | W/OR  | ICC  | T     |
| F    | S    | S    | 82         | —    | 3            | 8"   | FC8"  | BP              | *     | 69             | COUNTDOWN | IS-COUNT | W/OR  | ICC  | T     |
| G    | S    | S    | 91         | —    | 3            | 8"   | FC8"  | BP              | *     | 88             | COUNTDOWN | IS-COUNT | W/OR  | ICC  | T     |
| H    | S    | S    | 92         | —    | 3            | 8"   | FC8"  | BP              | *     | 89             | COUNTDOWN | IS-COUNT | W/OR  | ICC  | T     |
| I    | S    | S    |            |      |              |      |       |                 |       | 98             | COUNTDOWN | IS-COUNT | W/OR  | ICC  | S     |
| J    | S    | S    |            |      |              |      |       |                 |       | 99             | COUNTDOWN | IS-COUNT | W/OR  | ICC  | S     |
| K    | S    | S    |            |      |              |      |       |                 |       | 108            | COUNTDOWN | IS-COUNT | W/OR  | ICC  | T     |
| L    | S    | S    |            |      |              |      |       |                 |       | 109            | COUNTDOWN | IS-COUNT | W/OR  | ICC  | T     |
| M    | S    | S    |            |      |              |      |       |                 |       | 118            | COUNTDOWN | IS-COUNT | W/OR  | ICC  | T     |
| N    | S    | S    |            |      |              |      |       |                 |       | 119            | COUNTDOWN | IS-COUNT | W/OR  | ICC  | T     |

| POLE | FUNC | MATL | SIGNAL NO. | MAKE | NO. OF SECT. | SIZE | VISOR | B.P. OR LOUVERS | MOUNT | PED SIGNAL NO. | LEGEND    | MESSAGE  |       | MAKE | MOUNT |
|------|------|------|------------|------|--------------|------|-------|-----------------|-------|----------------|-----------|----------|-------|------|-------|
|      |      |      |            |      |              |      |       |                 |       |                |           | ELEMENT  | COLOR |      |       |
| O    | S    | S    |            |      |              |      |       |                 |       | 128            | COUNTDOWN | IS-COUNT | W/OR  | ICC  | T     |
| P    | S    | S    |            |      |              |      |       |                 |       | 129            | COUNTDOWN | IS-COUNT | W/OR  | ICC  | T     |
| Q    | S    | S    |            |      |              |      |       |                 |       |                |           |          |       |      |       |
| R    | S    | S    |            |      |              |      |       |                 |       |                |           |          |       |      |       |
| S    | S    | S    |            |      |              |      |       |                 |       |                |           |          |       |      |       |
| T    | S    | S    |            |      |              |      |       |                 |       |                |           |          |       |      |       |
|      |      |      |            |      |              |      |       |                 |       |                |           |          |       |      |       |
| 1    | M    | S    |            |      |              |      |       |                 |       |                |           |          |       |      |       |
| 2    | L    | O    |            |      |              |      |       |                 |       |                |           |          |       |      |       |
| 3    | L    | O    |            |      |              |      |       |                 |       |                |           |          |       |      |       |
| 4    | L    | O    |            |      |              |      |       |                 |       |                |           |          |       |      |       |
| 5    | L    | O    |            |      |              |      |       |                 |       |                |           |          |       |      |       |
| 6    | M    | S    |            |      |              |      |       |                 |       |                |           |          |       |      |       |

CONTROLLER CABINET SIZE : ORDINARY BASE CABINET : 1 - YES 1 - NO

COMMENTS : \* MARKET STREET MASTARM SIGNALS

SRC 2018-342: Added backplate to Signal 81 on Pole (R) D. Yeung