


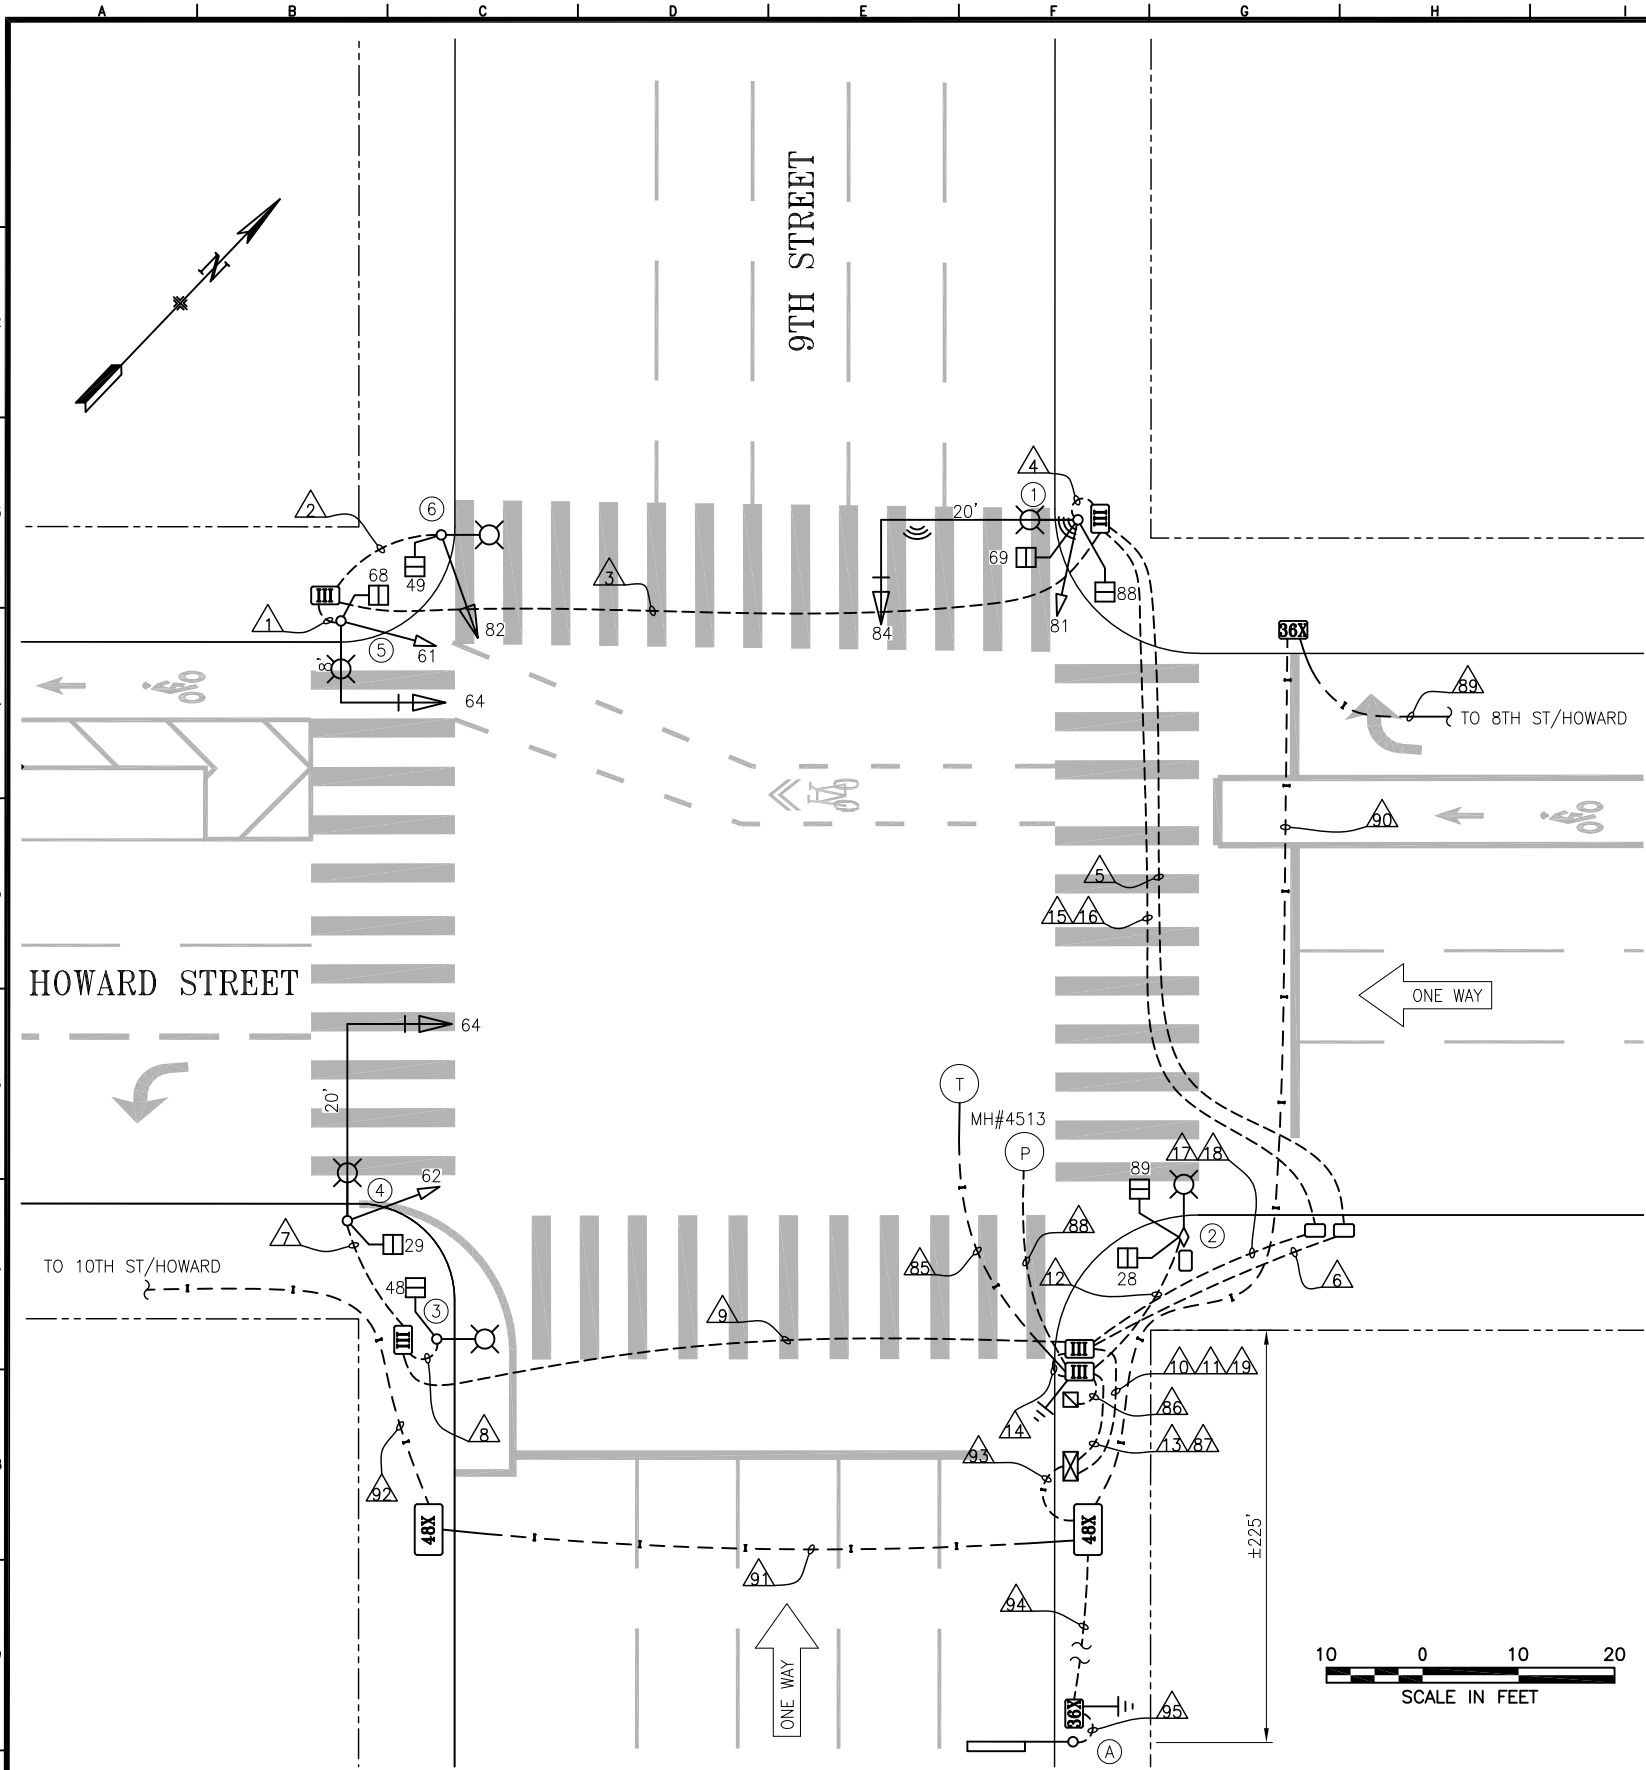

POLE AND EQUIPMENT SCHEDULE											
POLE No.	TYPE OF POLE	LUMINAIRE TYPE	VEHICLE SIGNAL					PEDESTRIAN SIGNAL			REMARKS
			No.	TYPE	MOUNTING	VISORS	LOUVERS/BP	No.	TYPE	MOUNTING	
①	17B-1-70 W/ 20' MA AND 6' LA		81 84	3S8" 3S12"	SV-1-T MAS	T T	BP	69 88	1S-COUNT 1S-COUNT	SP-1-SF(12") SP-1(22")	TSP EQUIPMENT
②	MUNI POLE							28 89	1S-COUNT 1S-COUNT	SP-2-T-SF 	EXTERNAL CONDUIT
③	CITY STANDARD STREET LIGHT							48	1S-COUNT	SP-1	
④	17B-1-70 W/ 20' MA AND 6' LA		62 67	3S8" 3S12"	SV-1-T MAS	T T	BP	29	1S-COUNT	SP-1	
⑤	17B-1-70 W/ 8' MA AND 6' LA		61 64	3S8" 3S12"	SV-1-T MAS	T T	BP	68	1S-COUNT	SP-1	
⑥	CITY STANDARD STREET LIGHT		82	3S12"	SV-1-T	T		49	1S-COUNT	SP-1	
Ⓐ	CANTILEVER VMS POLE										VARIABLE MESSAGE SIGN

Δ	03/25/20	UPDATED TO REMOVE RLC PER CONTRACT 2855J AS-BUILTS	J. HORNOSTEL	G. DELEON	
Δ	03/2010	CONVERTED FROM 1430N, 0435J, AND 0780J, 1994 RLC PROJECT, AND 2010 RLC PROJECT AS-BUILTS	J. HORNOSTEL	G. DELEON	
NO.	DATE	DESCRIPTION	BY	APPROVED	
TABLE OF REVISIONS					
CHECKOUT DRAWING THROUGH THE SID CUSTODIAN FOR THE LATEST REVISION					



SFMTA

DRAWN BY: J. HORNOSTEL	DATE: 3/17/2022
CHECKED BY: G. DeLEON	DATE: 3/17/2022

SCALE AS SHOWN
SHEET OF SHEETS 01 OF 02

TRAFFIC SIGNAL INVENTORY DIAGRAM
9TH STREET AND HOWARD STREET

CNN NO: 24305000
REV NO: 1

