


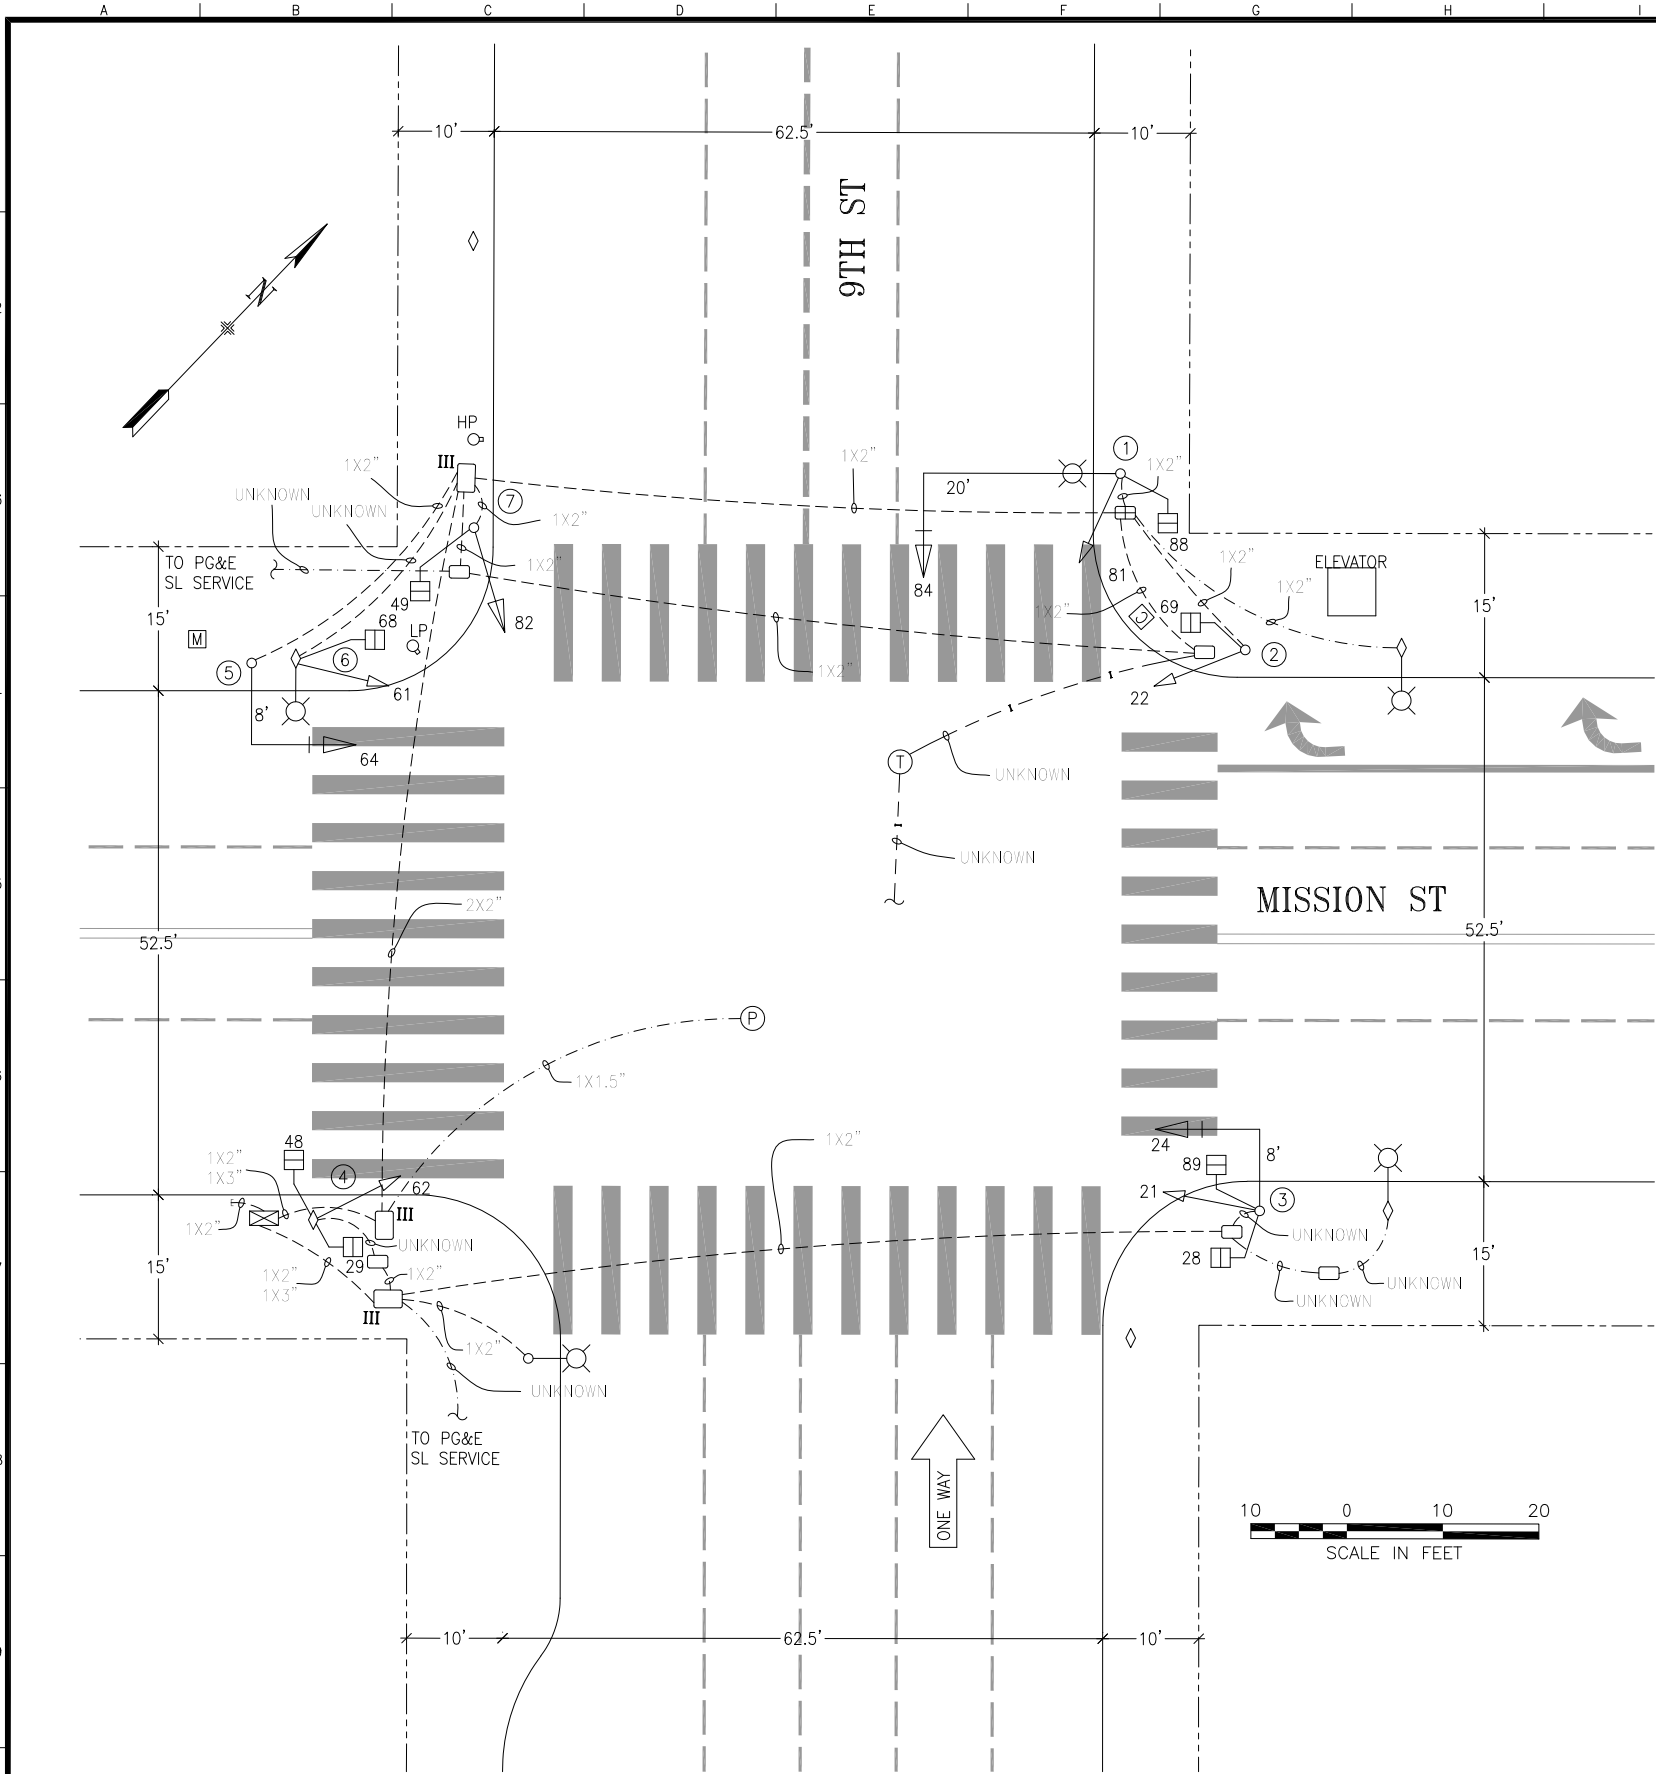

POLE AND EQUIPMENT SCHEDULE											
POLE No.	TYPE OF POLE	LUMINAIRE VOLTAGE/ WATTAGE	VEHICLE SIGNAL					PEDESTRIAN SIGNAL			REMARKS
			No.	TYPE	MOUNTING	VISORS	LOUVERS	No.	TYPE	MOUNTING	
①	17-1-70 WITH 20' MAST ARM AND 6' LUMINAIRE ARM	120/250	84 81	3S12" 3S12"	MAS SV-1-T	T T		88	1S-COUNT	SP-1	BACKPLATE BASEMENT
②	1-A (10')		22	3S8"	TV-1	T		69	1S-COUNT	SP-1	
③	16-1-70 WITH 8' MAST ARM		24 21	3S12" 3S8"	MAC-SF SV-1-T	T T		89 28	1S-COUNT 1S-COUNT	SP-1-SF (12") SP-1 (22")	BACKPLATE
④	MUNI		62	3S8"	SV-1-T	T		29 48	1S-COUNT 1S-COUNT	SP-1 SP-1	TSP
⑤	16-1-70 WITH 8' MAST ARM		64	3S12"	MAC-SF	T					BACKPLATE BASEMENT
⑥	MUNI		61	3S8"	SV-1-T	T		68	1S-COUNT	SP-1	
⑦	1-A (10')		82	3S12"	TV-1-T	T		48	1S-COUNT	SP-1	

TABLE OF REVISIONS				
NO.	DATE	DESCRIPTION	BY	APP.
1	11/16/20	SRC 2020-255: UPDATED MOUNTING FOR SIGNALS 24664; UPDATED SMC PER FIELD	HYu	MVelasco
0	2/13/03	SIGNAL UPGRADE ACTIVATED THRU 1663NR; CONVERTED FROM CONTRACT PLANS	SVohra	MVelasco
CHECK WITH TRACING TO SEE IF YOU HAVE LATEST REVISION				

REFERENCE INFORMATION & FILE NO. OF SURVEYS



SAN FRANCISCO MUNICIPAL TRANSPORTATION AGENCY

CITY AND COUNTY OF SAN FRANCISCO

DRAWN:	DATE:
SVohra	07/2015
CHECKED:	DATE:
MVelasco	07/2015

SCALE:
AS SHOWN
SHEET OF SHEETS
1 OF 1

TRAFFIC SIGNAL INVENTORY DIAGRAM
9TH STREET AND MISSION STREET

CNN NO.
24313000
REV NO.
1