



LAYOUT 12/3/03

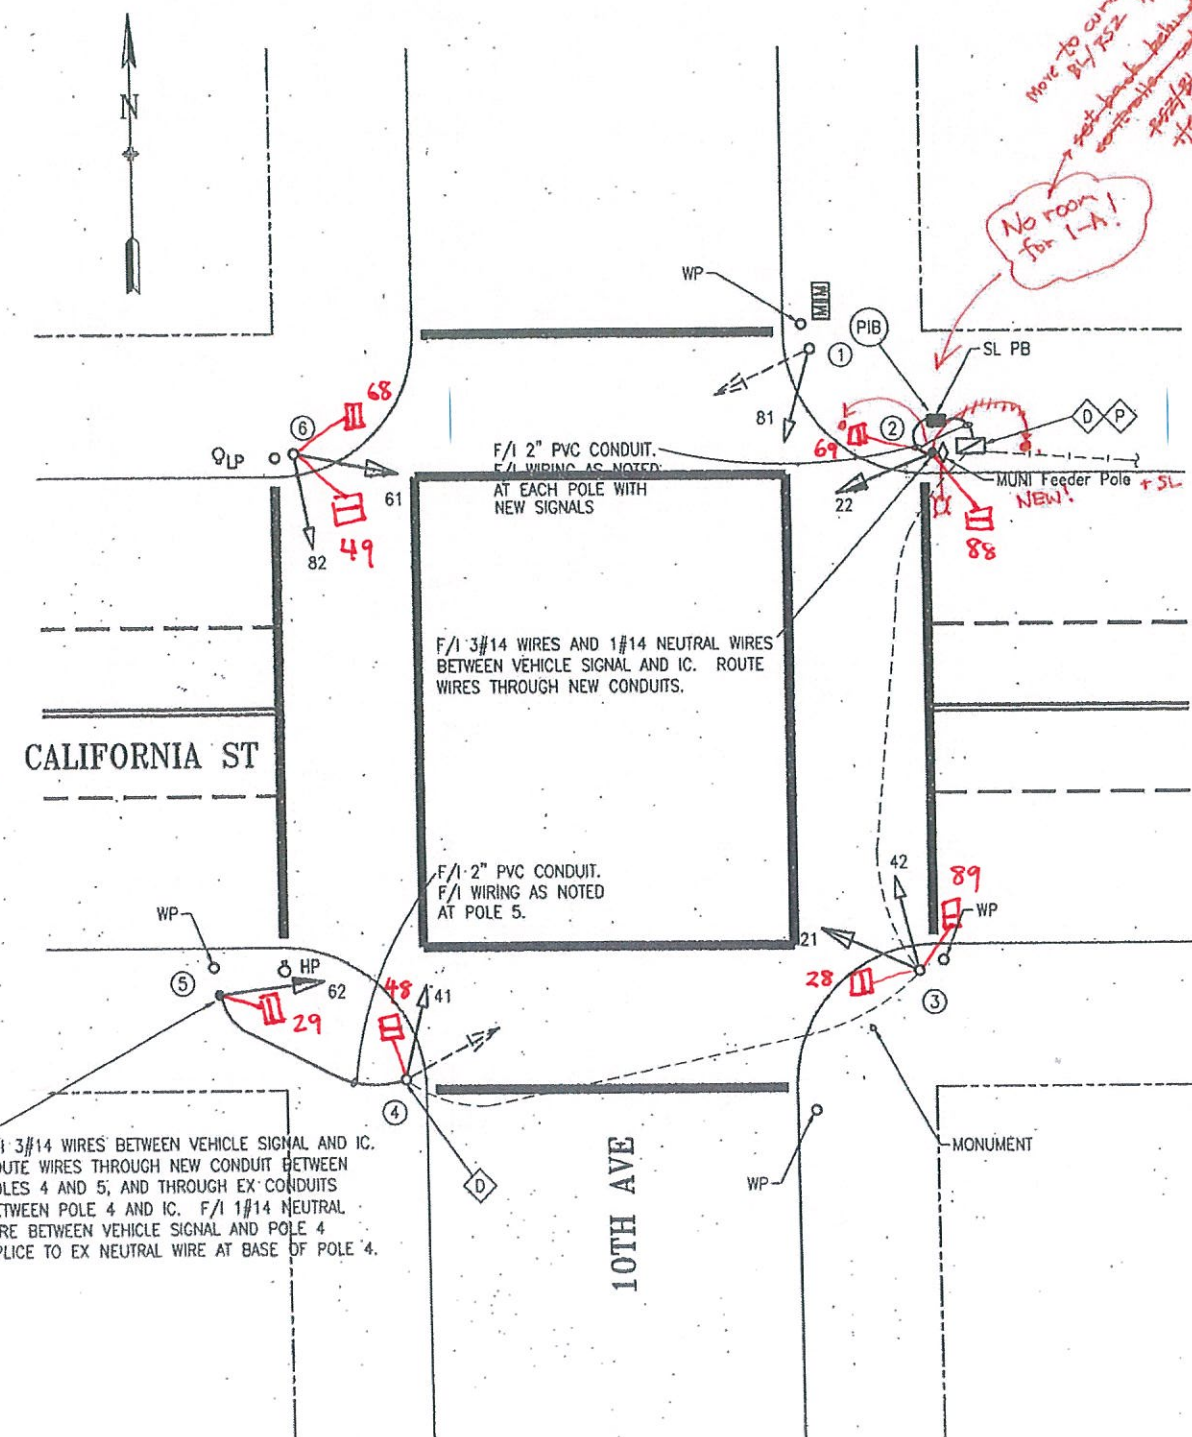


POLE AND EQUIPMENT SCHEDULE										CONTRACT WORK IN BOLD	
POLE No.	TYPE OF POLE	VEHICLE SIGNAL					PEDESTRIAN SIGNAL			REMARKS	
		No.	TYPE	MOUNTING	VISORS	LOUVERS	No.	TYPE	MOUNTING		
①	EX MARBLELITE	EX 81	EX 3S8"	TV-1	EX T						
②	1-A (10')	22	3S12"	TV-1-T	T		69	IS-COUNT	SP-2-T		
							88	IS-COUNT			
③	EX MARBLELITE	EX 21 EX 42	EX 3S12" EX 3S8"	EX TV-2-T	EX T EX T		29	IS-COUNT	SP-2-T		
							89	IS-COUNT			
④	EX MARBLELITE	EX 41	EX 3S8"	TV-1	EX T		48	IS-COUNT	SP-1-T		
⑤	1-A (10')	62	3S12"	TV-1-T	T		29	IS-COUNT	SP-1-T		
⑥	EX MARBLELITE	EX 61 EX 82	EX 3S12" EX 3S8"	EX TV-2-T	EX T EX T		49	IS-COUNT	SP-2-T		
							68	IS-COUNT			

PHASE DIAGRAM:

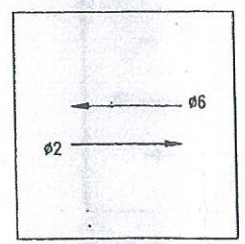

PHASES 2 & 6

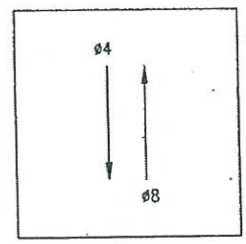

PHASES 4 & 8

PHASE SEQUENCE:

G	Y	R	CALIFORNIA ST
R	G	Y R	10TH AVE

DETAIL NOTES:

- ◇ CHIP EX FOUNDATION CAREFULLY TO BRING CONDUIT INTO BASE OF STANDARD OR CONTROLLER CABINET AND REPAIR AFTER INSTALLATION.
- ◇ PROVIDE COPPER GROUND BUS BAR WITH 16 TERMINATION POINTS SUITABLE FOR #6 THRU #10 AWG.

SIGNALS ACTIVATED ON
THURS 9-23-04 1610
PCS activated 4/30/15 1200



1 2/20/19 ADD PCS PER SEC 2018-105 AL		REFERENCE INFORMATION & FILE NO. OF SURVEYS			BUREAU OF ENGINEERING DEPARTMENT OF PUBLIC WORKS CITY AND COUNTY OF SAN FRANCISCO		DESIGNED: DATE: 4/1/03	APPROVED: DATE: 4/1/03	SCALE: 1"=10'-0"	CONTRACT 28-29 TRAFFIC SIGNAL MODIFICATION	SPECIFICATION NO. 0435J
NO.	DATE:	DESCRIPTION	BY				APP.	DSB/TP 3/03	SECTION MANAGER		DATE: 4/1/03
							CHECKED: DATE: 3/03	DEPUTY MANAGER	DATE: 4/1/03	10TH AVE AND CALIFORNIA ST	FILE NO. 83,104
							BC 3/03	CITY ENGINEER	DATE: 4/1/03		REV. NO. 0

TABLE OF REVISIONS
CHECK WITH TRACING TO SEE IF YOU HAVE LATEST REVISION

Drawing Path: V:\0435J Traffic Signal_C428 & #29 Construction Change Orders\Drawings\0435J_E1707-PC08\Drawings\0435J_E1707-PC08.dwg
Plot Time: Wed, 02 Apr 2003 10:11am