




|                                                       |         |                                                                                   |        |      |  |
|-------------------------------------------------------|---------|-----------------------------------------------------------------------------------|--------|------|--|
|                                                       |         |                                                                                   |        |      |  |
| 0                                                     | 12/3/14 | PER FIELD CHECK: SIGNAL UPGRADE ACTIVATED THRU 1989N AND CONVERTED FROM AS-BUILTS | DYeung | BWoo |  |
| NO.                                                   | DATE    | DESCRIPTION                                                                       | BY     | APP. |  |
| TABLE OF REVISIONS                                    |         |                                                                                   |        |      |  |
| CHECK WITH TRACING TO SEE IF YOU HAVE LATEST REVISION |         |                                                                                   |        |      |  |

COMPLETION DATE /  
ELECTRICIAN INITIAL

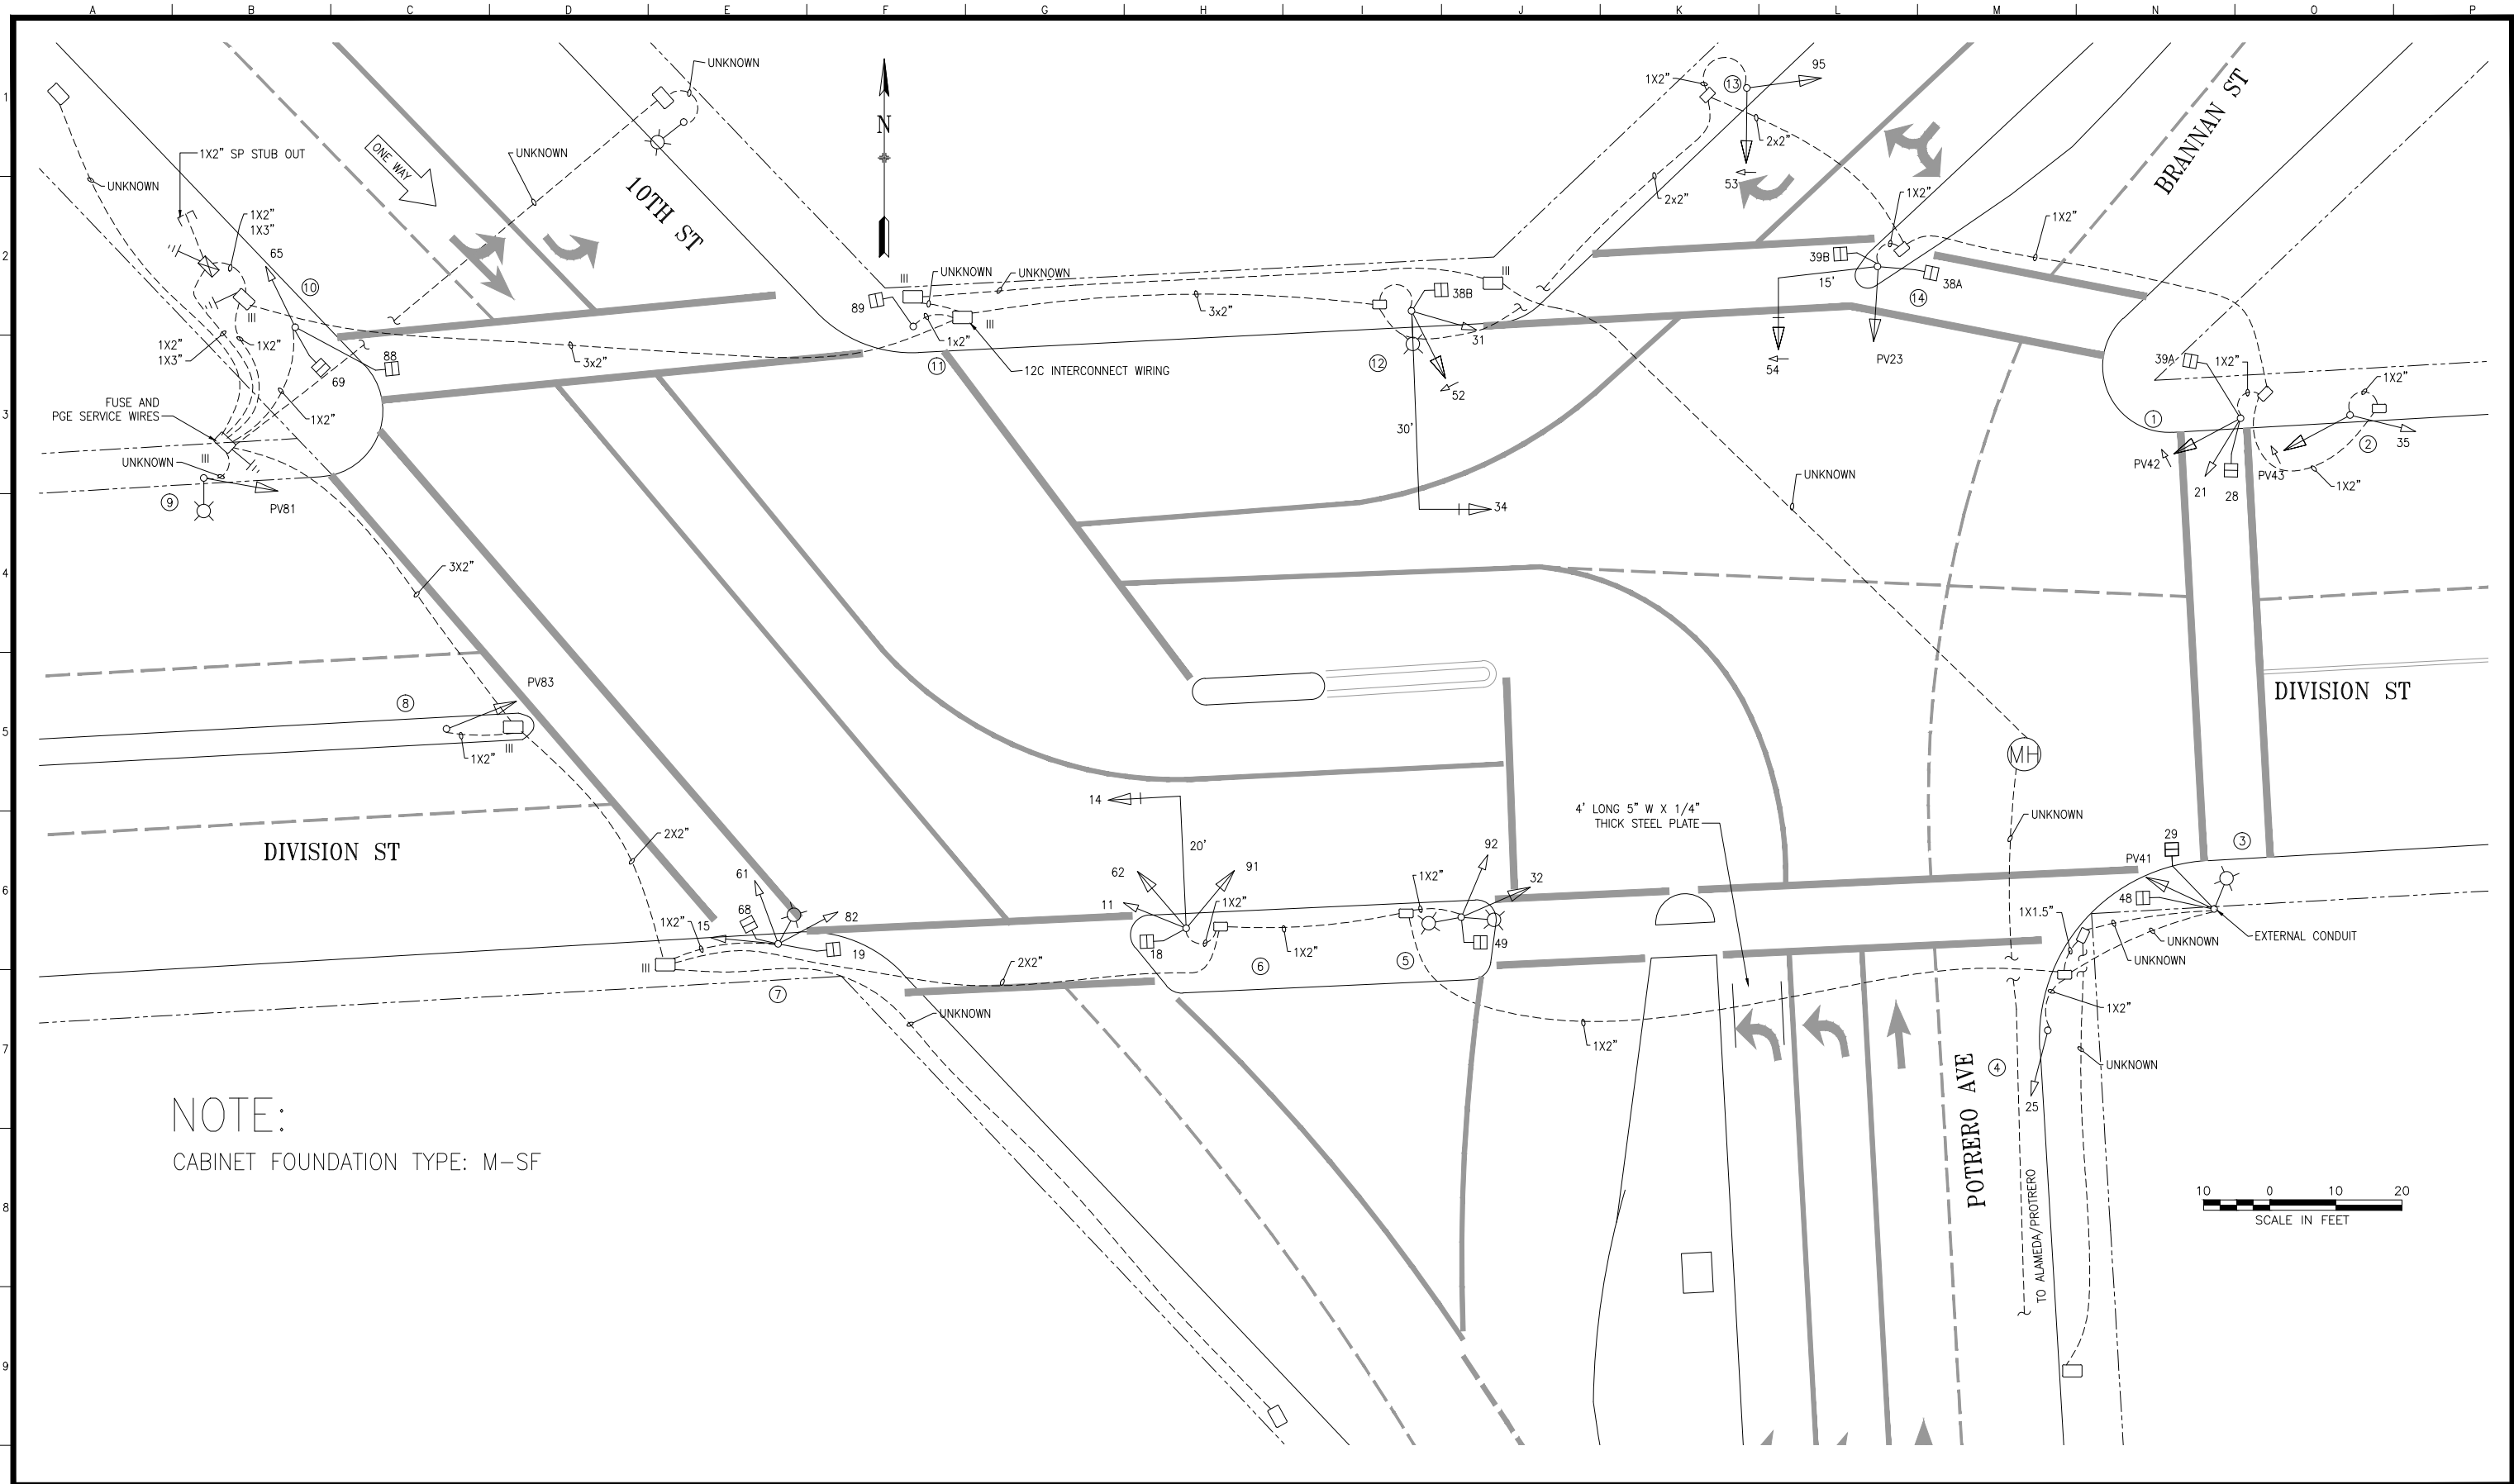

SAN FRANCISCO MUNICIPAL TRANSPORTATION AGENCY  
TRANSPORTATION ENGINEERING  
CITY AND COUNTY OF SAN FRANCISCO

|          |         |                 |
|----------|---------|-----------------|
| DRAWN:   | DATE:   | SCALE:          |
| DYeung   | 12/2014 | AS SHOWN        |
| CHECKED: | DATE:   | SHEET OF SHEETS |
| BWoo     | 12/2014 | 1 OF 2          |

|                                               |
|-----------------------------------------------|
| TRAFFIC SIGNAL INVENTORY DIAGRAM              |
| 10TH ST, BRANNAN ST, DIVISION ST, POTRERO AVE |

|          |
|----------|
| CNN NO.  |
| 24190000 |
| REV. NO. |
| 0        |

| POLE AND EQUIPMENT SCHEDULE |                                    |                 |                |                        |                |         |                           |                   |           |                |                  |
|-----------------------------|------------------------------------|-----------------|----------------|------------------------|----------------|---------|---------------------------|-------------------|-----------|----------------|------------------|
| POLE No.                    | TYPE OF POLE                       | LUMINAIRE (HPS) | VEHICLE SIGNAL |                        |                |         |                           | PEDESTRIAN SIGNAL |           |                | REMARKS          |
|                             |                                    | VOTAGE/ WATTS   | No.            | TYPE                   | MOUNTING (F/I) | VISORS  | LOUVERS                   | No.               | TYPE      | MOUNTING (F/I) |                  |
| ①                           | 1-A(10')                           |                 | 21 42          | 3S8" PV4S12"GLA        | TV-2-T         | T T     |                           | 39A 28            | 1S-C 1S-C | SP-1 SP-1      |                  |
| ②                           | 1-A(10')                           |                 | 43 35          | PV4S12"GLA 3S8"        | TV-2-T         | T       |                           |                   |           |                |                  |
| ③                           | MARBELITE SL                       |                 | 41             | PV3S12"                | SV-1-T         | T       |                           | 29 48             | 1S-C 1S-C | SP-2-T         | EXTERNAL CONDUIT |
| ④                           | 1-A(10')                           |                 | 25             | 3S8"                   | TV-1           | T       |                           |                   |           |                |                  |
| ⑤                           | SL W/TWO LUMINAIRES                | 120/200         | 32 92          | 3S12" 3S8"             | SV-2-TA        | T T     |                           | 49                | 1S-C      | SP-1           |                  |
| ⑥                           | 16-1-70 W/ 20' MAST ARM            |                 | 14 11 62 91    | 3S12" 3S8" 3S12" 3S12" | MAS SV-3-TA    | T T T T |                           | 18                | 1S-C      | SP-1           | BACKPLATE        |
| ⑦                           | SL                                 | 120/200         | 61 82 15       | 3S8" 3S8" 3S8"         | SV-3-TA        | T T T   | HORIZONTAL LOUVERS FOR 82 | 19 68             | 1S-C 1S-C | SP-1 SP-1      |                  |
| ⑧                           | 1-A(10')                           |                 | 83             | PV3S12"                | TV-1-T         | T       |                           |                   |           |                |                  |
| ⑨                           | SL                                 |                 | 81             | PV3S12"                | SV-1-T         | T       |                           |                   |           |                |                  |
| ⑩                           | 1-A(10')                           |                 | 65             | 3S8"                   | TV-1           | T       |                           | 88 69             | 1S-C 1S-C | SP-2-T-SF      |                  |
| ⑪                           | 1-A(7')                            |                 |                |                        |                |         |                           | 89                | 1S-C      | TP-1           |                  |
| ⑫                           | 19-2-70 W/30' MAST AND 6' LUM ARMS | 120/200         | 34 52 31       | 3S12" 3S12"LA 3S8"     | MAS SV-2-TA    | T T T   |                           | 38B               | 1S-C      | SP-1           | BACKPLATE        |
| ⑬                           | 1-A(10')                           |                 | 53 95          | 3S12"LA 3S12"          | TV-2-T-SFA     | T T     |                           |                   |           |                |                  |
| ⑭                           | 16-1-70 W/ 15' MAST ARM            |                 | 23 54          | PV3S12" 3S12"LA        | SV-1-T MAS     | T T     |                           | 38A 39B           | 1S-C 1S-C | SP-2-T-SF      | BACKPLATE        |

|  |  |  |  |                                                                                       |                                                                                                                 |                             |                        |                                  |                                               |            |
|--|--|--|--|---------------------------------------------------------------------------------------|-----------------------------------------------------------------------------------------------------------------|-----------------------------|------------------------|----------------------------------|-----------------------------------------------|------------|
|  |  |  |  |  | SAN FRANCISCO MUNICIPAL TRANSPORTATION AGENCY<br>TRANSPORTATION ENGINEERING<br>CITY AND COUNTY OF SAN FRANCISCO | DRAWN: DATE: DYeung 12/2014 | SCALE: NONE            | TRAFFIC SIGNAL INVENTORY DIAGRAM | CNN NO. 24190000                              |            |
|  |  |  |  |                                                                                       |                                                                                                                 | CHECKED: DATE: BWoo 12/2014 | SHEET OF SHEETS 2 OF 2 |                                  | 10TH ST, BRANNAN ST, DIVISION ST, POTRERO AVE | REV. NO. 0 |
|  |  |  |  |                                                                                       |                                                                                                                 |                             |                        |                                  |                                               |            |
|  |  |  |  |                                                                                       |                                                                                                                 |                             |                        |                                  |                                               |            |

|                                                       |         |                                                                                   |        |      |
|-------------------------------------------------------|---------|-----------------------------------------------------------------------------------|--------|------|
| 0                                                     | 12/3/14 | PER FIELD CHECK: SIGNAL UPGRADE ACTIVATED THRU 1989N AND CONVERTED FROM AS-BUILTS | DYeung | BWoo |
| NO.                                                   | DATE    | DESCRIPTION                                                                       | BY     | APP. |
| TABLE OF REVISIONS                                    |         |                                                                                   |        |      |
| CHECK WITH TRACING TO SEE IF YOU HAVE LATEST REVISION |         |                                                                                   |        |      |

|  |                                       |
|--|---------------------------------------|
|  | COMPLETION DATE / ELECTRICIAN INITIAL |
|--|---------------------------------------|