




POLE AND EQUIPMENT SCHEDULE										
POLE No.	TYPE OF POLE	VEHICLE SIGNAL					PEDESTRIAN SIGNAL			REMARKS
		No.	TYPE	MOUNTING	VISORS	LOUVERS/BP	No.	TYPE	MOUNTING	
①	SL	22 81	3S12" 3S12"	SV-2-TA		BP BP	69 88	1S-COUNT 1S-COUNT	SP-1 SP-1	
②	17B-1-70 WITH 20' SIGNAL MAST ARM	24 21 42	3S12" 3S12" 3S12"	MAS SV-2-TA		BP BP BP	89	1S-COUNT	SP-1	CCTV CAMERA
③	SL	43 23	3S12" 3S12"	SV-2-TA		BP BP	28	1S-COUNT	SP-1	NETWORK RADIO
④	16-1-70 WITH 20' SIGNAL MAST ARM	44 41	3S12" 3S12"	MAS SV-2-TA		BP BP	29 48	1S-COUNT 1S-COUNT	SP-1-2T	PREEMPT RADIO, NETWORK RADIO
⑤	SL					BP BP	49 68	1S-COUNT 1S-COUNT	SP-1 SP-1	
Ⓐ	SL									
Ⓑ	SL									

CONTROLLER FOUNDATION TYPE: STANDARD

5	09/03/22	ADDED CCTV CAMERA (SRC 2022-154); PER FIELD: ADDED PREEMPT RADIO AND NETWORK RADIOS	S. ALEXANDER	M. VELASCO
4	07/26/19	SRC 2018-391: REMOVE SIGNAL HEADS #61,#81,> UPGRADE ALL SIGNAL HEADS TO 3S12"	C. SKERRIT	B. WOO
3	04/21/11	INSTALLED PED SIGNALS	E. TSUI	H. QUAN
2	8/XX/01	CAD DRAWING UPDATED	T. LENG	R. OLEA
NO.	DATE	DESCRIPTION	BY	APPROVED
TABLE OF REVISIONS CHECKOUT DRAWING THROUGH THE SID CUSTODIAN FOR THE LATEST REVISION				

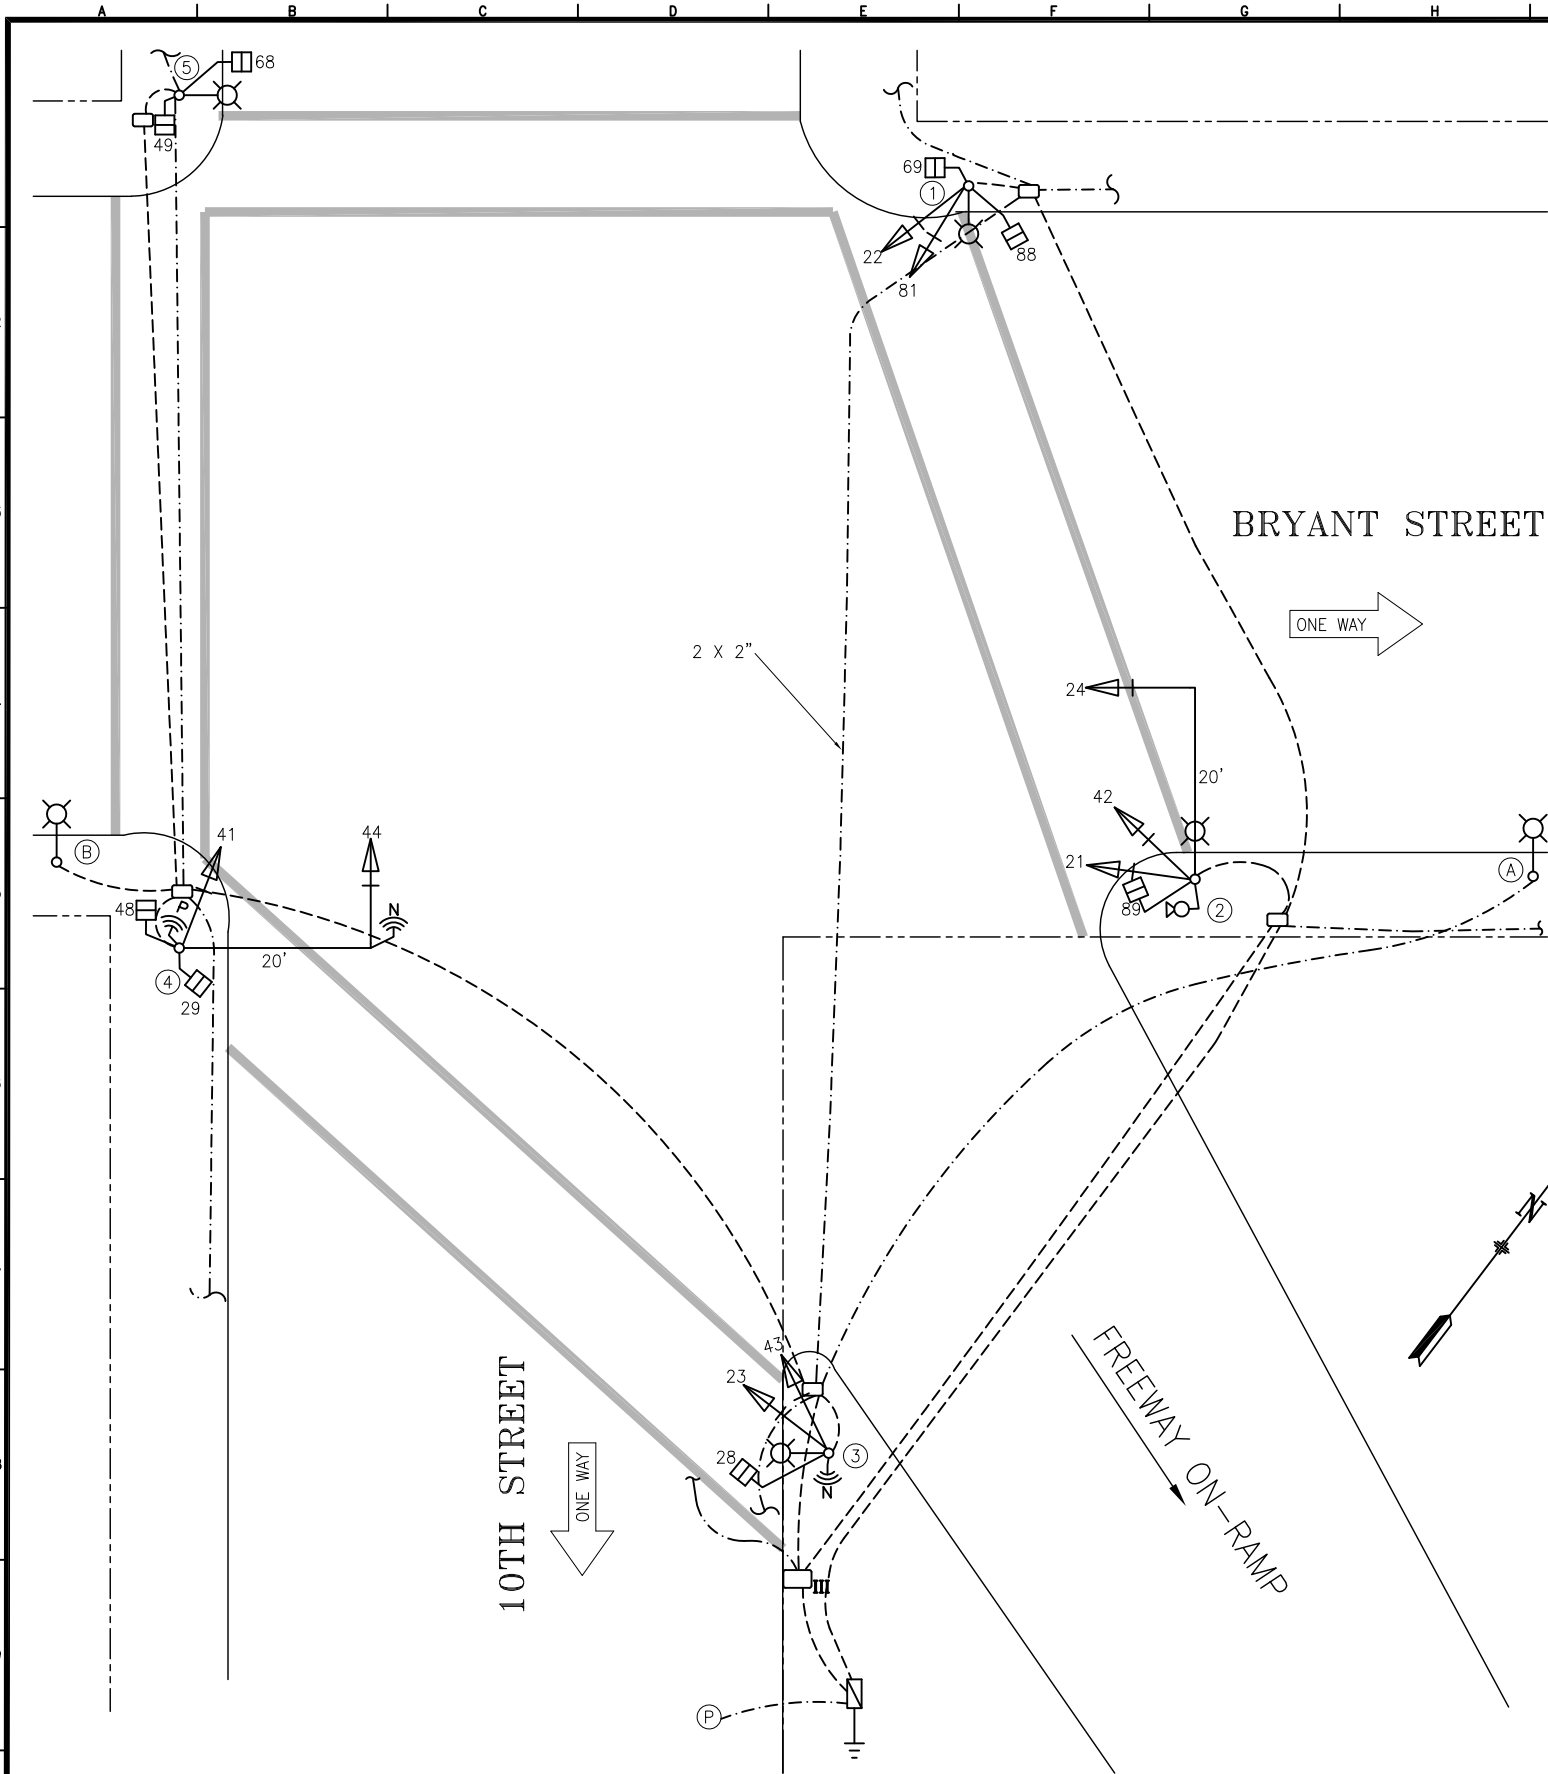

SFMTA

DRAWN BY: T. LENG	DATE: 08/15/01
CHECKED BY:	DATE:

SCALE AS SHOWN
SHEET OF SHEETS 1 OF 1

TRAFFIC SIGNAL INVENTORY DIAGRAM
10TH ST & BRYANT ST

CNN NO: 24192000
REV NO: 5