


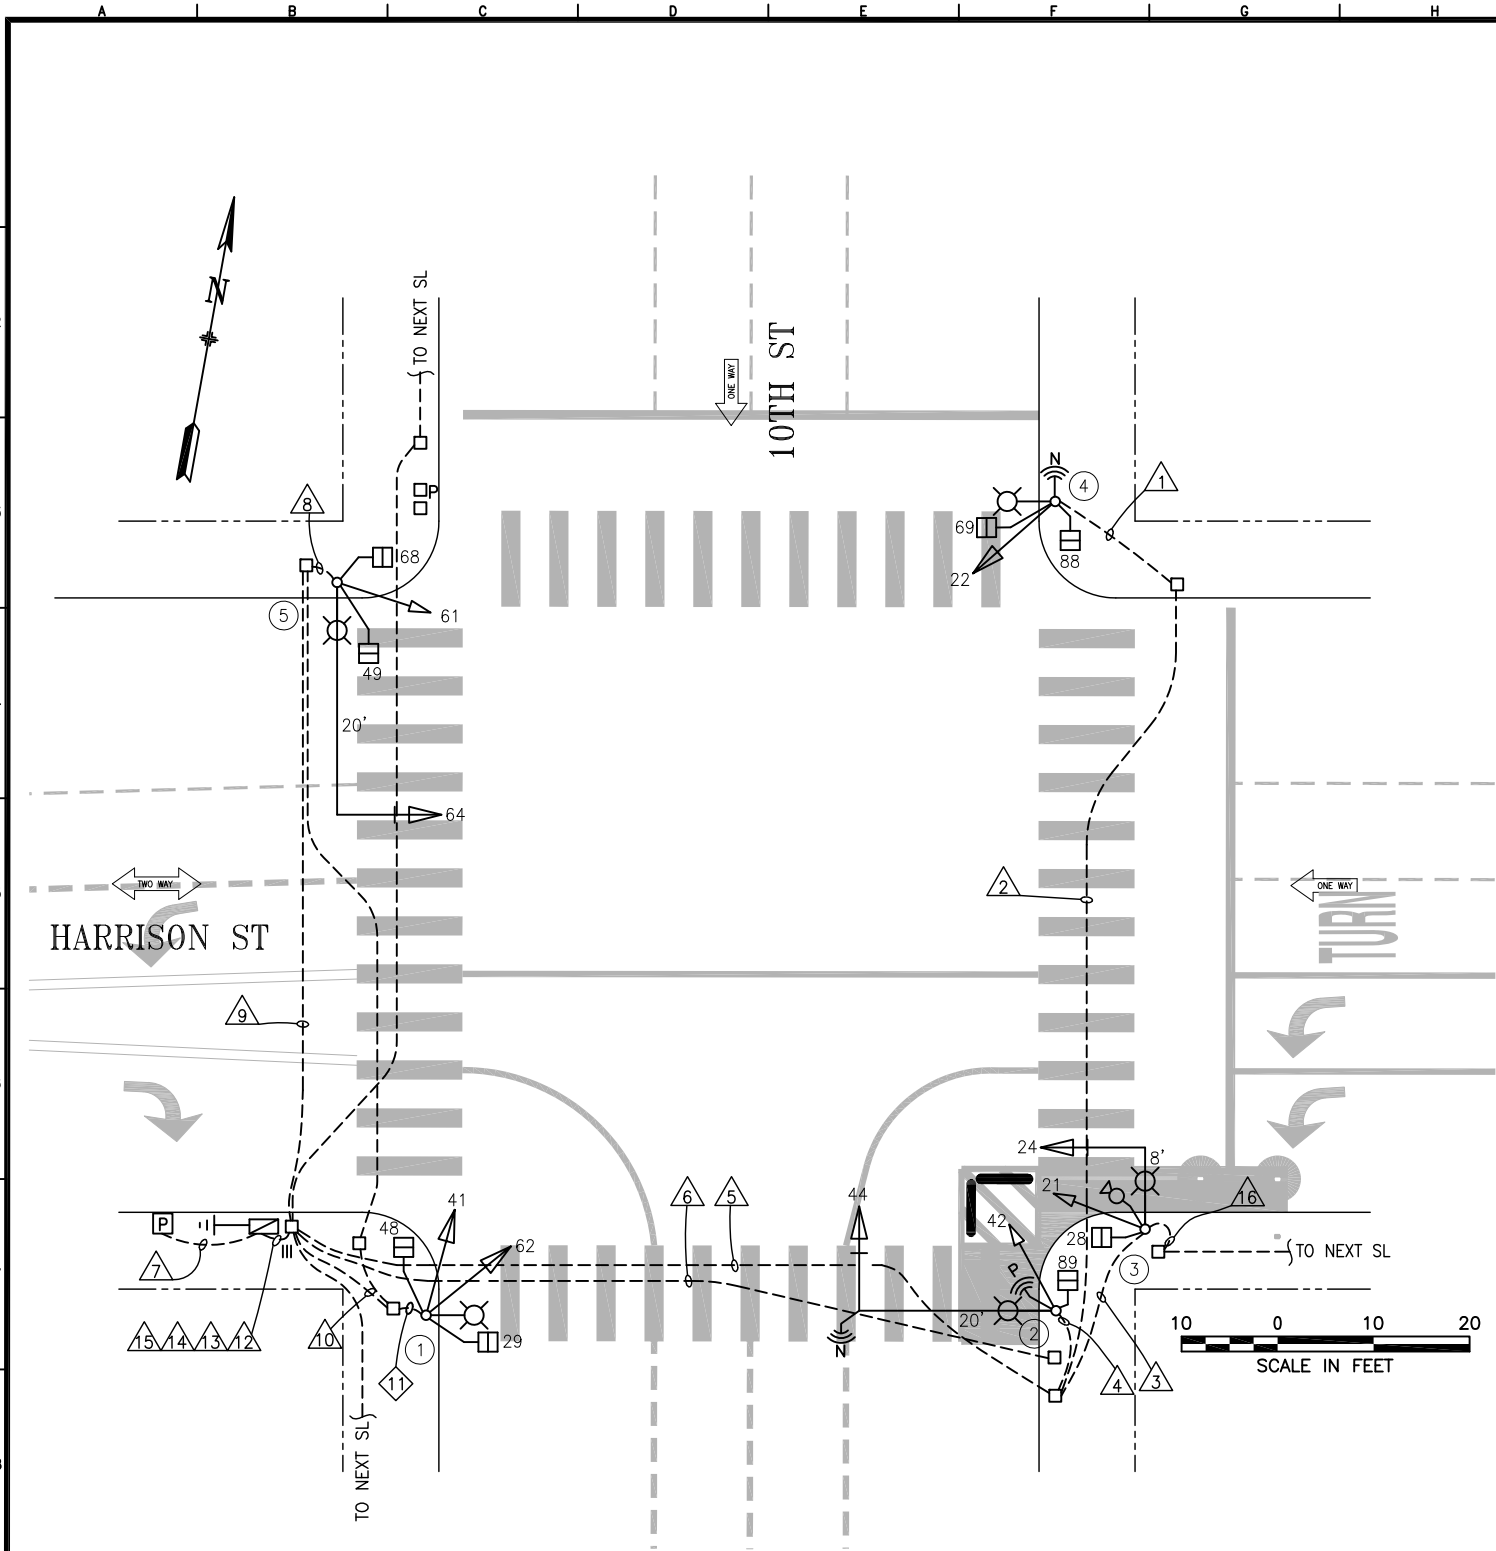

POLE AND EQUIPMENT SCHEDULE										
POLE No.	TYPE OF POLE	VEHICLE SIGNAL					PEDESTRIAN SIGNAL			REMARKS
		No.	TYPE	MOUNTING	VISORS	LOUVERS/BP	No.	TYPE	MOUNTING	
①	SL	62 41	3S12" 3S12"	SV-1 SV-1	T T		29 48	1S-IN 1S-IN	SP-2-T-SF	
②	17B-1-70 W/ 20' MAST ARM AND 6' LUMINAIRE ARM	42 44	3S8" 3S12"	SV-1-T MAS	T T	BP	89	1S-IN	SP-1	120V/200W LUMINAIRE, PREEMPT RADIO, NETWORK RADIO
③	17B-1-70 W/ 8' MAST ARM AND 6' LUMINAIRE ARM	21 24	3S8"FY 3S12"FY	SV-1-T MAS	T T	BP	28	1S-IN	SP-1	240V/250W LUMINAIRE, CCTV CAMERA
④	CITY STANDARD SL W/ 6' LUMINAIRE ARM	22	3S12"FY	SV-1-T	T		88 69	1S-IN 1S-IN	SP-1 SP-1	240V/200W LUMINAIRE, NETWORK RADIO
⑤	17B-1-70 W/ 20' MAST ARM AND 6' LUMINAIRE ARM	61 64	3S8" 3S12"	SV-1-T MAS	T T	BP	49 68	1S-IN 1S-IN	SP-1 SP-1	120V/250W LUMINAIRE

1	09/03/22	ADDED CCTV CAMERA (SRC 2022-154); PER FIELD: ADDED PREEMPT RADIO AND NETWORK RADIOS		S. ALEXANDER	M. VELASCO
0	09/27/97	CONVERTED FROM AS-BUILT FILE #62,449 (E-22) OF CONTRACT 1167N		S. ALEXANDER	M. VELASCO
NO.	DATE	DESCRIPTION		BY	APPROVED
TABLE OF REVISIONS CHECKOUT DRAWING THROUGH THE SID CUSTODIAN FOR THE LATEST REVISION					



SFMTA

DRAWN BY: S. ALEXANDER	DATE: 01/23/2023
CHECKED BY: M. VELASCO	DATE: X/X/XXXX

SCALE AS SHOWN
SHEET OF SHEETS 1 OF 2

TRAFFIC SIGNAL INVENTORY DIAGRAM
10TH STREET & HARRISON STREET

CNN NO: 24206000
REV NO: 1