


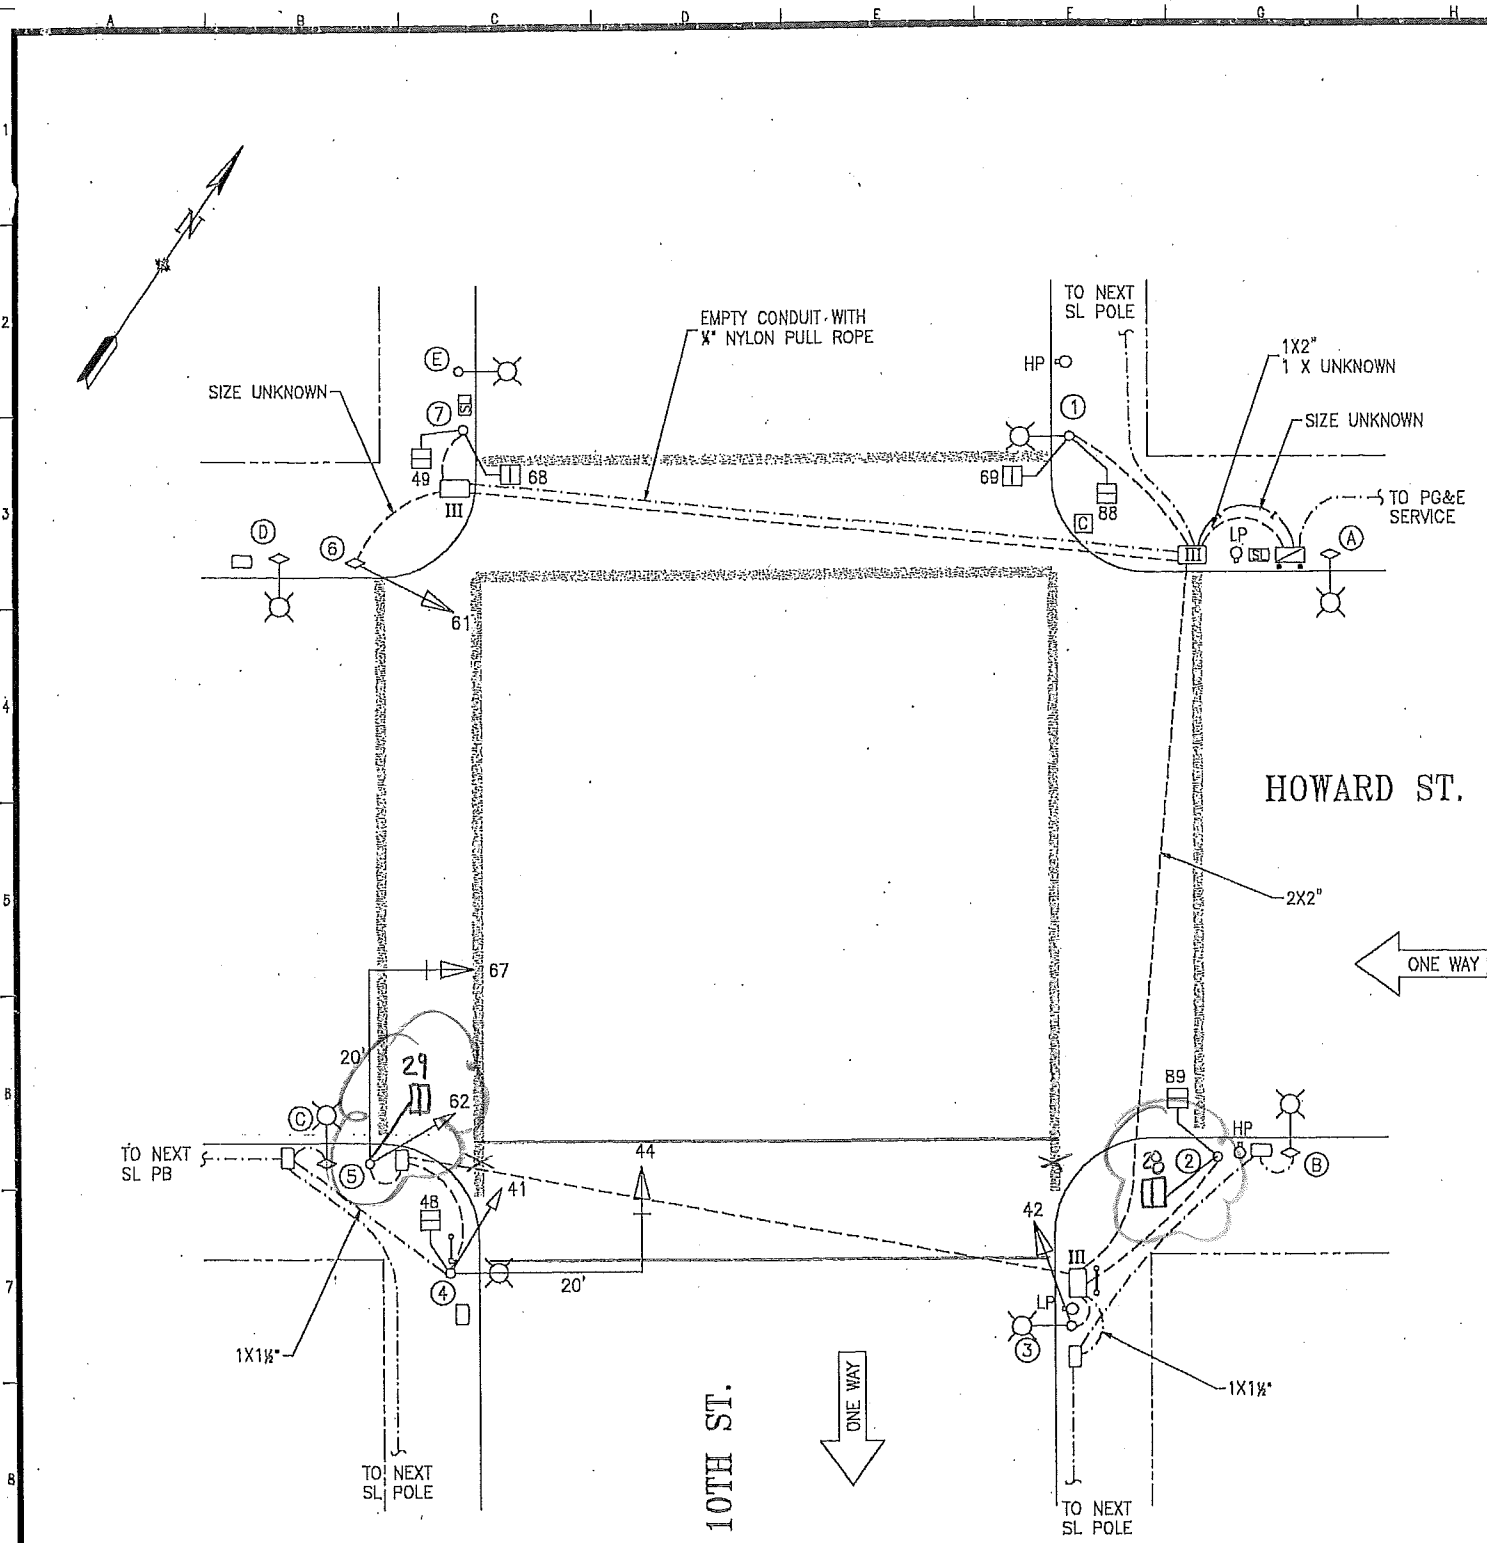

POLE AND EQUIPMENT SCHEDULE										
POLE No.	TYPE OF POLE	VEHICLE SIGNAL					PEDESTRIAN SIGNAL			REMARKS
		No.	TYPE	MOUNTING	VISORS	LOUVERS	No.	TYPE	MOUNTING	
①	SL						69 88	1S-W LED 1S-W LED	SP-1 SP-1	
②	1-A (7')						89 28	1S-W LED 1S-LED	TP-2-T TP-2-T	
③	SL	42	3S12"	SV-1-T	T					
④	17B-1-70 W/ 20' MAST ARM AND 6' LUMINAIRE	44 41	3S12" 3S8"	MAS SV-1-T	T T		48	1S-W LED	SP-1	BP
⑤	16-1-70 W/ 20' MAST ARM	67 62	3S12" 3S8"	MAS SV-1-T	T T		29	1S-LED	SP-1	BP
⑥	MUNI	61	3S12"	SV-1-T	T					EXTERNAL CONDUIT
⑦	1-A (7')						68 49	1S-W LED 1S-W LED	TP-2-T	
A	MUNI FEEDER POLE									
B	MUNI									
C	MUNI									
D	MUNI									
E	SL									

NOTE:
CABINET FOUNDATION TYPE: STD



2/28/08
2 REDOPENED SOUTH CROSSWALK
R0 TF

1 03/99 HOWARD STREET SIGNAL UPGRADE CONTRACT #1430N NO. DATE DESCRIPTION		CXL RO BY APP.		COMPLETION DATE / ELECTRICIAN INITIAL		DEPARTMENT OF PARKING AND TRAFFIC DIVISION OF TRAFFIC ENGINEERING CITY AND COUNTY OF SAN FRANCISCO		DRAWN: DATE: SCALE: JD/CXL 12/28/00 1"= 20'		TRAFFIC SIGNAL INVENTORY DIAGRAM		CNN NO. 24248000			
CHECK WITH TRACING TO SEE IF YOU HAVE LATEST REVISION						SHEET OF SHEETS 1 OF 1						10TH ST & HOWARD ST		REV. NO.	

EXTERNAL REFERENCES: TAT E-Plan\Scale 10x15D\Archived\10-34-22.dwg
 FINITS USED: ROAD AND SH. ROMANS SH. ROMANS SH. ROMANT 44
 SCALE FACTOR: 120
 PLOT SCALE: 1=1
 ORIGIN: SECTION
 FILE NAME: 10th_Inventory.dwg
 DATE: 03/09/01 16:40