

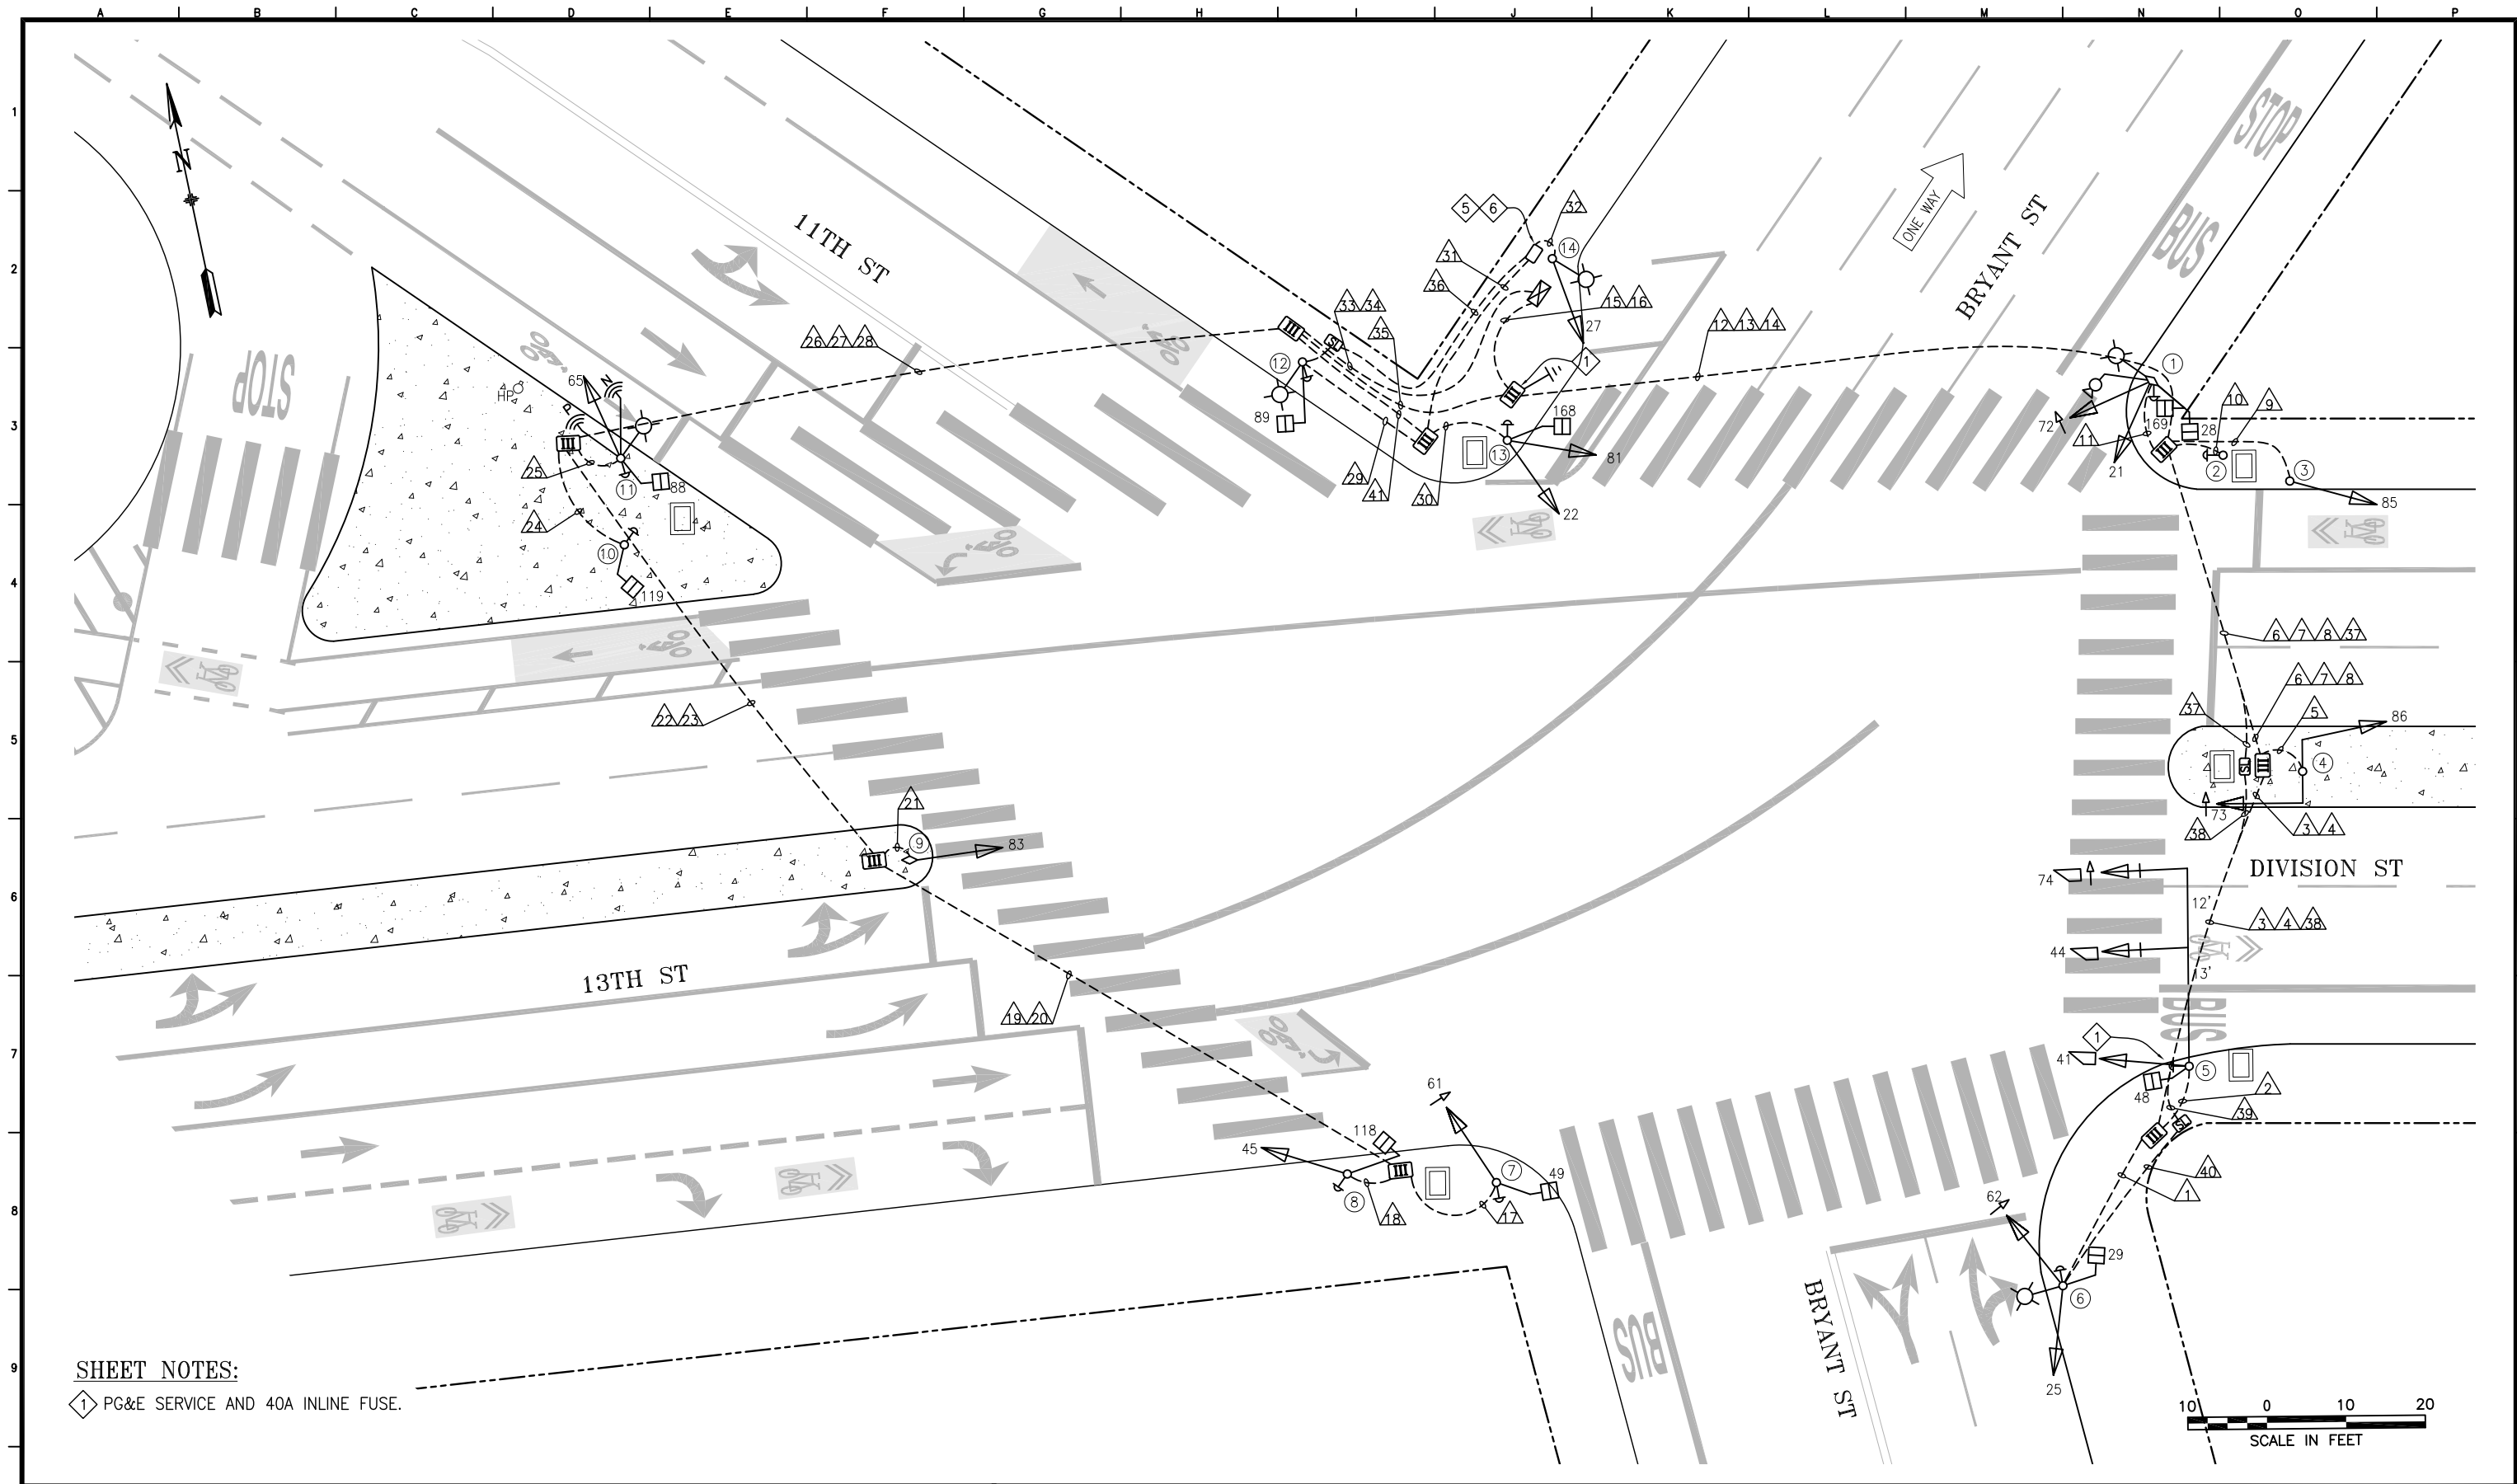


TABLE OF REVISIONS		CHECKOUT DRAWING THROUGH THE SID CUSTODIAN FOR THE LATEST REVISION	
NO.	DATE	DESCRIPTION	BY
1	09/03/22	ADDED CCTV CAMERA (SRC 2022-154)	S. ALEXANDER
0	07/08/20	UPGRADE ACTIVATED BY 2805J; CONVERTED FROM AS-BUILTS	J. HORNOSTEL
			M. VELASCO
			G. DELEON
			APPROVED



SFMTA

DRAWN BY:	DATE:
J. Hornbostel	10/25/2022
CHECKED BY:	DATE:
G. de Leon	10/25/2022

SCALE
AS SHOWN
SHEET OF SHEETS
1 OF 3

TRAFFIC SIGNAL INVENTORY DIAGRAM
11TH STREET, 13TH STREET, BRYANT STREET, AND DIVISION STREET

CNN NO:
24216000
REV NO:
1

POLE AND EQUIPMENT SCHEDULE											
POLE No.	TYPE OF POLE	LUMINAIRE VOLTAGE/WATTAGE	VEHICLE SIGNAL					PEDESTRIAN SIGNAL			REMARKS
			No.	TYPE	MOUNTING	VISORS	LOUVERS	No.	TYPE	MOUNTING	
①	MUNI POLE		21 72	3S12" 3S12"LA	SV-2-TC (20"/10")	T T		28 169	1S-COUNT 1S-COUNT	SP-2-SF	APS-2W CCTV CAMERA
②	PPB POLE										APS-2W
③	1-A (10')		85	3S12"	TV-1-T	T					
④	1-A (15')		73 86	3S12" 3S12"LA	SV-2-TA(24")	T T					
⑤	18-3-100 WITH 25' MA		41 44 74	3S12" 3S12" 3S12"LA	SV-1-T MAS MAS	RA RA RA		48	1S-COUNT	SP-1	APS-2W BACKPLATE BACKPLATE
⑥	CITY STANDARD STREET LIGHT		25 62	3S12" 4S12"GLA	SV-2-TA	T T		29	1S-COUNT	SP-1	APS-2W
⑦	1-A (10')		61	4S12"GLA	TV-1-T	T		49	1S-COUNT	SP-1	APS-2W
⑧	1-A (10')		45	3S12"	TV-1-T	T		118	1S-COUNT	SP-1	APS-2W
⑨	MUNI POLE		83	3S12"	SV-1	T					EXTERNAL CONDUIT
⑩	1-A (7')							119	1S-COUNT	TP-1	APS-2W
⑪	CITY STANDARD STREET LIGHT		65	3S12"	SV-1-T	T		88	1S-COUNT	SP-1	APS-2W PREEMPT RADIO NETWORK RADIO
⑫	CITY STANDARD STREET LIGHT							89	1S-COUNT	SP-1	APS-2W
⑬	1-A (10')		22 81	3S12" 3S12"	TV-2-T	T T		168	1S-COUNT	SP-1	APS-2W
⑭	CITY STANDARD STREET LIGHT		27	3S12"	SV-1-T	T					

1	09/03/22	ADDED CCTV CAMERA (SRC 2022-154)				S. ALEXANDER		M. VELASCO			
0	07/08/20	UPGRADE ACTIVATED BY 2805J; CONVERTED FROM AS-BUILTS				J. HORNPOSTEL		G. DELEON			
NO.	DATE	DESCRIPTION				BY		APPROVED			
TABLE OF REVISIONS											
CHECKOUT DRAWING THROUGH THE SID CUSTODIAN FOR THE LATEST REVISION											

		SFMTA	DRAWN BY:		DATE:	SCALE AS SHOWN SHEET OF SHEETS 2 OF 3	TRAFFIC SIGNAL INVENTORY DIAGRAM	CNN NO:
			J. Hornbostel		10/26/2022			24216000
			CHECKED BY:		DATE:			REV NO:
			G. de Leon		10/26/2022			
							11TH STREET, 13TH STREET, BRYANT STREET, AND DIVISION STREET	1

CONDUIT AND WIRING SCHEDULE (FURNISH AND INSTALL CONDUIT AND WIRES)																																										
CONDUIT RUN NUMBER		1	2	3	4	5	6	7	8	9	10	11	12	13	14	15	16	17	18	19	20	21	22	23	24	25	26	27	28	29	30	31	32	33	34	35	36	37	38	39	40	41
CONDUIT SIZE (INCH)		2	2	2	2	2	2	2	2	2	1	UNK	2	2	2	3	2	2	2	2	2	1	2	2	2	2	2	2	2	2	2	2	UNK	3	2	2	2	2	2	2	2	2
					SP		GRS		SP	GRS		GRS			SP						SP	GRS		SP	GRS	GRS			SP			GRS		SP	SP	GRS	GRS	GRS	GRS	GRS		
NOTES																																										
	VEHICLE SIGNAL 25	3		3			3						3			3																										
	VEHICLE SIGNAL 62	4		4			4						4			4																										
	PED SIGNAL 29	2		2			2						2			2																										
	APS XING BRYANT ON POLE 6	2		2			2						2			2																										
	VEHICLE SIGNAL 41		3	3			3						3			3																										
	VEHICLE SIGNAL 44		3	3			3						3			3																										
	VEHICLE SIGNAL 74		3	3			3						3			3																										
	PED SIGNAL 48		2	2			2						2			2																										
	APS XING DIVISION ON POLE 5		2	2			2						2			2																										
	VEHICLE SIGNAL 73					3		3						3		3																										
	VEHICLE SIGNAL 86					3		3						3		3																										
	VEHICLE SIGNAL 85									3				3		3																										
	APS XING DIVISION ON POLE 2										2			3		3																										
	VEHICLE SIGNAL 21											3		3		3																										
	VEHICLE SIGNAL 72											3		2		2																										
	PED SIGNAL 28											2		2		2																										
	PED SIGNAL 169											2		2		2																										
	APS XING BRYANT ON POLE 1											2		2		2																										
	APS XING BRYANT ON POLE 7																	2		2			2				2						2									
	VEHICLE SIGNAL 61																	4		4			4				4						4									
	PED SIGNAL 49																	2		2			2				2						2									
	VEHICLE SIGNAL 45																			3	3			3			3					3										
	PED SIGNAL 118																		2	2			2				2						2									
	APS XING 13TH ST ON POLE 8																		2	2			2				2						2									
	VEHICLE SIGNAL 83																				3	3				3							3									
	PED SIGNAL 119																								2			2						2								
	APS XING 13TH ST ON POLE 10																									2		2						2								
	VEHICLE SIGNAL 65																									3		3						3								
	PED SIGNAL 88																									2		2						2								
	APS XING 11TH ST ON POLE 11																									2		2						2								
	PED SIGNAL 89																													2				2							2	
	APS XING 11TH ST ON POLE 12																													2				2							2	
	VEHICLE SIGNAL 22																															3			3						3	
	VEHICLE SIGNAL 81																																3			3					3	
	PED SIGNAL 168																																2			2					2	
	APS XING BRYANT ST ON POLE 13																																2			2					2	
	VEHICLE SIGNAL 27																																	3	3	3					3	
	#14 NEUTRAL	3	4			1				1		3						2	2			1			1	2			1	2	1	1										
	#14 SPARE			3			3						3			3				3			3				3							3								
	TOTAL #14 WIRES	14	17	27		7	27	6		4	2	15	27	23		50		10	9	18		4	21		5	9	21	11		5	12	4	4	49								
	#10 WIRES NEUTRAL			1			1	1					1	2		3				1			2					2	1					4								
	#10 WIRES STREET LIGHT											2														2										2					2	
	#8 WIRES STREET LIGHT																																				2			2		
	#8 WIRES (120 V SERVICE)																2																									
	CAT 6 (CCTV)											1		1		1																										

																																																																																																																																																																																																																																																																																																																																																																																																																																																																																																																																																																																																																																																																																																																																																																																																																																																																																																																																																																																																																																																																																																																																																																																																																																																																																																																																																																																																																					</
--	--	----