


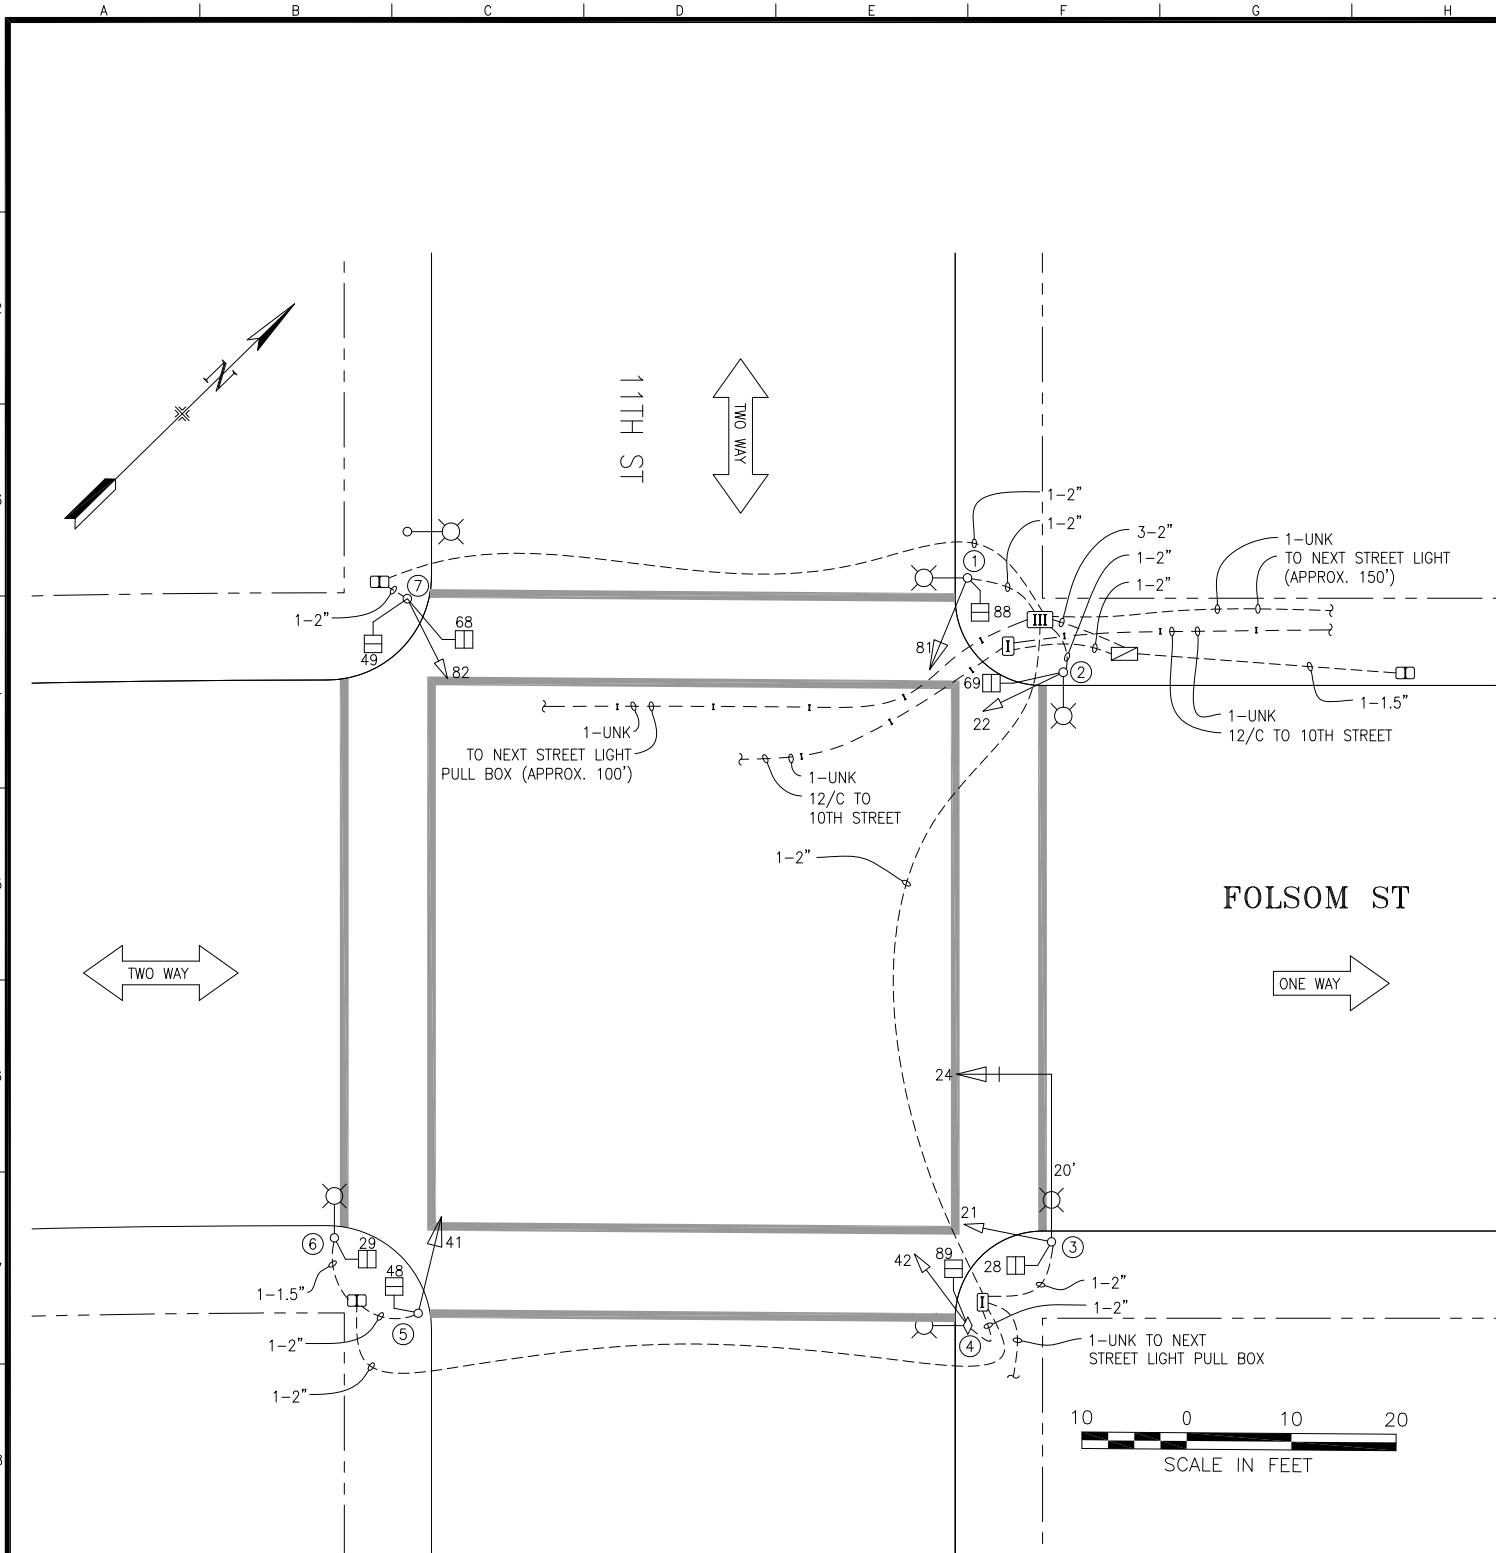

POLE AND EQUIPMENT SCHEDULE										
POLE No.	TYPE OF POLE	VEHICLE SIGNAL					PEDESTRIAN SIGNAL			REMARKS
		No.	TYPE	MOUNTING	VISORS	LOUVERS	No.	TYPE	MOUNTING	
①	STREET LIGHT	81	3S12"	SV-1-T	T		88	1S-COUNT	SP-1	
②	STREET LIGHT	22	3S8"	SV-1-T	T		69	1S-COUNT	SP-1	
③	17B-1-70 WITH 20' MAST ARM AND 6' LUMINAIRE ARM	24 21	3S12" 3S8"	MAS SV-1-T	T T		28	1S-COUNT	SP-1	BACKPLATE
④	STREET LIGHT AND MUNI POLE	42	3S8"	SV-1-T	T		89	1S-COUNT	SP-1	
⑤	1-A (10')	41	3S12"	TV-1-T	T		48	1S-COUNT	SP-1	
⑥	STREET LIGHT						29	1S-COUNT	SP-1	
⑦	1-A (10')	82	3S8"	TV-1	T		49 68	1S-COUNT 1S-COUNT	SP-1 (22") SP-1-SF (12")	

0	05/13/04	SIGNAL UPGRADE BY 0435J; CONVERTED FROM AS-BUILTS	AU	MS	
NO.	DATE	DESCRIPTION	BY	APP.	
TABLE OF REVISIONS					
CHECK WITH TRACING TO SEE IF YOU HAVE LATEST REVISION					

REFERENCE INFORMATION & FILE NO. OF SURVEYS



SAN FRANCISCO MUNICIPAL TRANSPORTATION AGENCY

CITY AND COUNTY OF SAN FRANCISCO

DRAWN:	DATE:
AU	02/2019
CHECKED:	DATE:
MS	02/2019

SCALE:
AS SHOWN
SHEET OF SHEETS

TRAFFIC SIGNAL INVENTORY DIAGRAM
11TH ST & FOLSOM ST

CNN NO.
24238000
REV NO.
0