


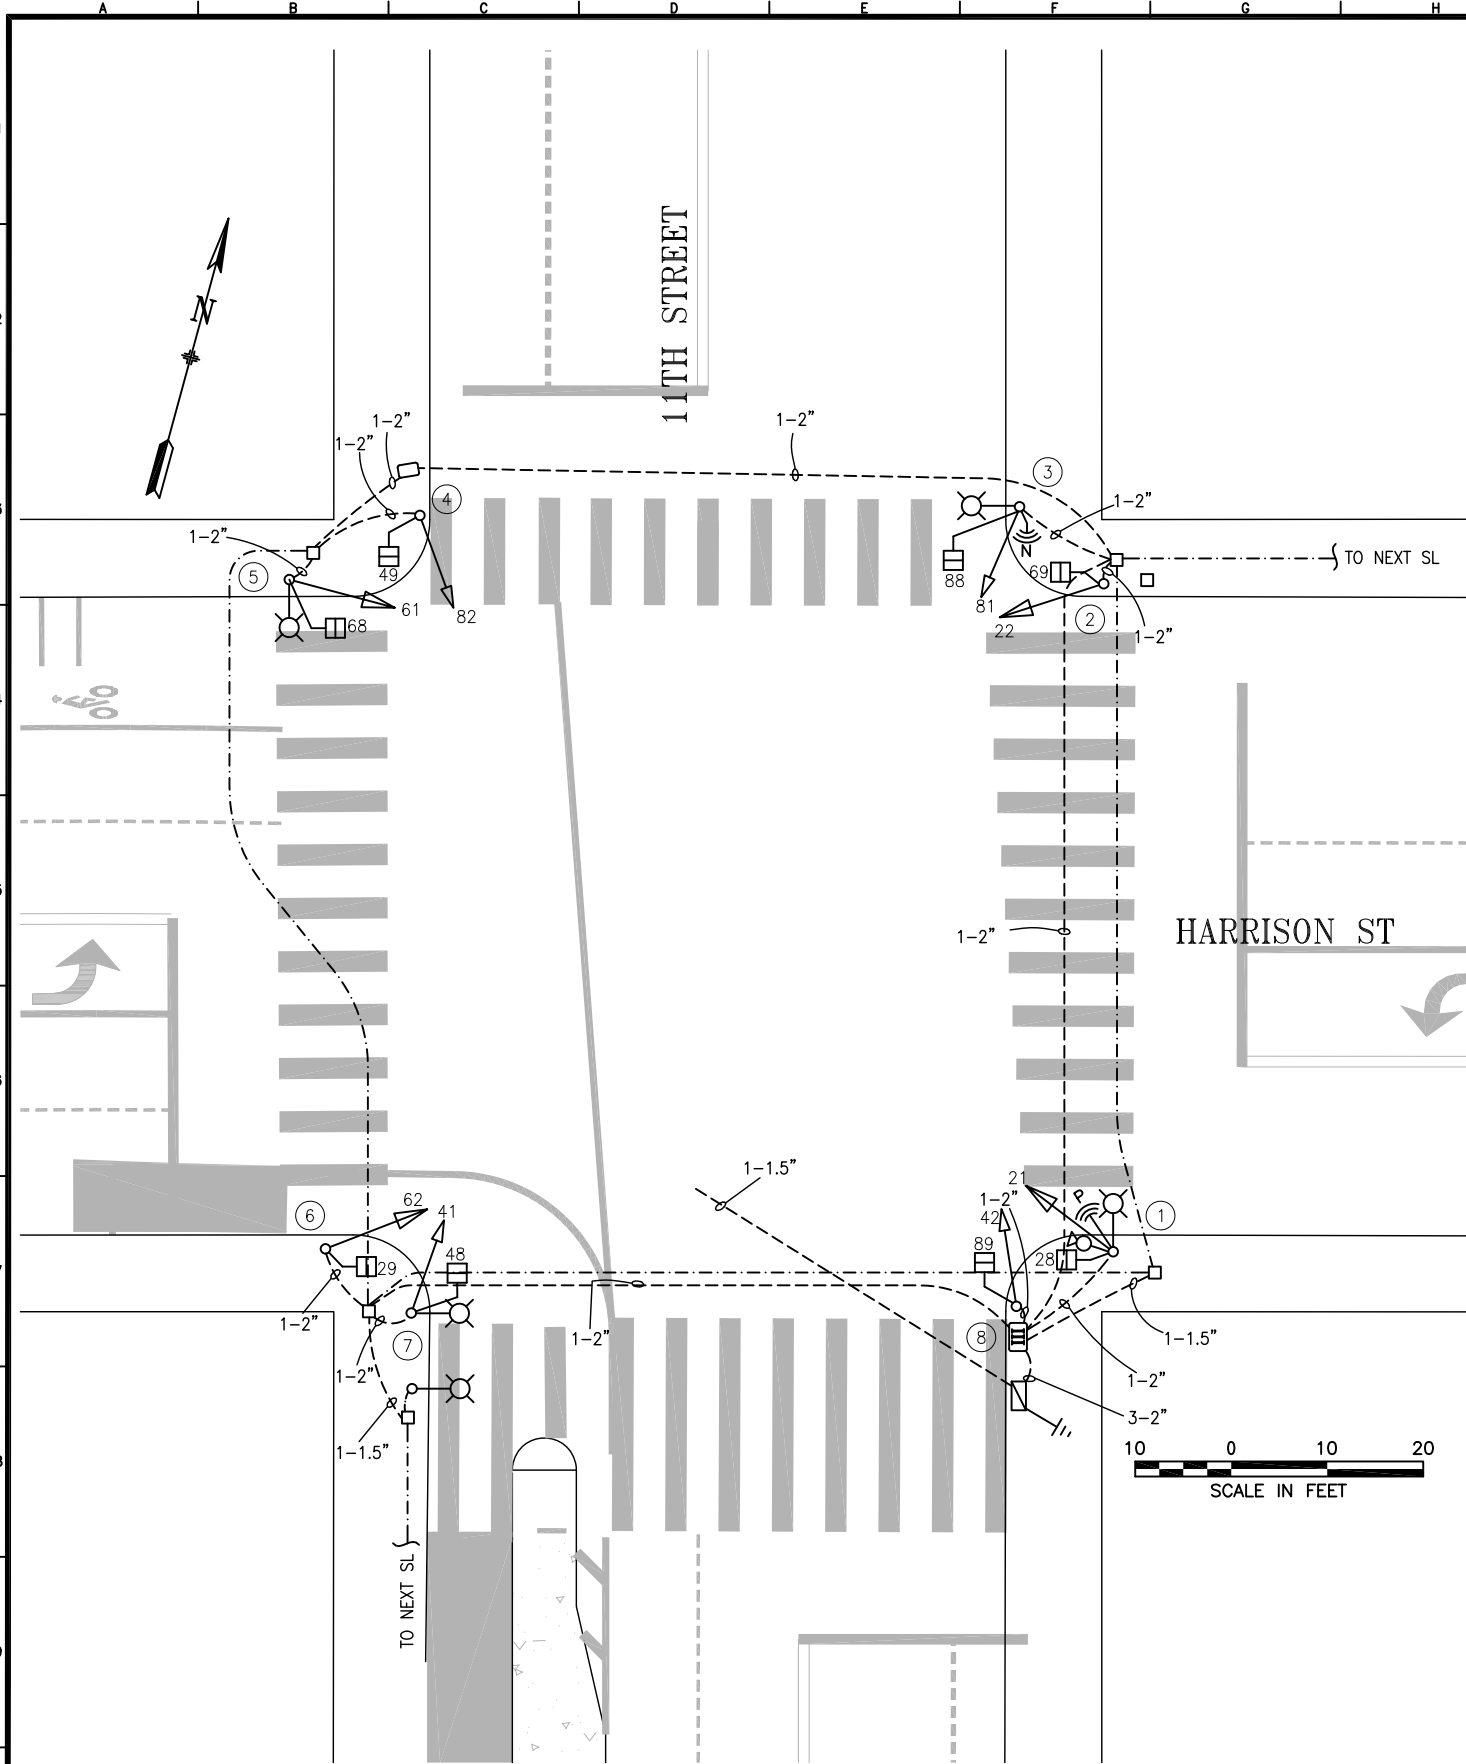

POLE No.	TYPE OF POLE	LUMINAIRE (HPS)	VEHICLE SIGNAL			PEDESTRIAN SIGNAL			REMARKS
		VOLTAGE/ WATTS	No.	TYPE	MOUNTING	No.	TYPE	MOUNTING	
①	CITY STANDARD SL WITH 6' LUMINAIRE ARM.	120/250 W	21	3S12"	SV-1-T	28	1S-COUNT	SP-1	CCTV CAMERA PREEMPT RADIO
②	1-A (10')		22	3S12"	TV-1-T	69	1S-COUNT	SP-1	
③	CITY STANDARD SL WITH 6' LUMINAIRE ARM.	120/200 W	81	3S8"	SV-1-T	88	1S-COUNT	SP-1	NETWORK RADIO
④	1-A (10')		82	3S8"	TV-1	49	1S-COUNT	SP-1	
⑤	CITY STANDARD SL WITH 6' LUMINAIRE ARM.	120/250 W	61	3S12"	SV-1-T	68	1S-COUNT	SP-1	
⑥	1-A (10')		62	3S12"	TV-1-T	29	1S-COUNT	SP-1	
⑦	CITY STANDARD SL WITH 6' LUMINAIRE ARM		41	3S8"	TV-1	48	1S-COUNT	SP-1	CONTRACTOR INSTALLED SL POLE AND FOUNDATION BY MISTAKE, PAID FOR 1-A (10') POLE / FOUNDATION.
⑧	1-A (10')		42	3S8"	TV-1	89	1S-COUNT	SP-1	

4	9/3/22	ADDED CCTV CAMERA (SRC 2022-154); PER FIELD; ADDED PREEMPT RADIO AND NETWORK RADIO	S. ALEXANDER	M. VELASCO
3	10/2/14	CHANGED HEADS 22 & 62 TO 12-INCH	M. VELASCO	H. QUAN
2	3/30/11	ADDED PED SIGNALS FOR ALL XINGS - SRC 2010-078	E. TSUI	H. QUAN
1	9/27/99	UPDATED PER AS-BUILT	BC	
NO.	DATE	DESCRIPTION	BY	APPROVED
TABLE OF REVISIONS CHECKOUT DRAWING THROUGH THE SID CUSTODIAN FOR THE LATEST REVISION				



DRAWN BY: BC	DATE: 12/16/96
CHECKED BY: SWT	DATE: 12/16/96

SCALE AS SHOWN
SHEET OF SHEETS 1 OF 1

TRAFFIC SIGNAL INVENTORY DIAGRAM
11TH STREET & HARRISON STREET

CNN NO: 24229000
REV NO: 4