


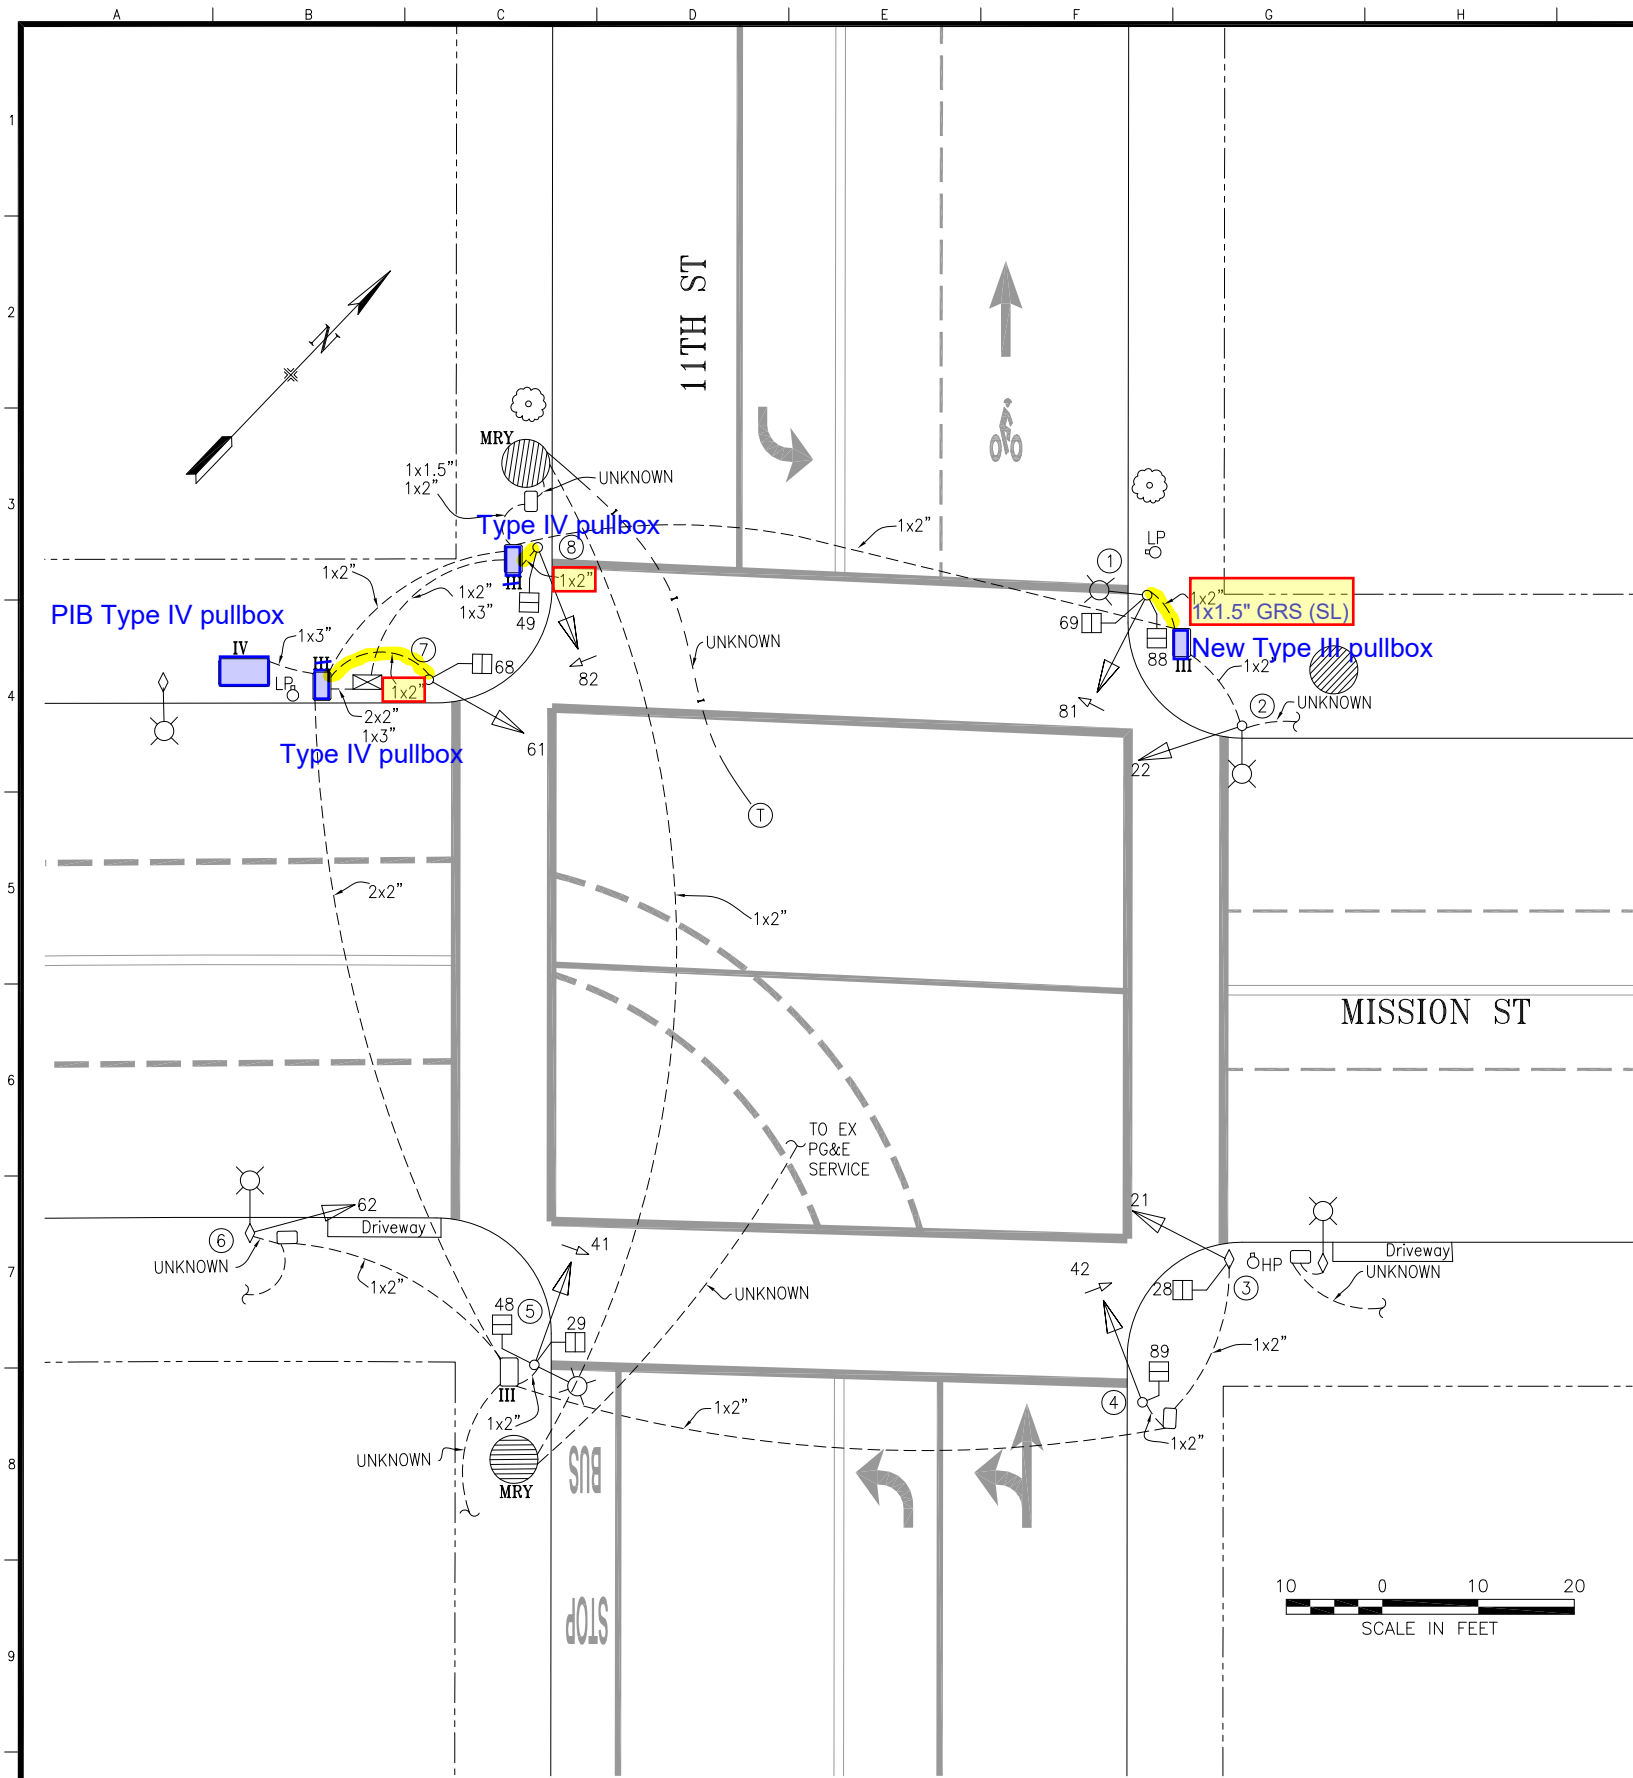

POLE AND EQUIPMENT SCHEDULE											
POLE No.	TYPE OF POLE	LUMINAIRE VOLTAGE/WATTAGE	VEHICLE SIGNAL					PEDESTRIAN SIGNAL			REMARKS
			No.	TYPE	MOUNTING	VISORS	LOUVERS	No.	TYPE	MOUNTING	
①	CITY STANDARD STREET LIGHT (N)		81	4S12"GLA	SV-1-T	T		69 88	1S-COUNT 1S-COUNT	SP-2-T	
②	MUNI WITH 6' LUMINAIRE ARM		22	3S12"	SV-1-T	T					
③	MUNI		21	3S12"	SV-1-T	T		28	1S-COUNT	SP-1-T	EXTERNAL CONDUIT
④	1-A (10')		42	4S12"GLA	TV-1	T		89	1S-COUNT	SP-1	
⑤	CITY STANDARD SL WITH 6' LUMINAIRE ARM	120/200	41	4S12"GLA	SV-1-T	T		29 48	1S-COUNT 1S-COUNT	SP-1-SF(12") SP-1(22")	PROXIM GPS TSP EQUIPMENT
⑥	MUNI		62	3S12"	SV-1-T	T					MOUNT @ 13'
⑦	1-A (10') (N)		61	3S12"	TV-1-T	T		68	1S-COUNT	SP-1(22")	
⑧	1-A (10') (N)		82	4S12"GLA	TV-1 TV-1-T	T		49	1S-COUNT	SP-1	

Note: All pole and equipment in highlighted boxes above are new.

Note: Highlighted conduits and pullboxes are new

As-Built
Phoenix Electric
Drafter, Wilson Lew
7/26/21
received N.Wong

TABLE OF REVISIONS			
NO.	DATE	DESCRIPTION	BY APP.
1	3/22/16	SPLIT PHASE FOR 11TH STREET	JRS BW
0	5/14/03	UPGRADE ACTIVATED THRU 1663NR; CONVERTED FROM CONTRACT PLANS	AScales Mvelasco

CHECK WITH TRACING TO SEE IF YOU HAVE LATEST REVISION

REFERENCE INFORMATION
& FILE NO. OF SURVEYS



SAN FRANCISCO MUNICIPAL TRANSPORTATION AGENCY
CITY AND COUNTY OF SAN FRANCISCO

DRAWN:	DATE:
AScales	6/2015
CHECKED:	DATE:
Mvelasco	6/2015

SCALE:
AS SHOWN
SHEET OF SHEETS
1 OF 1

TRAFFIC SIGNAL INVENTORY DIAGRAM

11TH STREET AND MISSION STREET

CNN NO.
24421000
REV NO.
1