


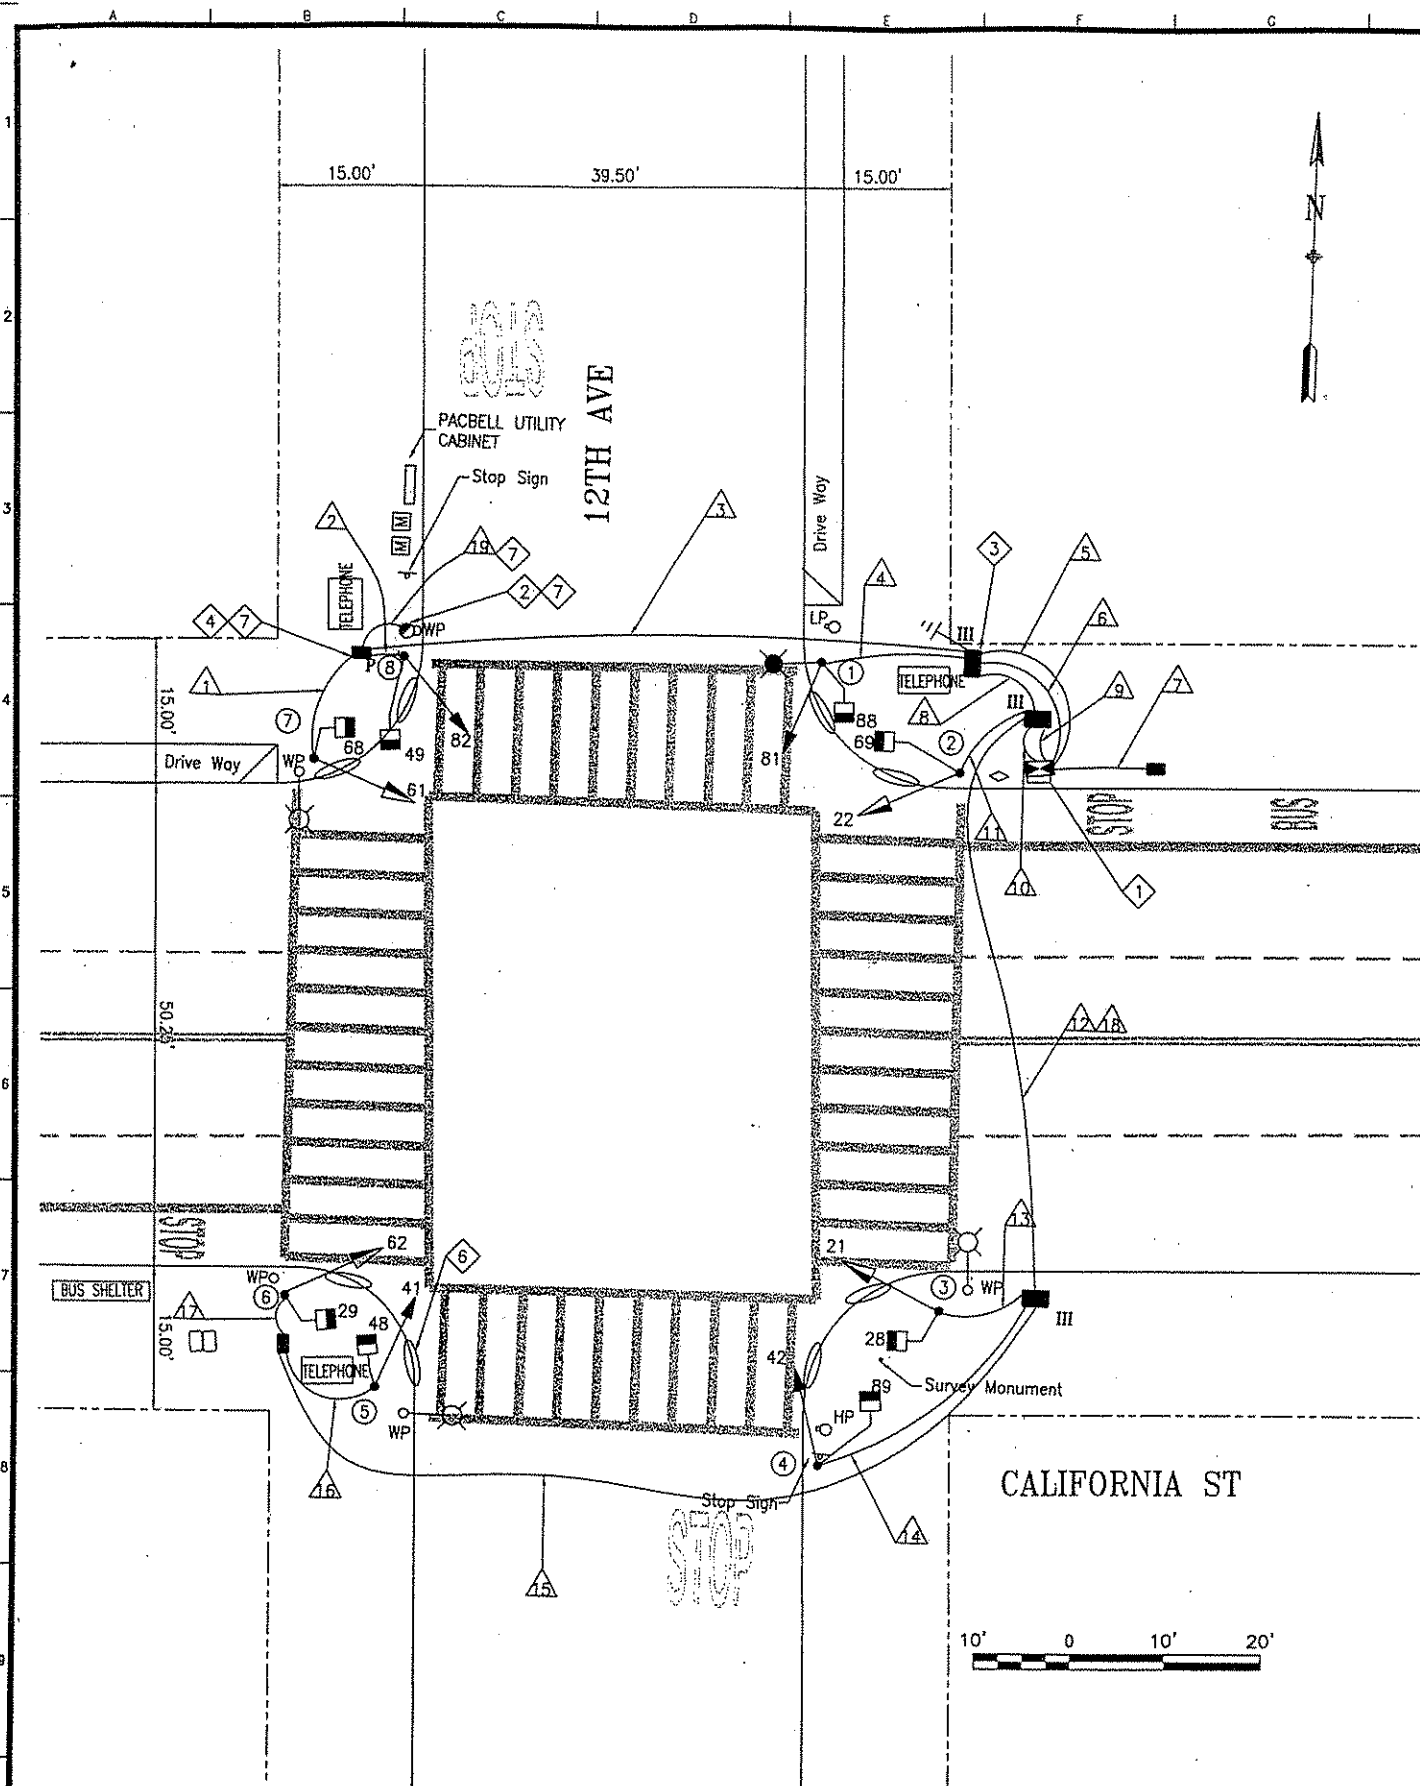


POLE AND EQUIPMENT SCHEDULE												
POLE No.	TYPE OF POLE	LUMINAIRE (HPS)	VEHICLE SIGNAL					PEDESTRIAN SIGNAL			REMARKS	
		VOLTAGE/ WATTS	No.	TYPE	MOUNTING	VISORS	LOUVERS	No.	TYPE	MOUNTING		
①	CITY STANDARD STREET LIGHT	5	120V/100W	81	3S8"	SV-1-T	T		88	1S-COUNT	SP-1	
②	1-A (10')			22	3S12"	TV-1-T	T		69	1S-COUNT	SP-1	
③	1-A (10')			21	3S12"	TV-1-T	T		28	1S-COUNT	SP-1	
④	1-A (10')			42	3S8"	TV-1	T		89	1S-COUNT	SP-1	
⑤	1-A (10')			41	3S8"	TV-1	T		48	1S-COUNT	SP-1	
⑥	1-A (10')			62	3S12"	TV-1-T	T		29	1S-COUNT	SP-1	
⑦	1-A (10')			61	3S12"	TV-1-T	T		68	1S-COUNT	SP-1	
⑧	1-A (10')			82	3S8"	TV-1	T		49	1S-COUNT	SP-1	

SHEET NOTES

- ① CONTRACTOR SHALL CONTACT DPW TO RELOCATE GARBAGE CAN.
- ② CONTRACTOR SHALL COORDINATE WITH PG&E VIA WALLY SUN OF HETCH HETCHY AT (415) 554-1873 FOR SERVICE CONNECTION WORK PRIOR TO START OF CONSTRUCTION.
- ③ F/I IN-LINE FUSE HOLDER W/ 40 A FUSE FOR IC SERVICE.
- ④ F/I IN-LINE FUSE HOLDER W/ 20 A FUSE FOR SL SERVICE.
- ⑤ F/I WITH INTEGRAL BALLAST AND PHOTOELECTRIC CONTROL. F/I FUSE AND FUSE HOLDERS PER SPDWSF FILE 49,092.
- ⑥ CONTRACTOR SHALL COORDINATE WITH BOB PICKARD FROM SBC (FORMERLY PAC BELL) AT (415) 542-9095 PRIOR TO CONSTRUCTION OF CURB RAMP TO RELOCATE EX. TELEPHONE PULL BOX.
- ⑦ F/I PG&E SPLICE BOX, SERVICE CONDUITS, AND RISERS.
- INSTALL CURB RAMP. SEE DRAWINGS R-0, R-2, CR-1, CR-2, AND CR-3

PLANS ARE TO BE RETURNED WITH CORRECTIONS MADE AND CERTIFIED TO IN RED INK AND DATED BY THE INSPECTOR IN CHARGE UPON COMPLETION OF THE WORK BEFORE FINAL PAYMENT CAN BE MADE.

PHASE DIAGRAM

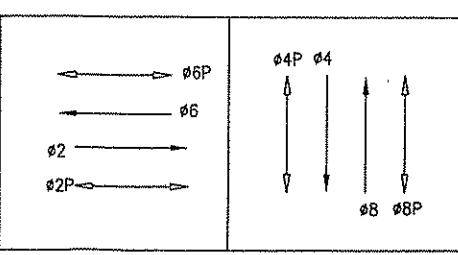

PHASE SEQUENCE

G	Y	R	CALIFORNIA ST (EB AND WB)
R	G	Y	12TH AVE (NB AND SB)
WM	FRH	RH	PED XING 12TH AVE (N/S AND S/S)
RH	WM	FRH	PED XING CALIFORNIA ST (E/S AND W/S)

AS-BUILT DRAWING

REFERENCE INFORMATION & FILE NO. OF SURVEYS		DESIGNED: DATE: 7/25/03		APPROVED: 7/30/03		SCALE: AS SHOWN		CONTRACT 54		SPECIFICATION NO. 0309J	
DRAWN: DATE: 7/25/03		CHECKED: DATE: 7/25/03		CITY TRAFFIC ENGINEER DATE: 7/30/03		SHEET OF SHEETS 1 OF 2		NEW TRAFFIC SIGNALS (CHANGE ORDER)		DRAWING NO.	
TABLE OF REVISIONS		FILE NO.		12TH AVENUE AND CALIFORNIA STREET		REV. NO.					
CHECK WITH TRACING TO SEE IF YOU HAVE LATEST REVISION											



DEPARTMENT OF PARKING AND TRAFFIC
DIVISION OF TRAFFIC ENGINEERING
CITY AND COUNTY OF SAN FRANCISCO

EXTERNAL REFERENCES: T.V. E. FILES/Specid Projects & Street Use/Projects/CT 56/1b3422.dwg
FONTS USED: ltypshp.shx ROMAND.shx ROMANS.shx ROMANT.shx
SCALE FACTOR: 10
PLOT SCALE: 1"=1'

