


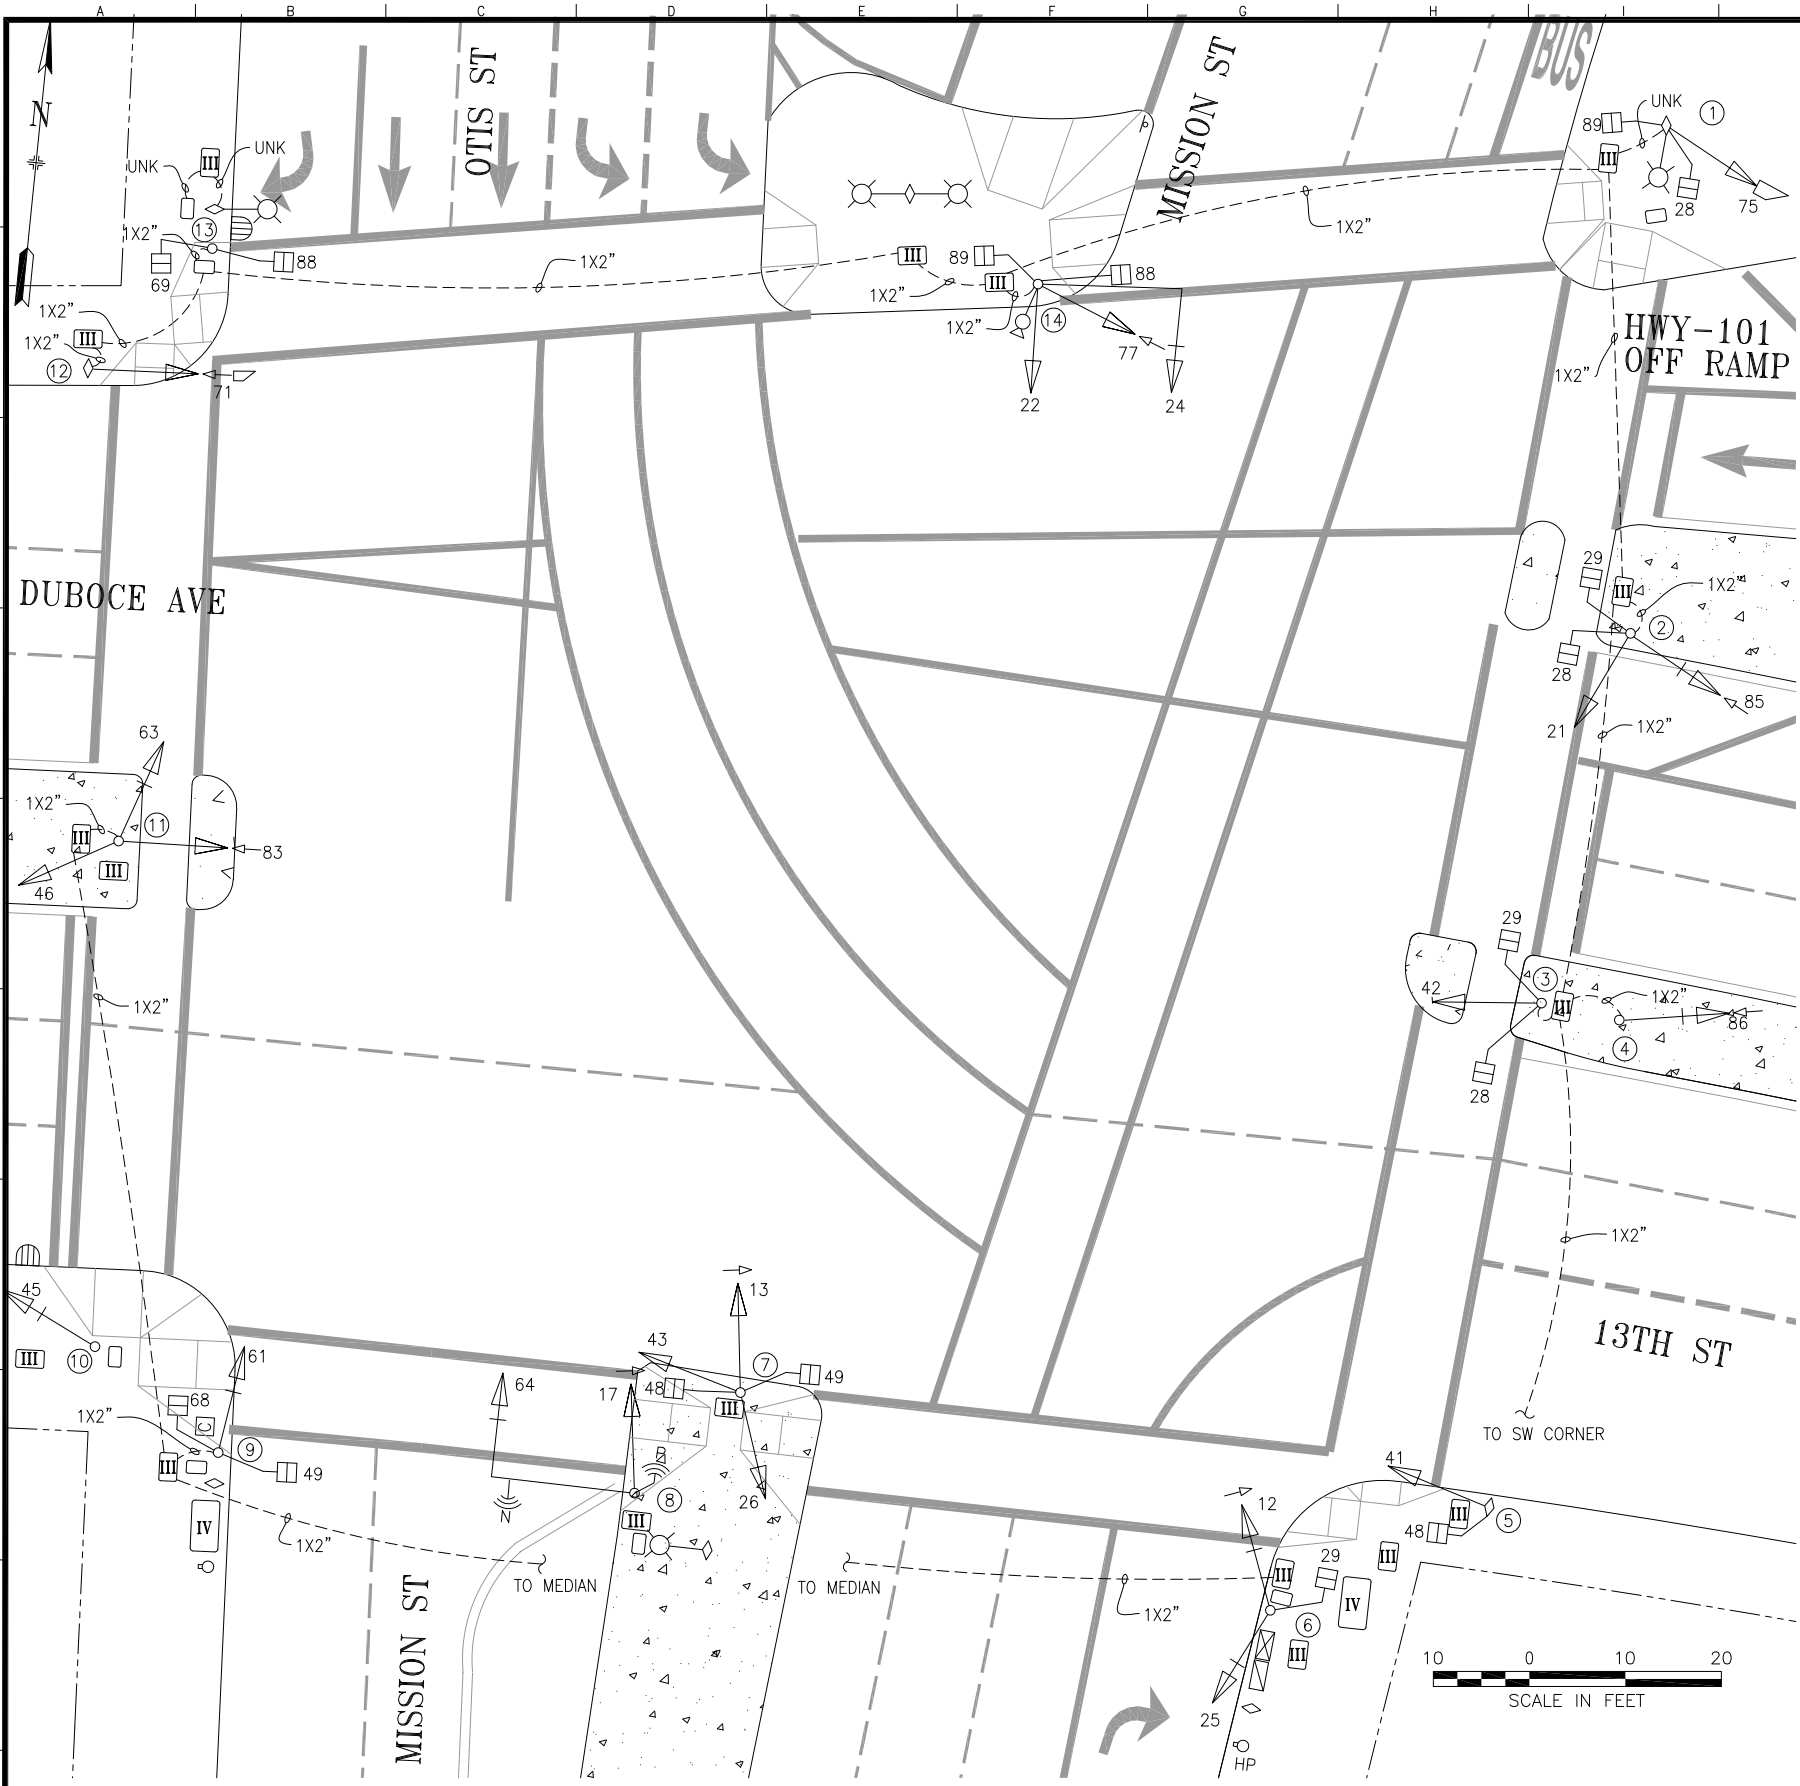

POLE AND EQUIPMENT SCHEDULE											
POLE No.	TYPE OF POLE	LUMINAIRE VOLTAGE/WATTAGE	VEHICLE SIGNAL					PEDESTRIAN SIGNAL			REMARKS
			No.	TYPE	MOUNTING	VISORS	LOUVERS	No.	TYPE	MOUNTING	
①	MUNI POLE W/ 6' LUMINAIRE ARM		75	3S12"	SV-1	LA		28 89	1S-COUNT 1S-COUNT	SP-2-T-SF	
②	1-A (10')		21 85	3S12" 3S12"GSA	TV-2-T	T T		28 29	1S-COUNT 1S-COUNT	SP-2-T	BACKPLATE FOR SIGNAL 85
③	1-A (10')		42	3S12"	TV-1-T	T		28 29	1S-COUNT 1S-COUNT	SP-2-T	
④	1-A (10')		86	3S12"GSA	TV-1-T	T					BACKPLATE
⑤	TYPE 33		41	3S12"	SV-1-T	T		48	1S-COUNT	SP-1	MOUNT 41 AT 13 FEET
⑥	1-A (10')		12 25	3S12"LA 3S12"	TV-2-T	T T		29	1S-COUNT	SP-1	BACKPLATE BACKPLATE
⑦	1-A (10')		13 43 26	3S12"LA 3S12" 3S12"	TV-3-TA	T T T		48 49	1S-COUNT 1S-COUNT	SP-2-T	
⑧	TYPE 33 W/ 15' MA		17 64	3S12"LA 3S12"	SV-1-T MAS	T T					BACKPLATE #64 PREEMPT & NETWORK RADIOS
⑨	1-A (10')		61	3S12"	TV-1-T	T		49 68	1S-COUNT 1S-COUNT	SP-2-T-SF	BACKPLATE
⑩	1-A (10')		45	3S12"	TV-1-T	T					BACKPLATE
⑪	1-A (10')		46 63 83	3S12" 3S12" 3S12"GSA	TV-3-TA	T T T					BACKPLATE FOR SIGNAL 63
⑫	TYPE 33		71	3S12"GSA	SV-1-T	LA					
⑬	1-A (7')							69 88	1S-COUNT 1S-COUNT	TP-2-T	
⑭	TYPE 33 W/ 15' MA		77 22 24	3S12"GSA 3S12" 3S12"	SV-2-TA MAS	T T T		88 89	1S-COUNT 1S-COUNT	SP-2-T	BACKPLATE FOR SIGNAL 24 SFGO CAMERA

11/29/22	UPDATE PER FIELD: ALL 1-B POLES TO 1-A. PER SRC 2022-244, INSTALL BACKPLATES ON SIGNALS 63, 85, AND 86.	E. TANG	A.LAM	
09/06/16	UPGRADE 45 TO 12", REPLACE 71&77 PV WITH 12" GSA, GIVE 71 & 75 LA VISORS, AND INSTALL SIGNAL 26 PER SRC 2015-385	A. SCALES	M.VELASCO	
10/29/03	UPGRADE ACTIVATED THRU 04-291404; CONVERTED FROM AS-BUILTS	A. SCALES	M.VELASCO	
NO.	DATE	DESCRIPTION	BY	APPROVED
TABLE OF REVISIONS				
CHECKOUT DRAWING THROUGH THE SID CUSTODIAN FOR THE LATEST REVISION				



SFMTA

DRAWN BY: A. SCALES	DATE: 10/2015	SCALE AS SHOWN	TRAFFIC SIGNAL INVENTORY DIAGRAM 13TH STREET, DUBOCE AVENUE, MISSION STREET, AND OTIS STREET	CNN NO: 33027000
CHECKED BY: M. VELASCO	DATE: 10/2015	SHEET OF SHEETS 1 OF 1		REV NO: 2