


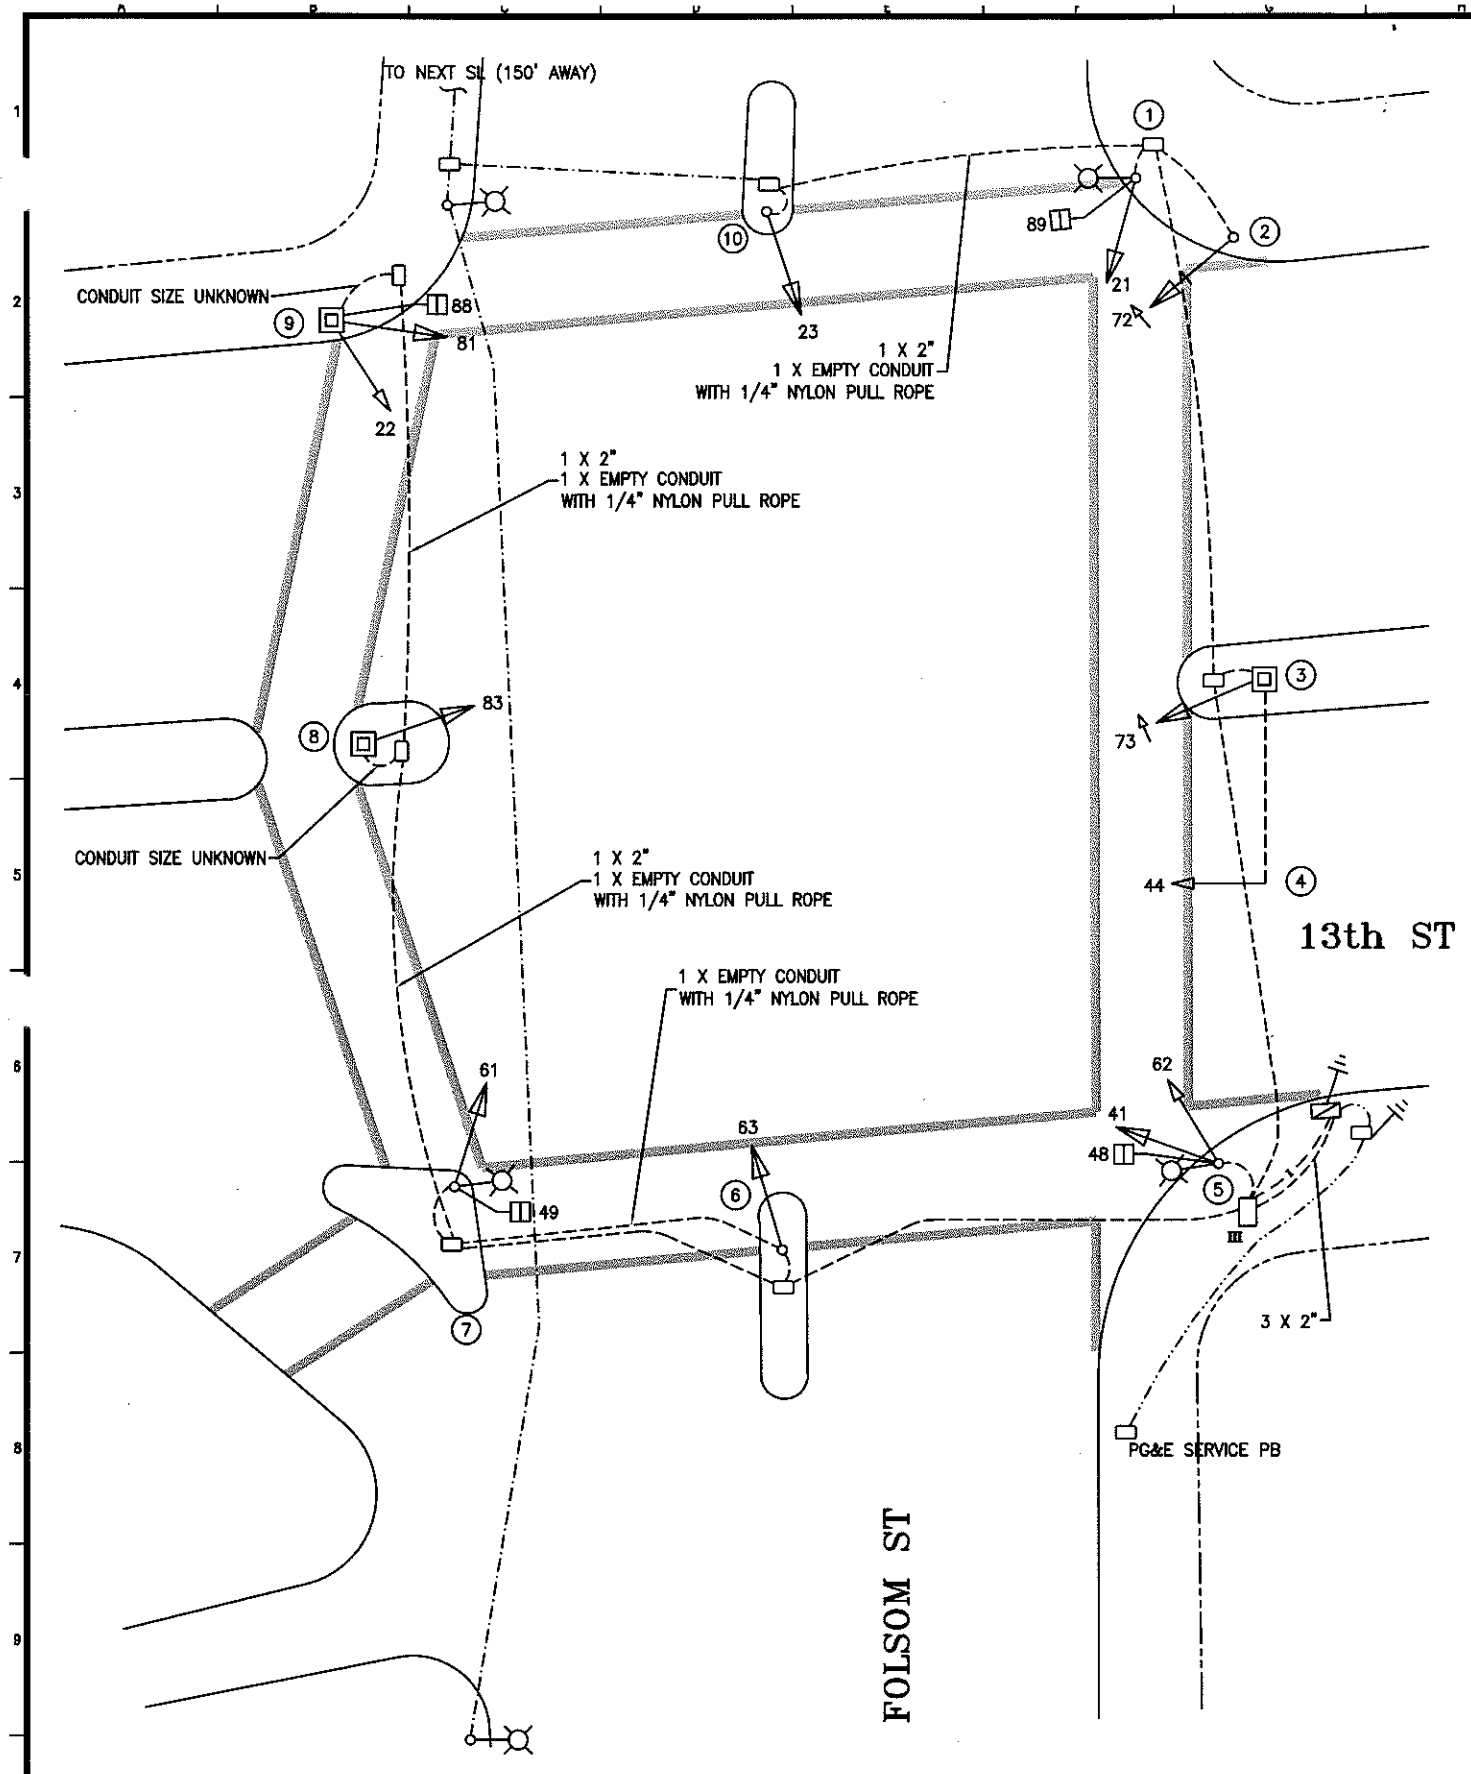

POLE AND EQUIPMENT SCHEDULE										
POLE No.	TYPE OF POLE	VEHICLE SIGNAL					PEDESTRIAN SIGNAL			REMARKS
		No.	TYPE	MOUNTING	VISORS	LOUVERS	No.	TYPE	MOUNTING	
①	SL	21	3S12"	SV-1-T	T		89	1S-IN	SP-1	
②	1-A (10')	72	3S12"LA	TV-1	T					BP
③	EX FREEWAY PIER	73	3S12"	SV-1-T	T					EXTERNAL CONDUIT
④	FREEWAY STRUCTURE	44	3S12"R+8"YG	SPECIAL	T					
⑤	SL	41 62	3S12" 3S8"	SV-2-TA	T T		48	1S-IN	SP-1	
⑥	1-A (10')	63	3S12"	TV-1-T	T					
⑦	SL	61	3S12"	SV-1-T	T		49	1S-IN	SP-1	
⑧	EX FREEWAY PIER	83	3S12"	SV-1-T	T					EXTERNAL CONDUIT
⑨	EX FREEWAY PIER	22 81	3S8" 3S12"	SV-2-TA	T T		88		SPECIAL	EXTERNAL CONDUIT
⑩	1-A (10')	23	3S12"	TV-1-T	FC					

NOTE:

CABINET FOUNDATION TYPE: STD



NO.	DATE	DESCRIPTION	DVC	RO
1	02/99	FOLSOM STREET SIGNAL IMPROVEMENT CT#1302N		
TABLE OF REVISIONS				
CHECK WITH TRACING TO SEE IF YOU HAVE LATEST REVISION				



DEPARTMENT OF PARKING AND TRAFFIC
DIVISION OF TRAFFIC ENGINEERING
CITY AND COUNTY OF SAN FRANCISCO

DRAWN:	DATE:	SCALE:
DVC	5/1/01	1" = 20'
CHECKED:	DATE:	SHEET OF SHEETS
RO	9/10/01	1 OF 1

TRAFFIC SIGNAL INVENTORY DIAGRAM		CNN NO.
13TH ST AND FOLSOM ST		24349000
		REV. NO.
		1

EXTERNAL REFERENCES: T1, T2, T3, T1906,