


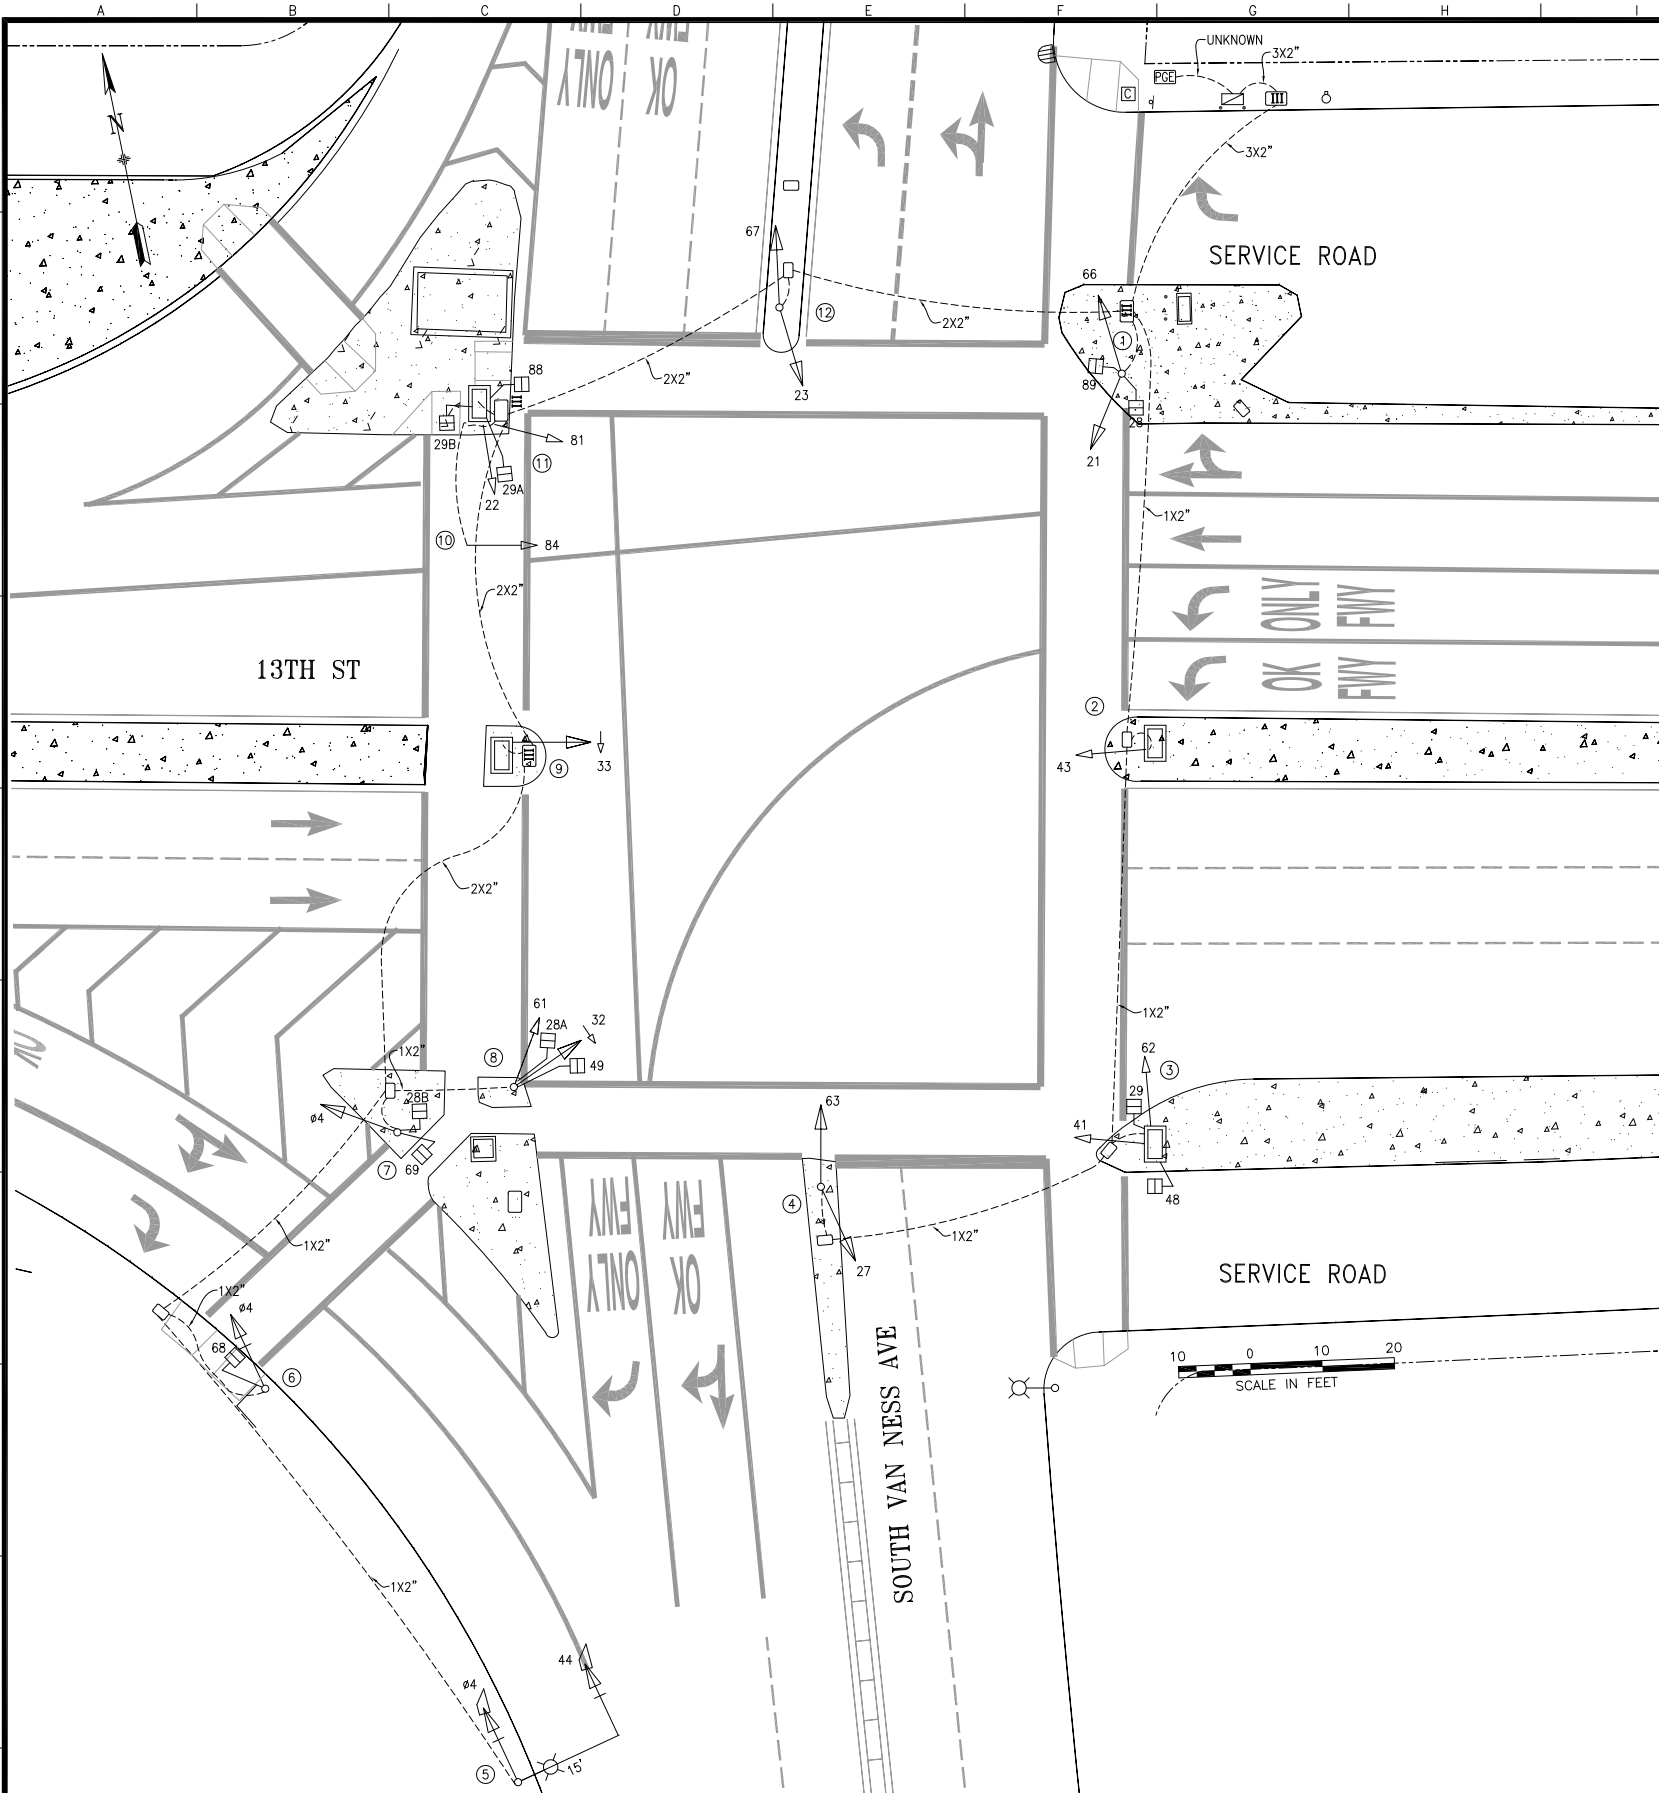

POLE AND EQUIPMENT SCHEDULE											
POLE No.	TYPE OF POLE	LUMINAIRE VOLTAGE/ WATTAGE	VEHICLE SIGNAL					PEDESTRIAN SIGNAL			REMARKS
			No.	TYPE	MOUNTING	VISORS	LOUVERS	No.	TYPE	MOUNTING	
①	1-A (10')		21 66	3S12" 3S12"	TV-2-T-SFA	T T		28 89	1S-COUNT 1S-COUNT	SP-2-T	21 RED BALL IS 12"
②	FREEWAY COLUMN		43	3S8"	SV-1 (CUSTOM)	T					EXTERNAL CONDUIT
③	FREEWAY COLUMN		41 62	3S8" 3S8"	CUSTOM	T T		29 48	1S-COUNT 1S-COUNT	CUSTOM	EXTERNAL CONDUIT
④	1-A (10')		27 63	3S12" 3S12"	TV-2-T	T T					
⑤	SIGNAL POLE W/ 15' MA & 12' LA		ø4 44	3S12" 3S12"	SV-1-T MAS	ANGLE ANGLE	VERT LOUVER FOR 44				BACKPLATE BACKPLATE
⑥	1-A (10')		ø4	3S12"	TV-1-T	T		68	1S-COUNT	SP-1	BACKPLATE
⑦	1-A (10')		ø4	3S12"	TV-1-T	T		69 28B	1S-COUNT 1S-COUNT	SP-1 SP-1	
⑧	1-A (10')		32 61	3S12"LA 3S8"	TV-2-T	T T		28A 49	1S-COUNT 1S-COUNT	SP-2-T	61 RED BALL IS 12"
⑨	FREEWAY COLUMN		33	3S12"LA	SV-1 (CUSTOM)	T					EXTERNAL CONDUIT
⑩	FREEWAY SUPERSTRUCTURE		84	3S8"	MAT	T					84 RED BALL IS 12" EXTERNAL CONDUIT
⑪	FREEWAY COLUMN		22 81	3S8" 3S8"	CUSTOM	T T		29A 29B 88	1S-COUNT 1S-COUNT 1S-COUNT	CUSTOM	
⑫	1-A (10')		23 67	3S12" 3S12"	TV-2-T	T T					

TABLE OF REVISIONS				
NO.	DATE	DESCRIPTION	BY	APP.
1	6/13/16	ADD 66. UPGRADE 21 & 67 TO 12-INCH. SRC 15-368	DYeung	CDelton
0	3/27/15	NEW SID. PER FIELD CHECK AND CALTRANS AS-BUILTS	DYeung	MVelasco

CHECK WITH TRACING TO SEE IF YOU HAVE LATEST REVISION

REFERENCE INFORMATION & FILE NO. OF SURVEYS	



SAN FRANCISCO MUNICIPAL TRANSPORTATION AGENCY
CITY AND COUNTY OF SAN FRANCISCO

DRAWN:	DATE:
DYeung	10/2015
CHECKED:	DATE:
MVelasco	10/2015

SCALE:
CUSTOM - AS SHOWN
SHEET OF SHEETS
1 OF 1

TRAFFIC SIGNAL INVENTORY DIAGRAM	
13TH STREET AND SOUTH VAN NESS AVENUE	

CNN NO.
24241000
REV NO.
1