


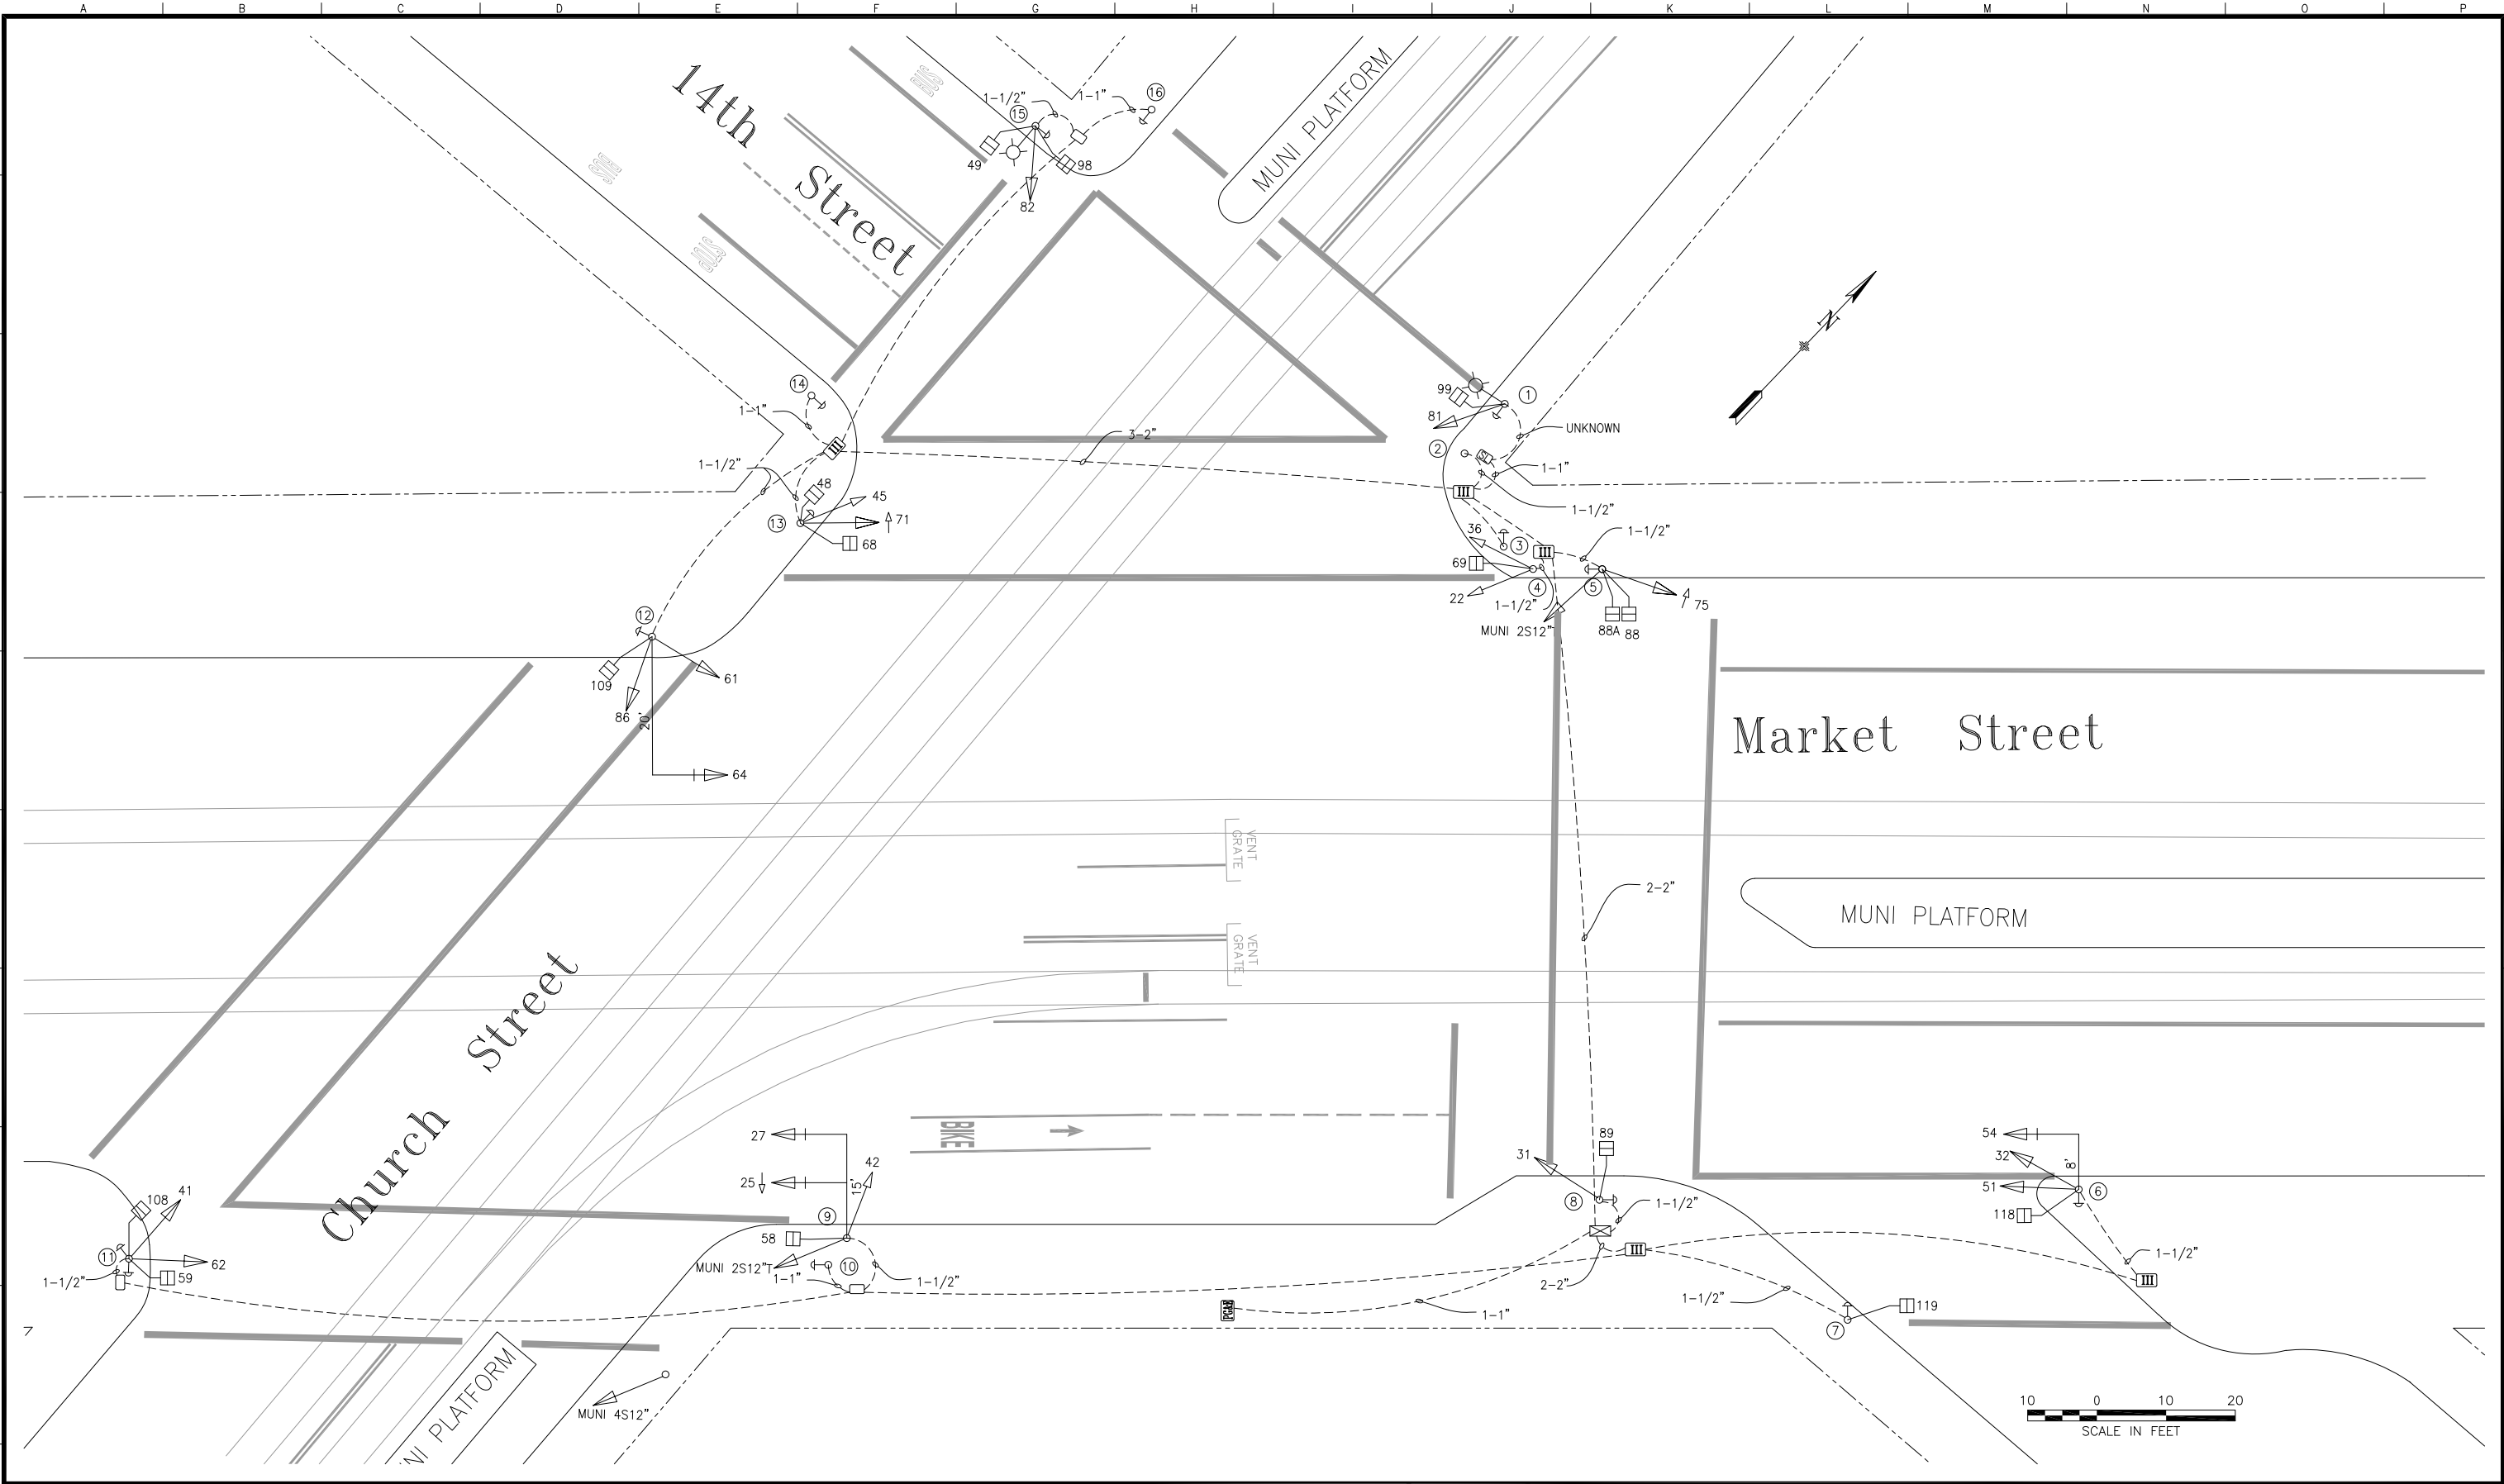

NO.	DATE	DESCRIPTION	BY	APP.
3	9/2/20	MODIFIED SIGNAL 25 TO 4S12" (RRA) PER SRC 2020-256	DLA	MV
2	2/5/14	RELOCATED PED SIGNAL & NEW 12" VEH HEADS DUE TO BULB UPDATES PER FIELD CHECK	KK	CMH
1	2/8/12	OPEN CHURCH NORTH XWALK AND ADD RT SIGNAL	CXL	CL

TABLE OF REVISIONS
CHECK WITH TRACING TO SEE IF YOU HAVE LATEST REVISION

REFERENCE INFORMATION & FILE NO. OF SURVEYS
--



SAN FRANCISCO MUNICIPAL TRANSPORTATION AGENCY
CITY AND COUNTY OF SAN FRANCISCO

CXL	2/2012
DRAWN:	DATE:
CXL	2/2012
CHECKED:	DATE:
CL	2/2012

SCALE:
AS SHOWN
SHEET OF SHEETS
1 OF 2

TRAFFIC SIGNAL INVENTORY DIAGRAM
14TH, Church & Market Streets

CNN NO.
25882000
REV NO.
3

